OLD SOUTHWEST AREA WATERLINE REPLACEMENTS - PHASE I

SITUATED IN

THE CITY OF ROANOKE, VIRGINIA

DATE: OCTOBER 2, 2014

PREPARED FOR

WESTERN VIRGINIA WATER AUTHORITY

NOTIC

All Landowners, Developers and Contractors

FAILURE TO COMPLY WITH THE CITY OF ROANOKE CONSTRUCTION PROCEDURE
REQUIREMENTS LISTED BELOW MAY RESULT IN THE COSTLY REMOVAL OF STRUCTURES,
TIME DELAYS, OR THE ISSUANCE OF A STOP WORK ORDER.

CONSTRUCTION PROCEDURE REQUIREMENTS

1. Right-of-Way Excavation Permit — Prior to the commencement of any digging, alteration or construction within the public right-of-way (streets, alleys, public easements), a right-of-way excavation permit shall be applied for and obtained by the contractor from the City of Roanoke.

2. Location of Utilities — The contractor shall verify the location of all existing utilities prior to the commencement of any construction.

3. Construction Entrance — The contractor shall install an adequate construction entrance for all construction related egress from the site. Size and composition of construction entrance shall be as shown on the plans.


4. Streets to Remain Clean — It shall be the responsibility of the contractor to insure that the public street adjacent to the construction entrance remains free of mud, dirt, dust, and/or any type of construction materials or litter at all times.

5. Barricades/Ditches — The contractor shall maintain the integrity of all excavated ditches and shall furnish and ensure that all barricades proper and necessary for the safety of the public are in place.

6. Sewer and Pavement Replacement — Construction of sanitary sewers and the replacement of pavement shall be in accordance with approved standards and specifications of the City of Roanoke and the Western Virginia Water Authority

7. Approved Plans/Construction Changes — Any change or variation from construction design as shown on the officially approved plans shall be approved by the erosion and sediment control agent prior to said changes or variation in construction being



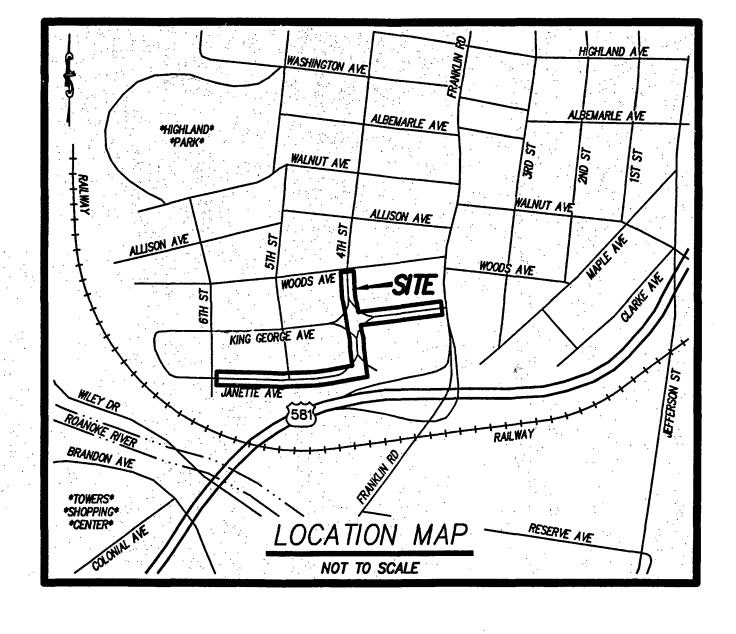

--INDEX OF DRAWINGS--

SHEET No.

DESCRIPTION

1. LUMSDEN ASSOCIATES COVER SHEET

2. NOTES & DETAILS

3. NOTES & DETAILS

4 PLAN & PROFILE JANETTE AVENUE

5.....PLAN & PROFILE 4TH STREET

6....PLAN & PROFILE KING GEORGE AVENUE


7.... WATERLINE DETAILS


8. EROSION & SEDIMENT CONTROL DETAILS




LUMSDEN ASSOCIATES, P.C. ENGINEERS-SURVEYORS-PLANNERS

4664 BRAMBLETON AVENUE, SW P.O. BOX 20669 ROANOKE, VIRGINIA 24018 PHONE: (540) 774-4411 FAX: (540) 772-9445 E-MAIL: MAIL@LUMSDENPC.COM

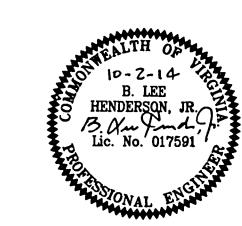

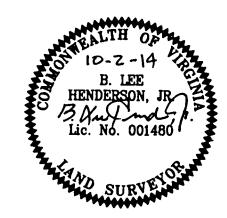

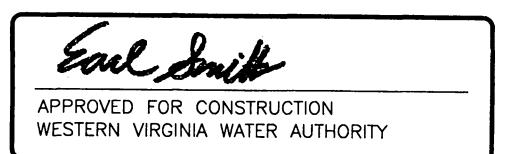

	TEVISIONS			
	DATE		SHEETS	_
				
				_
				
ŀ	COMMISSIO	N NO		
1	COMMISSIO	n NO:	12-1	Я
į	OUTE	Pillinenger Tr	-	-
	SHEE		OF	(
	325227 STA	a grade of the		-

As-Built 7.2.15 Substantial Completion