



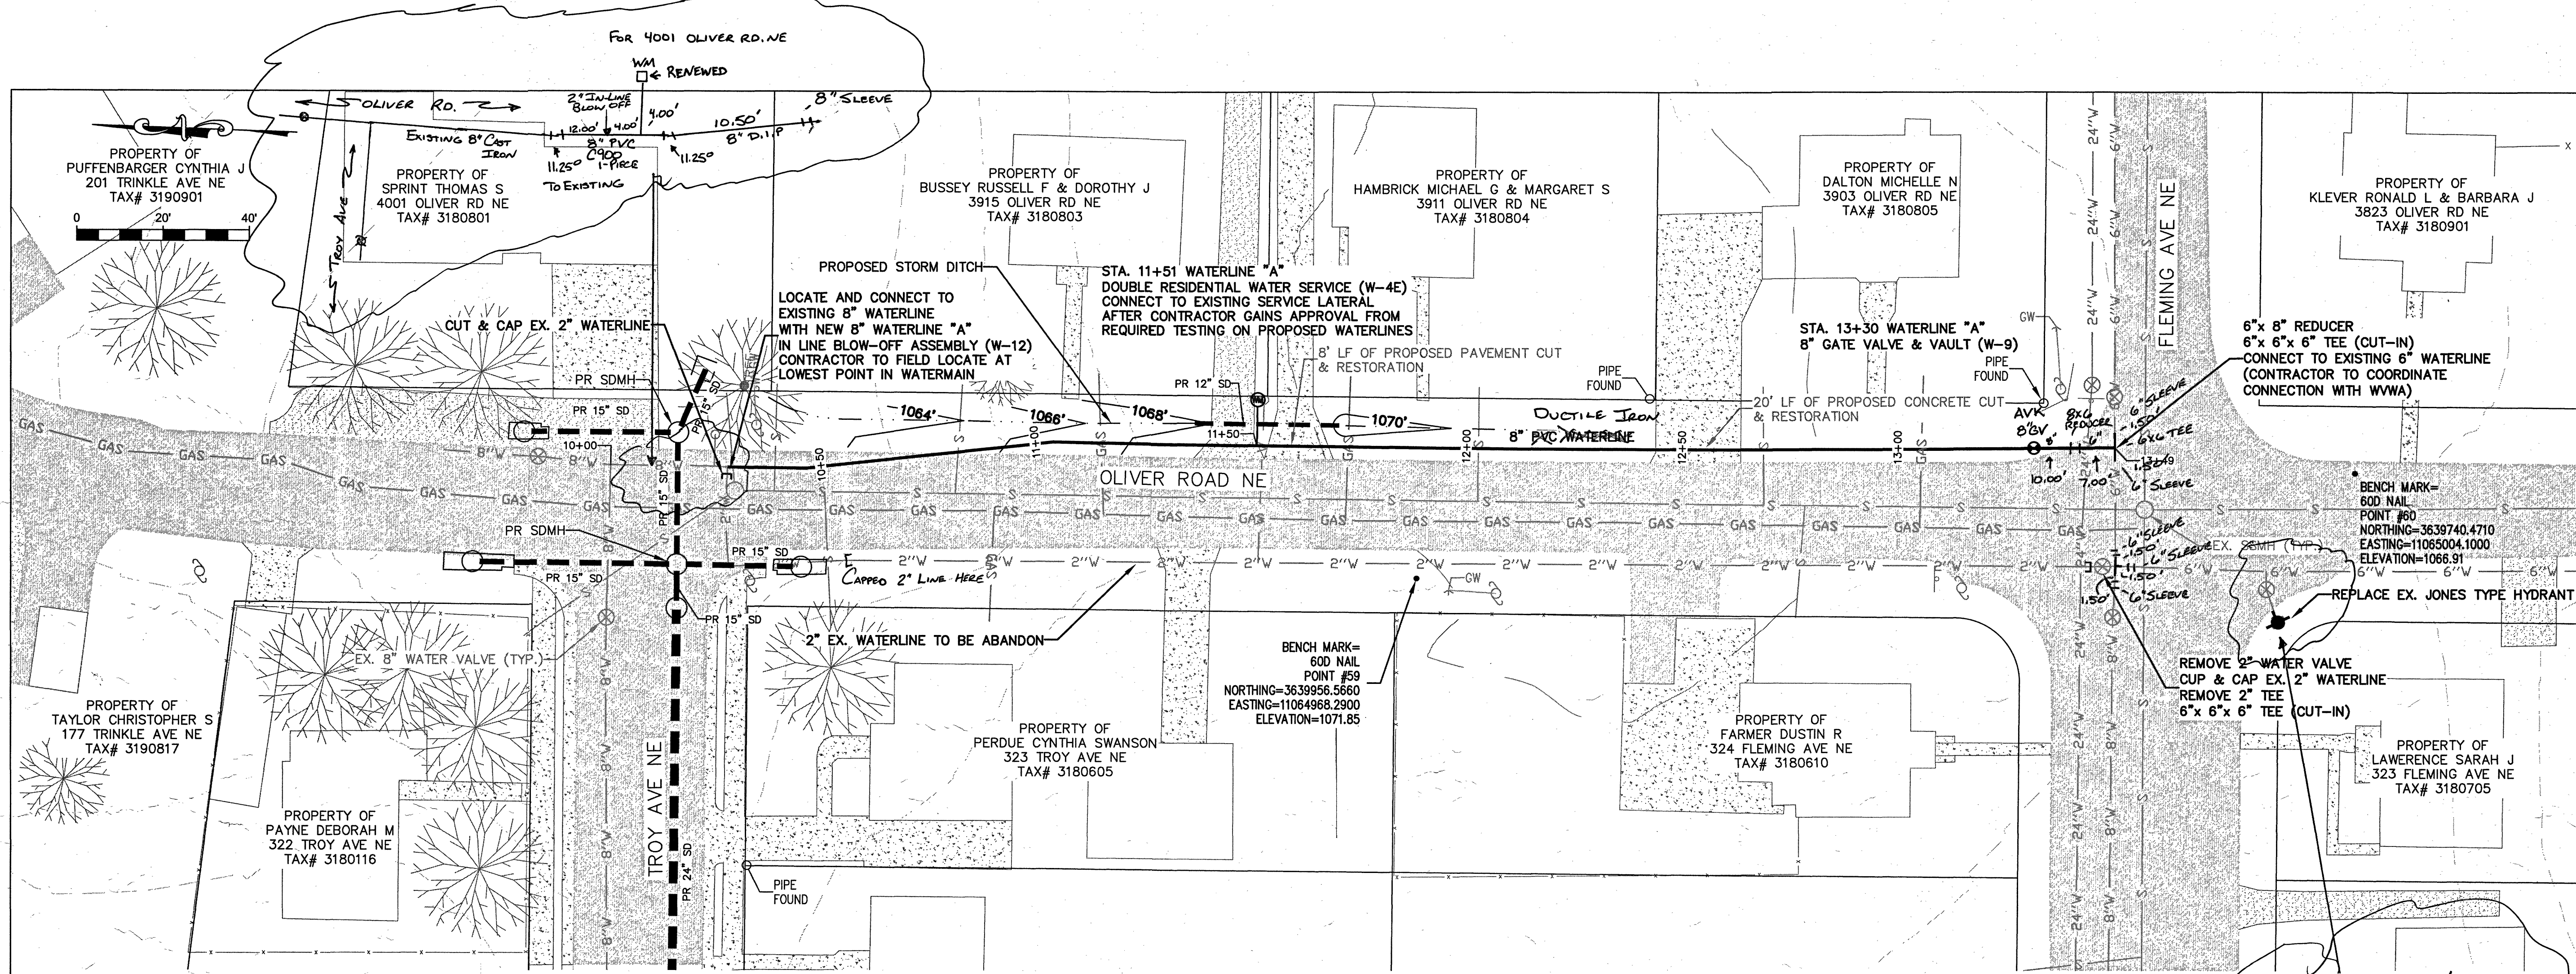

- NOTES:
- 2" WATERLINE TO BE CAPPED AND ANY PORTION OF 2" WATERLINE IN THE WAY OF STORM DRAIN / INLET INSTALLATION SHALL BE REMOVED BY ROANOKE CITY CONTRACTOR.
 - CONTRACTOR SHALL FIELD LOCATE BEGINNING OF 8" WATER MAIN NEAR 4001 OLIVER RD. NEW 8" WATER MAIN SHALL CONNECT TO EX. 8" WATER MAIN, IF TEE EXISTS ON 2" WATER MAIN, IT SHALL BE REMOVED.
 - SEWER LATERALS SHOWN ARE BASED ON CCTV FOOTAGE. ADDITIONAL LATERALS & CONFLICTS SHALL BE INVESTIGATED BY CONTRACTOR PRIOR TO EXCAVATION.

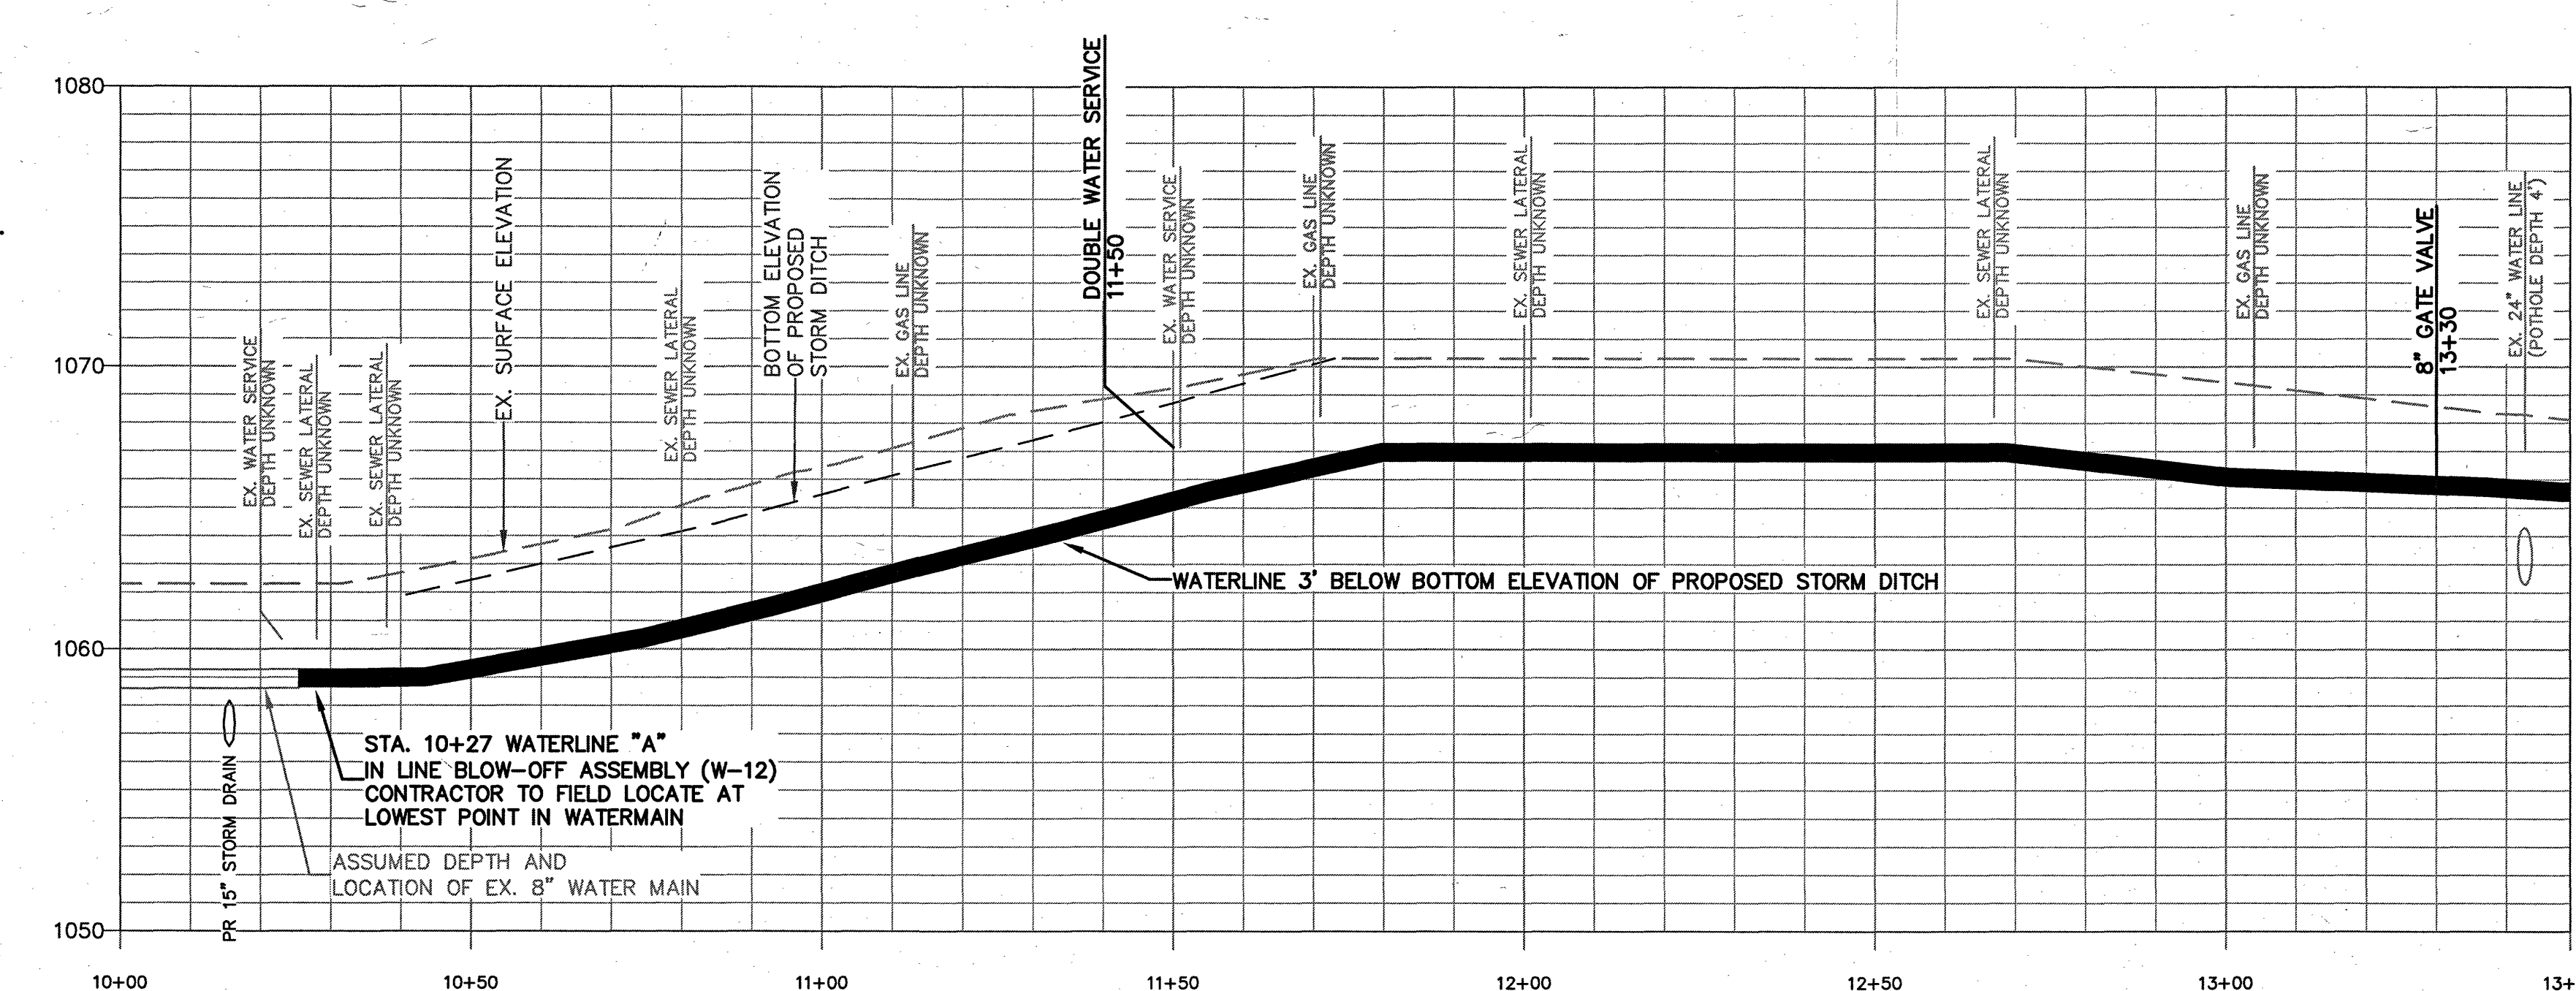

WATERLINE "A"
SCALE
VERTICAL: 1" = 5'
HORIZONTAL: 1" = 20'

- MATERIALS**
- U.S. PIPE 6" x 8" D.I.P. CLASS 350
 - NORTH AMERICAN 8" PVC C900 OR 14" 1-PRCE
 - AVK 8" GATE VALVE
 - AFC 6" GATE VALVE "FIRE HYDRANT ASSEMBLY"
 - AVK 2" GATE VALVE "BLow-OFF"
 - AMERICAN DARLING FIRE HYDRANT
 - CAST 2016 MODEL RB4 R-S
 - ADS POLYFLEX 1" HDPE FOR SERVICES

- TESTING**
- PRESSURE TESTED NEW LINE 02-27-18. 295' OF 8" @ 200 PSI. PASSED
 - WATER SAMPLES TAKEN ON 02-27-18 & 02-28-18. PASSED 03-01-18

Contractor: Jack St. Clair

WESTERN VIRGINIA

WATER AUTHORITY

ENGINEERING SERVICES
601 S JEFFERSON ST, SUITE 300
ROANOKE, VA 24011
540-853-5700

OLIVER ROAD WATERLINE REPLACEMENT

PLAN & PROFILE

Rev	Description	Date	By

Designed: CDA

Drawn: NSS, DRJ

Checked: DRJ

Approved: CDA

Date: JAN 2018

Project: CIP-170

1

Sheet 1 of 1

CHARLES CRUSH
AS-BUILT
03-12-18