


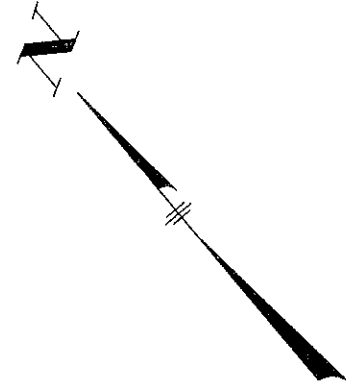


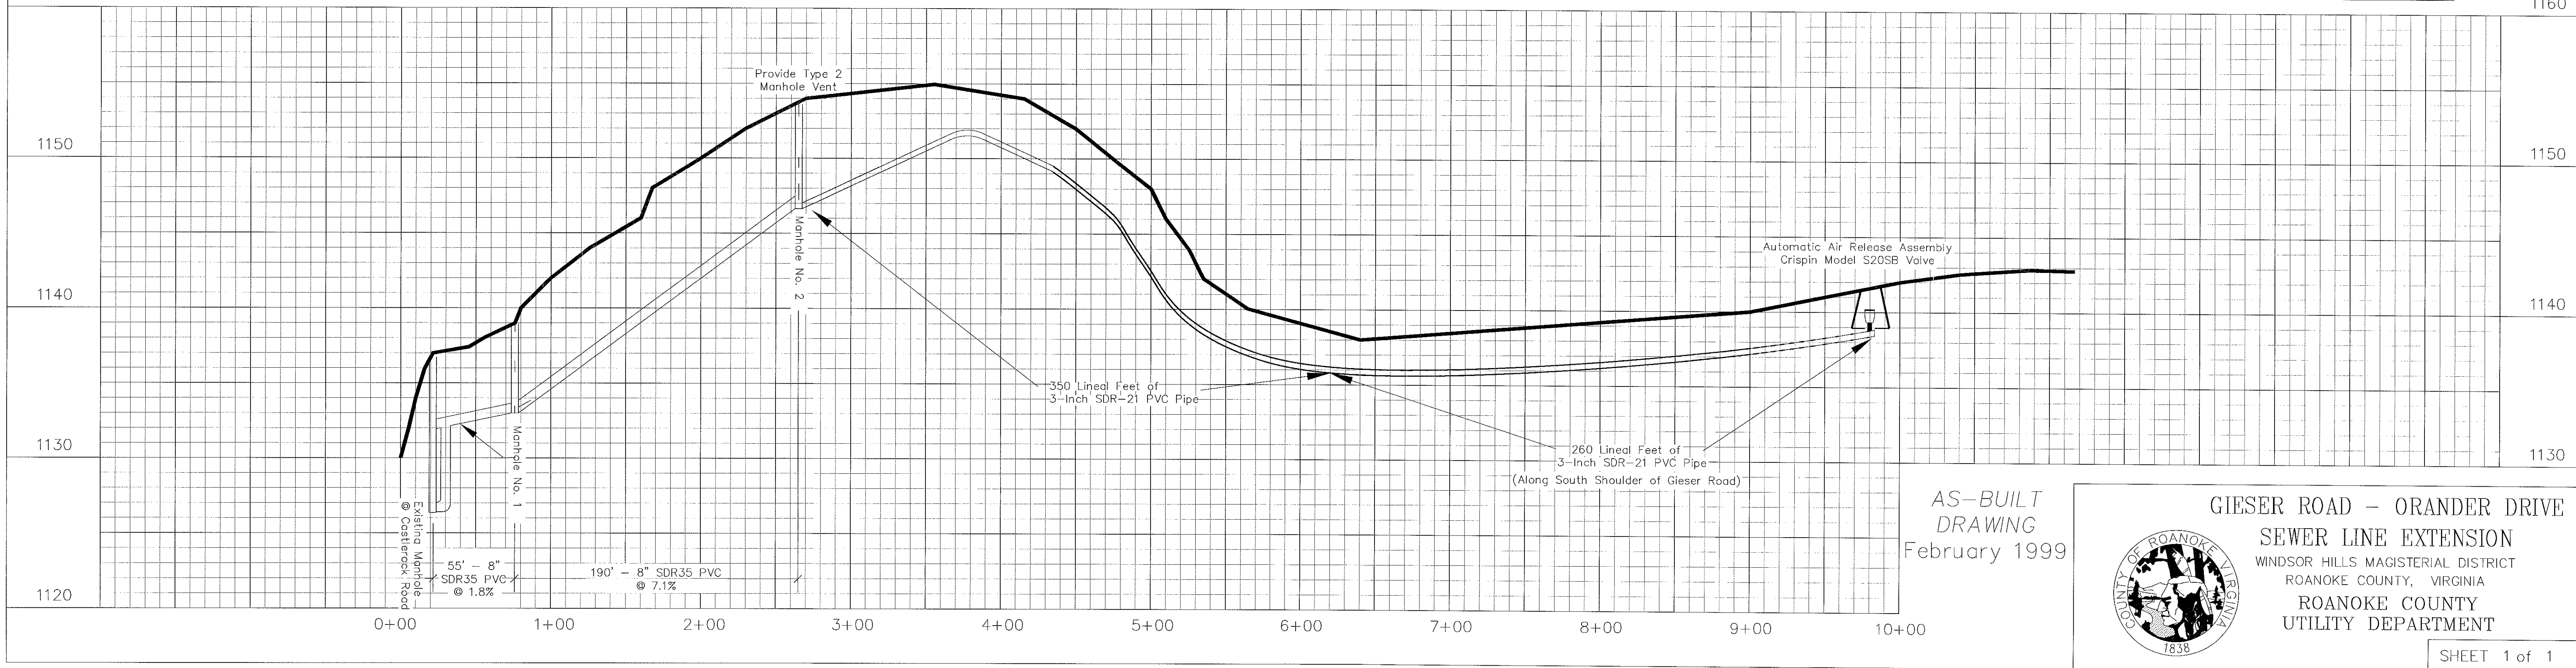

SCALES:
1" = 50' HOR
1" = 5' VER

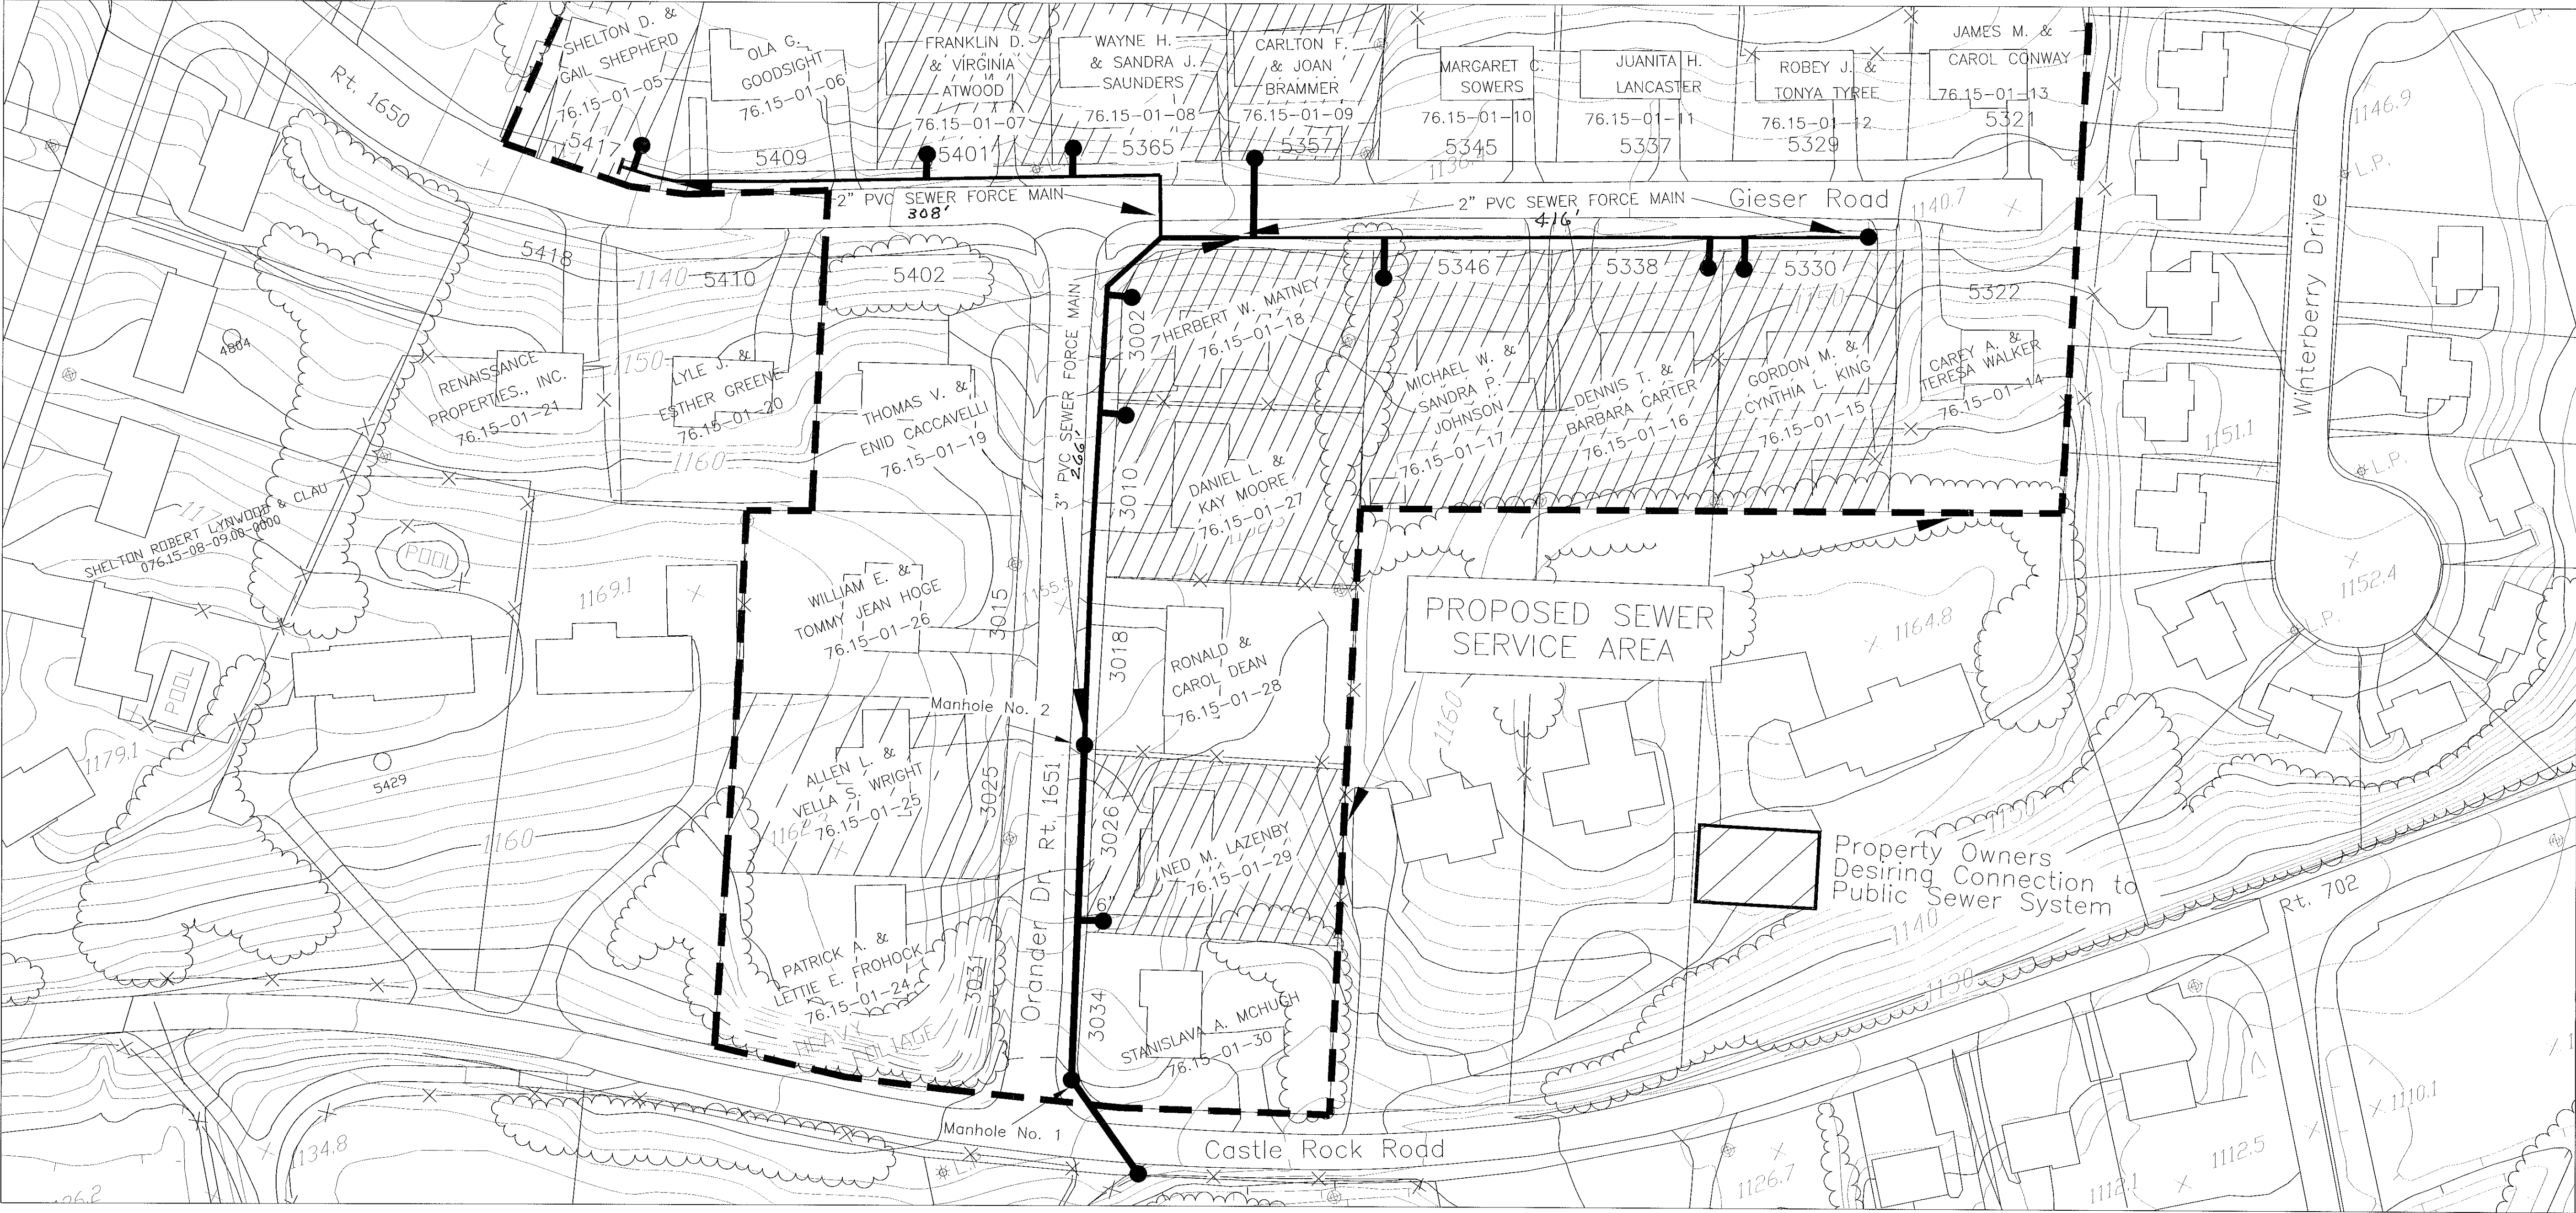

AS-BUILT
DRAWING
February 1999

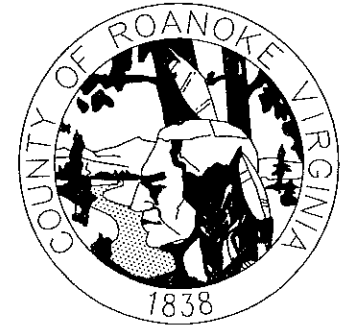

GIESER ROAD - ORANDER DRIVE
SEWER LINE EXTENSION
WINDSOR HILLS MAGISTERIAL DISTRICT
ROANOKE COUNTY, VIRGINIA
ROANOKE COUNTY
UTILITY DEPARTMENT