




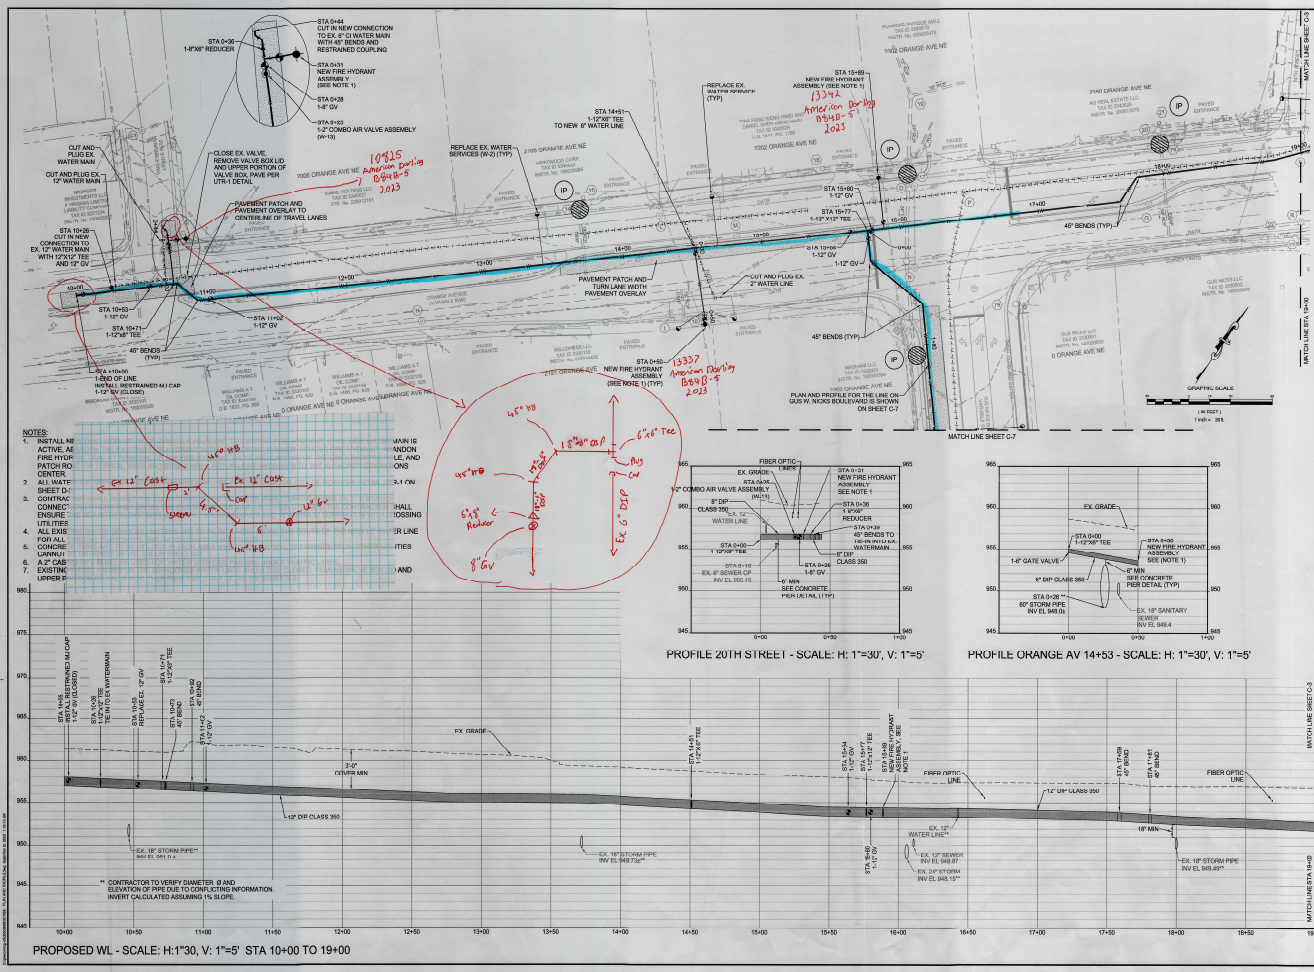

Draper Aden Associates
 Engineering • Surveying • Environmental Services
 2000 South Main Street, Suite A • Richmond, VA 23261
 800-552-0441 • Fax: 800-552-0297
 www.draperaden.com

WATERLINE PLAN AND PROFILE (1 OF 6)
ORANGE AVE & GUS NICKS
WATER MAIN REPLACEMENT

REVISIONS	
NO. 001	INITIALS/REVISION
001	WON
002	YCA / WJ / ASD
003	SP3
004	1-2-07
005	03/09/2007
006	607/666

C-2
 / OF 20