


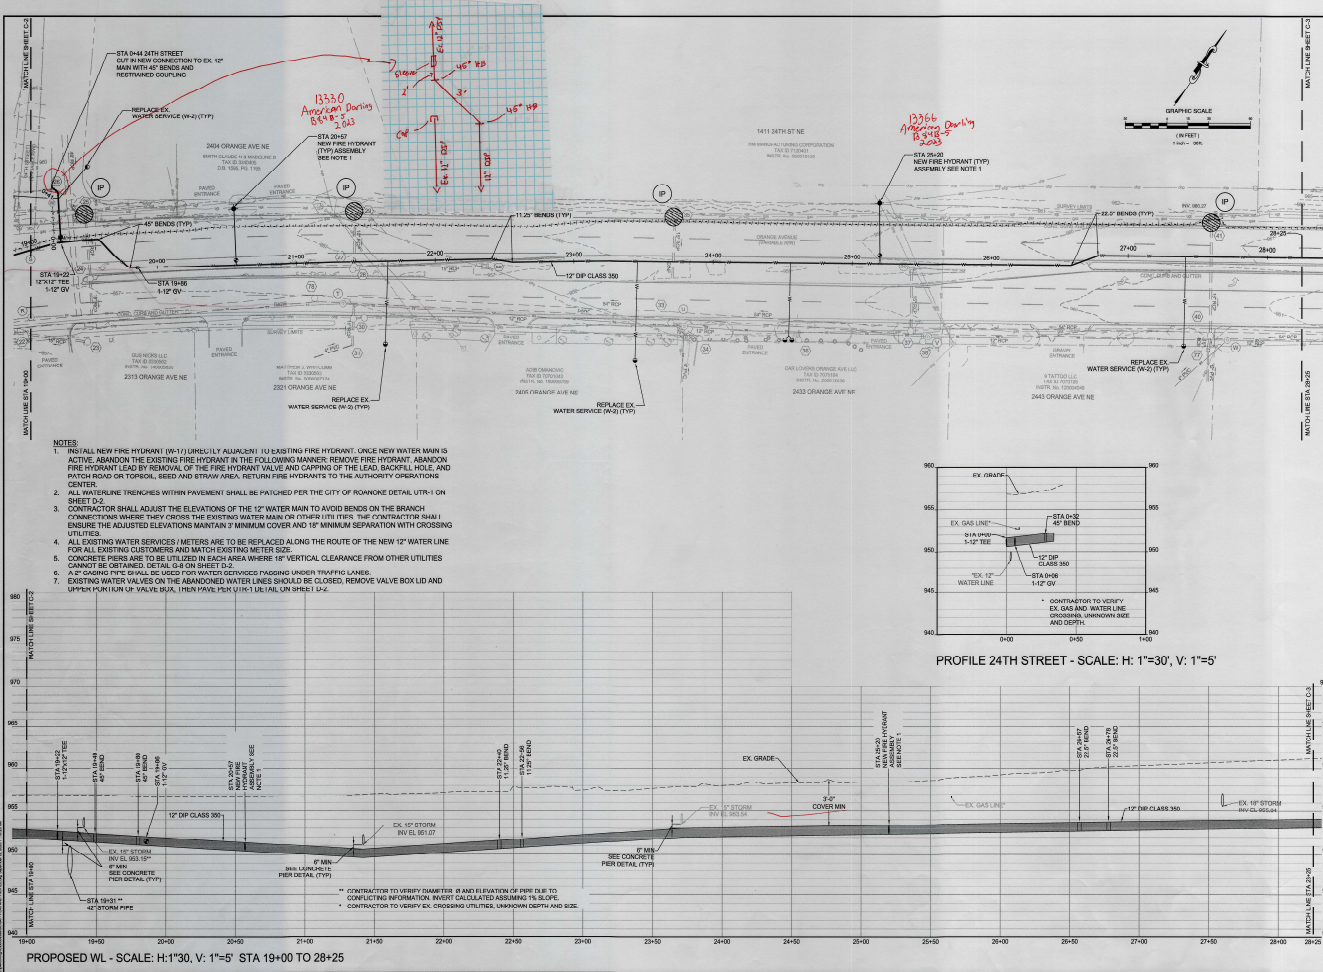

Draper Aden Associates
Engineering • Surveying • Environmental Services
2200 South Main Street, Suite 200
Roanoke, VA 24001
956-550-0000 • Fax: 956-550-0001
www.draperaden.com

WATERLINE PLAN AND PROFILE (2 OF 6)
ORANGE AVE & GUS NICKS
WATER MAIN REPLACEMENT
ROANOKE VIRGINIA

DESIGNED BY: WCH
CHECKED BY: JMA / YMA / ASZ
DESIGNED BY: BRG
SCALE: 1"=30'
DATE: 07/11/2018
PROJECT NUMBER: 507000
C-3
8 OF 20