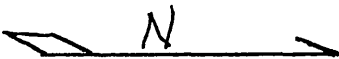


(460 EAST)

[illegible]

CITY OF ROANOKE—WATER DEPT	
VALVE DIAGRAM	
2900 BLOCK OF ORANGE AVE.	
NE	
SEC. MAP. 714	
DATE 7-10-99	PAGE NO.

2900 BLOCK OF ORANGE AVE.

NE

SEC. MAP. 714

DATE 7-10-99

PAGE NO.