



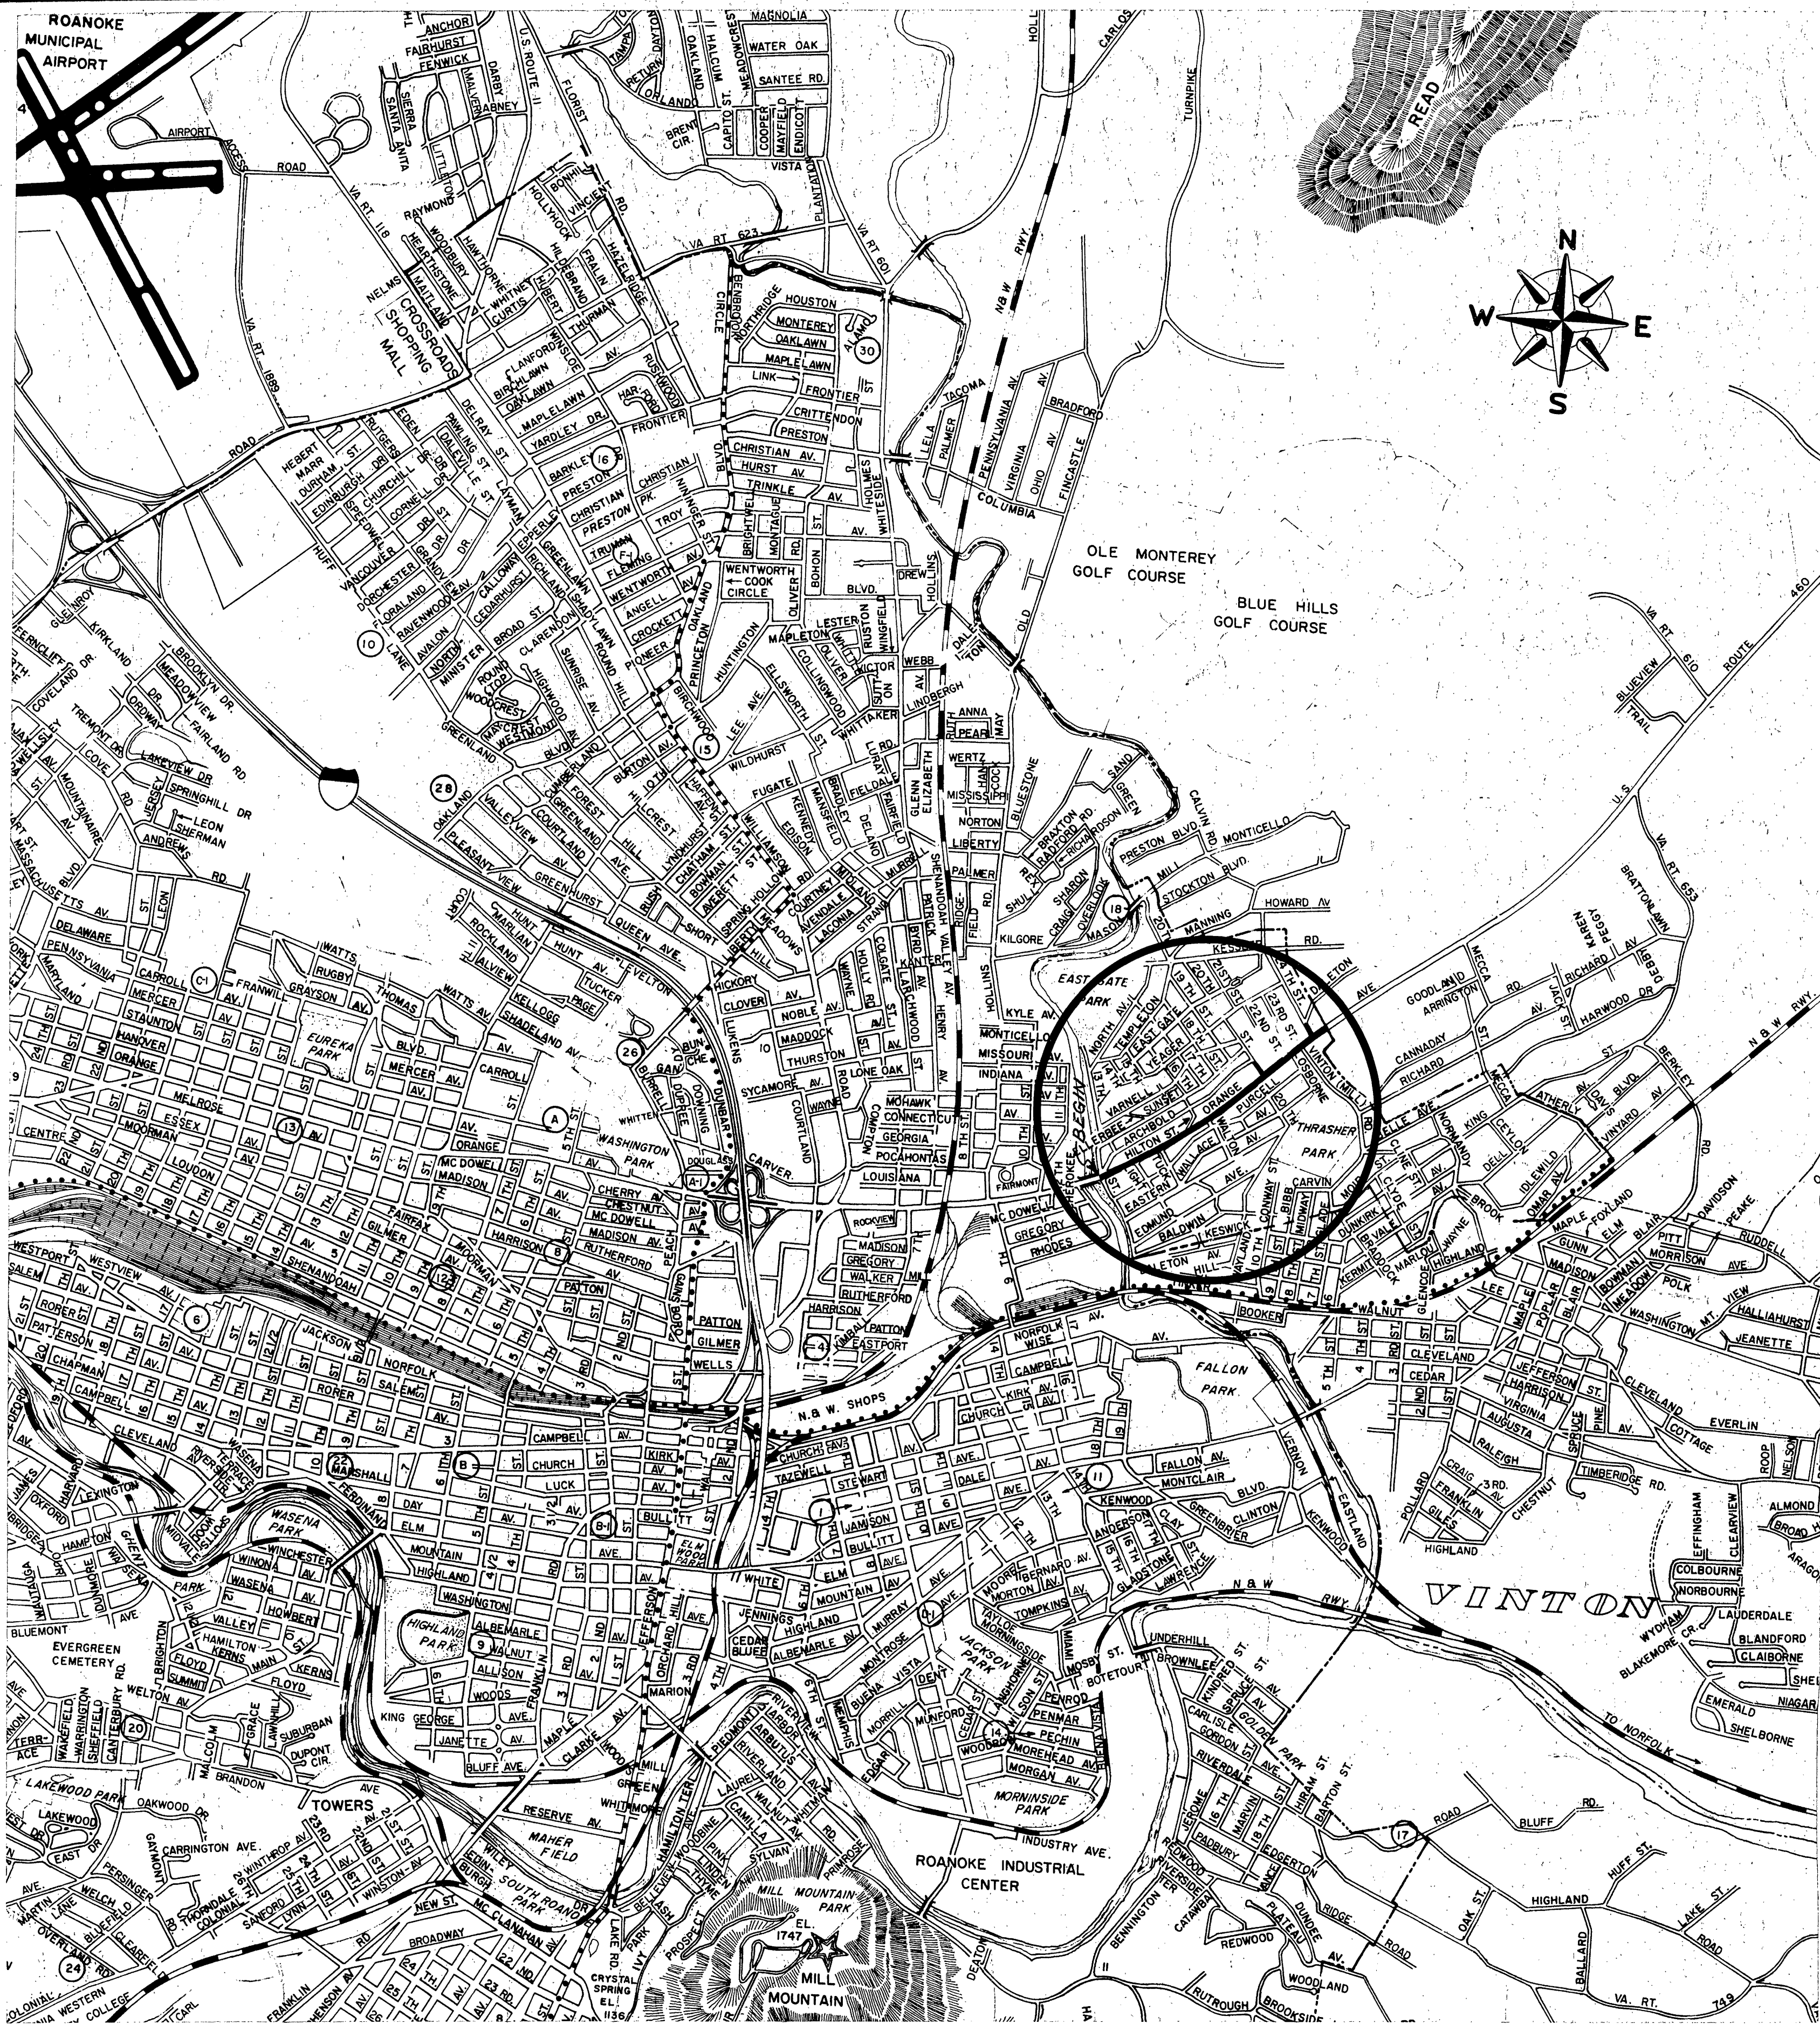

AS BUILT

11-4-68
F.B. 512

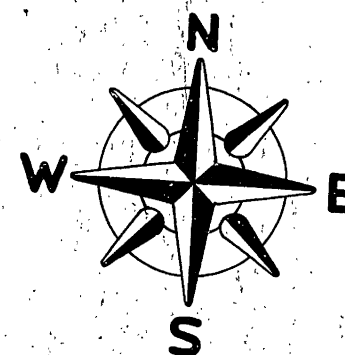

OFFICE OF CITY ENGINEER
ROANOKE, VIRGINIA

PROPOSED
SANITARY SEWER SYSTEM
ON
ORANGE AVENUE, N.E.
FROM TINKER CREEK
TO THE EAST CORPORATION LINE

DATE: MARCH 1968

SCALE: 1"=1600'

APPROVED William F. Clark
CITY ENGINEER

APPROVED H. Clifton Broyles
DIRECTOR OF PUBLIC WORKS

PLAN No. 5025