


PLAN	DATE
SURVEYED	BY
NOTE BOOK	ALIGNED CHECKED
NO. 452	RT. OF WAY CHECKED

PROFILE	DATE
SURVEYED	BY
NOTE BOOK	GRADES CHECKED
NO. 452	B. M. NOTED
	STRUCTURE NOTATIONS CHECKED

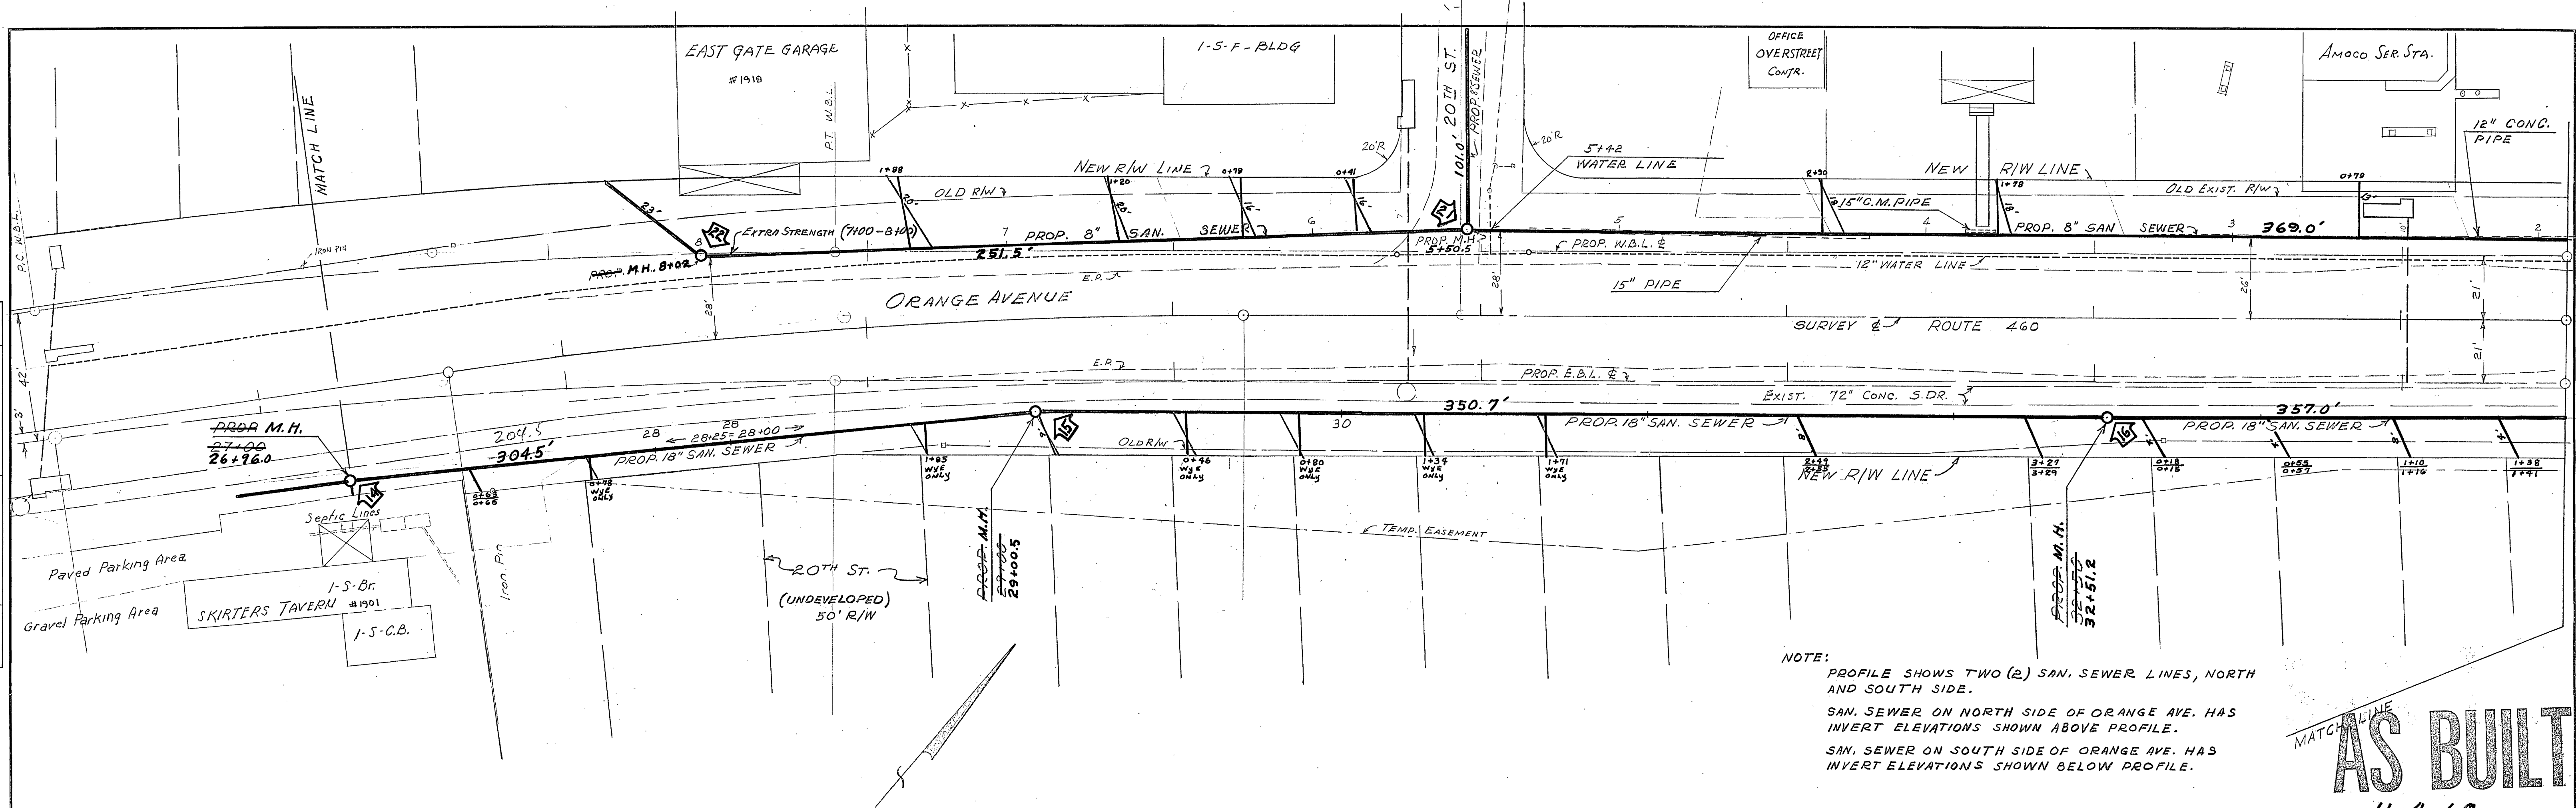

AS BUILT
11-4-68
F.B. 512

