


PLAN	SURVEYED	BY	DATE
	NOTE BOOK	GRADES CHECKED	ALIGNMENT CHECKED
	NO.	RT. OF WAY CHECKED	

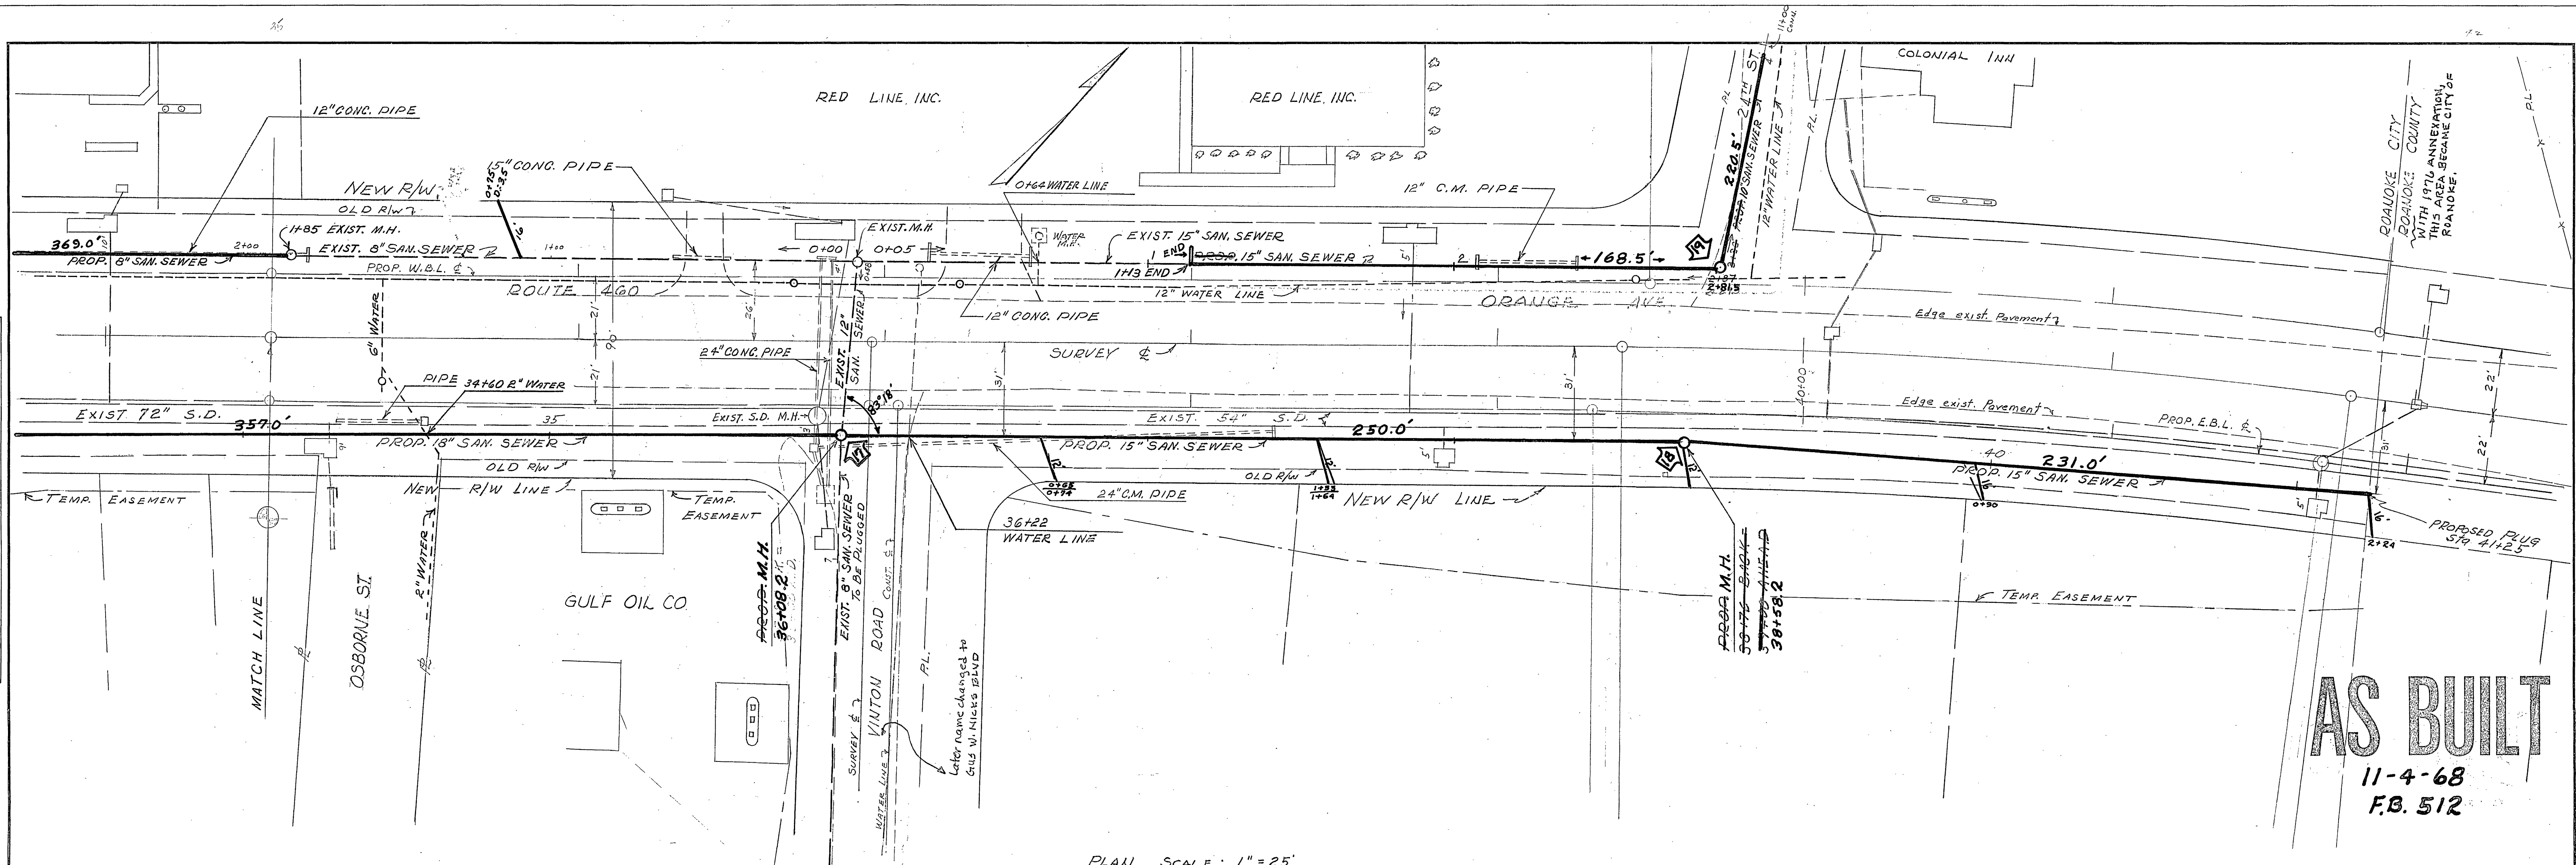

AS BUILT
11-4-68
F.B. 512

PROFILE	SURVEYED	BY	DATE
	NOTE BOOK	GRADES CHECKED	ALIGNMENT CHECKED
	NO.	RT. OF WAY CHECKED	

