



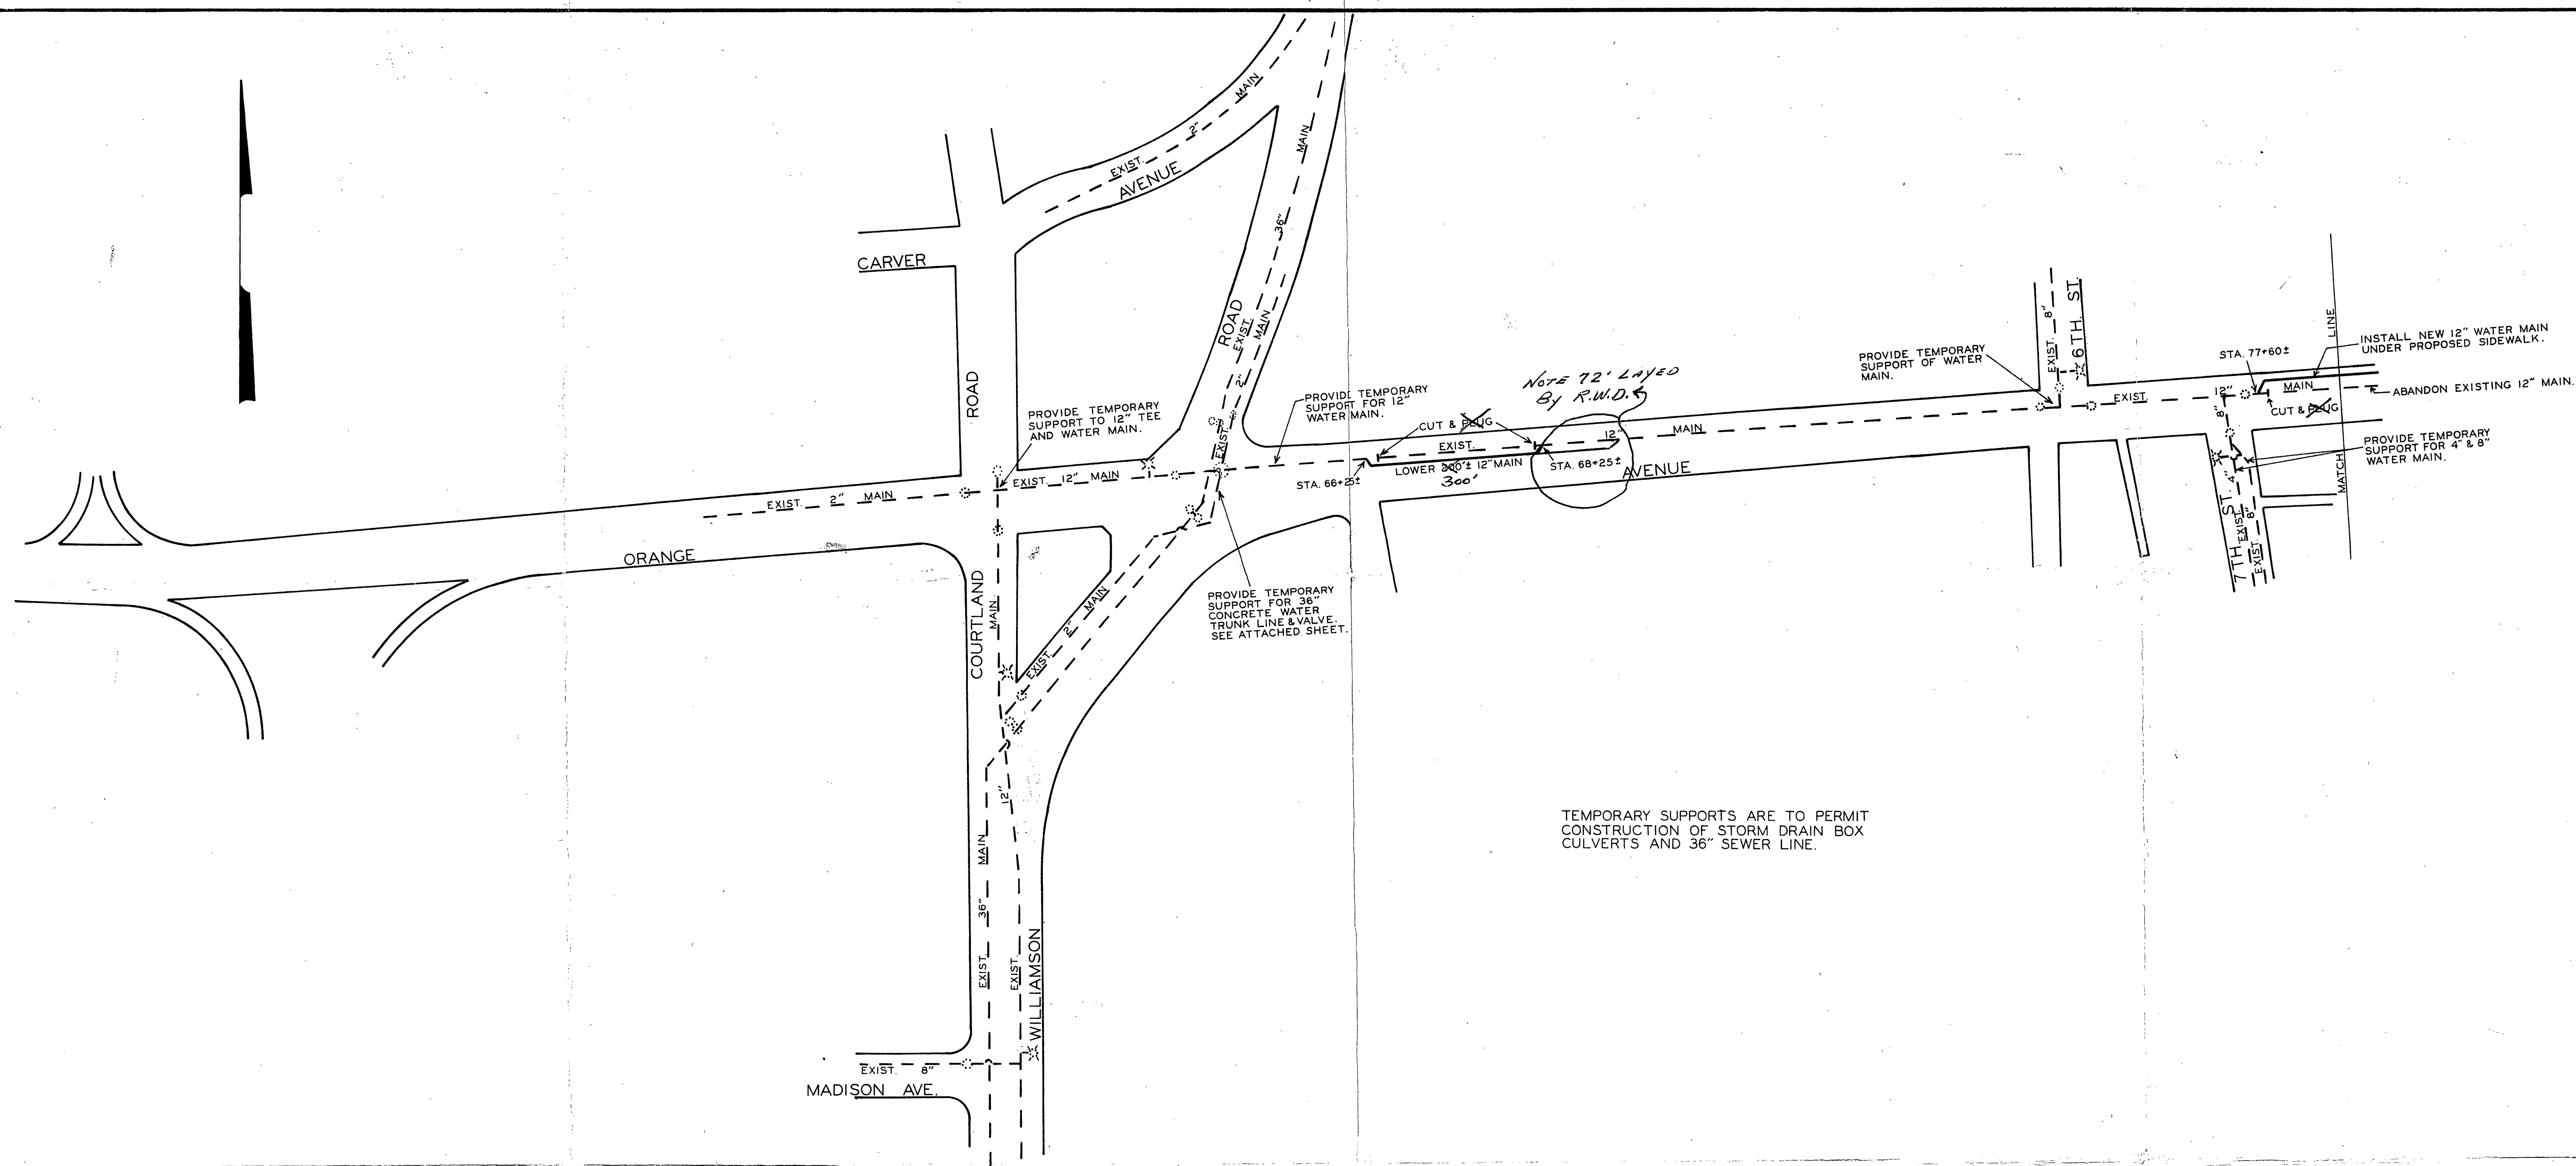

TEMPORARY SUPPORTS ARE TO PERMIT
CONSTRUCTION OF STORM DRAIN BOX
CULVERTS AND 36" SEWER LINE.

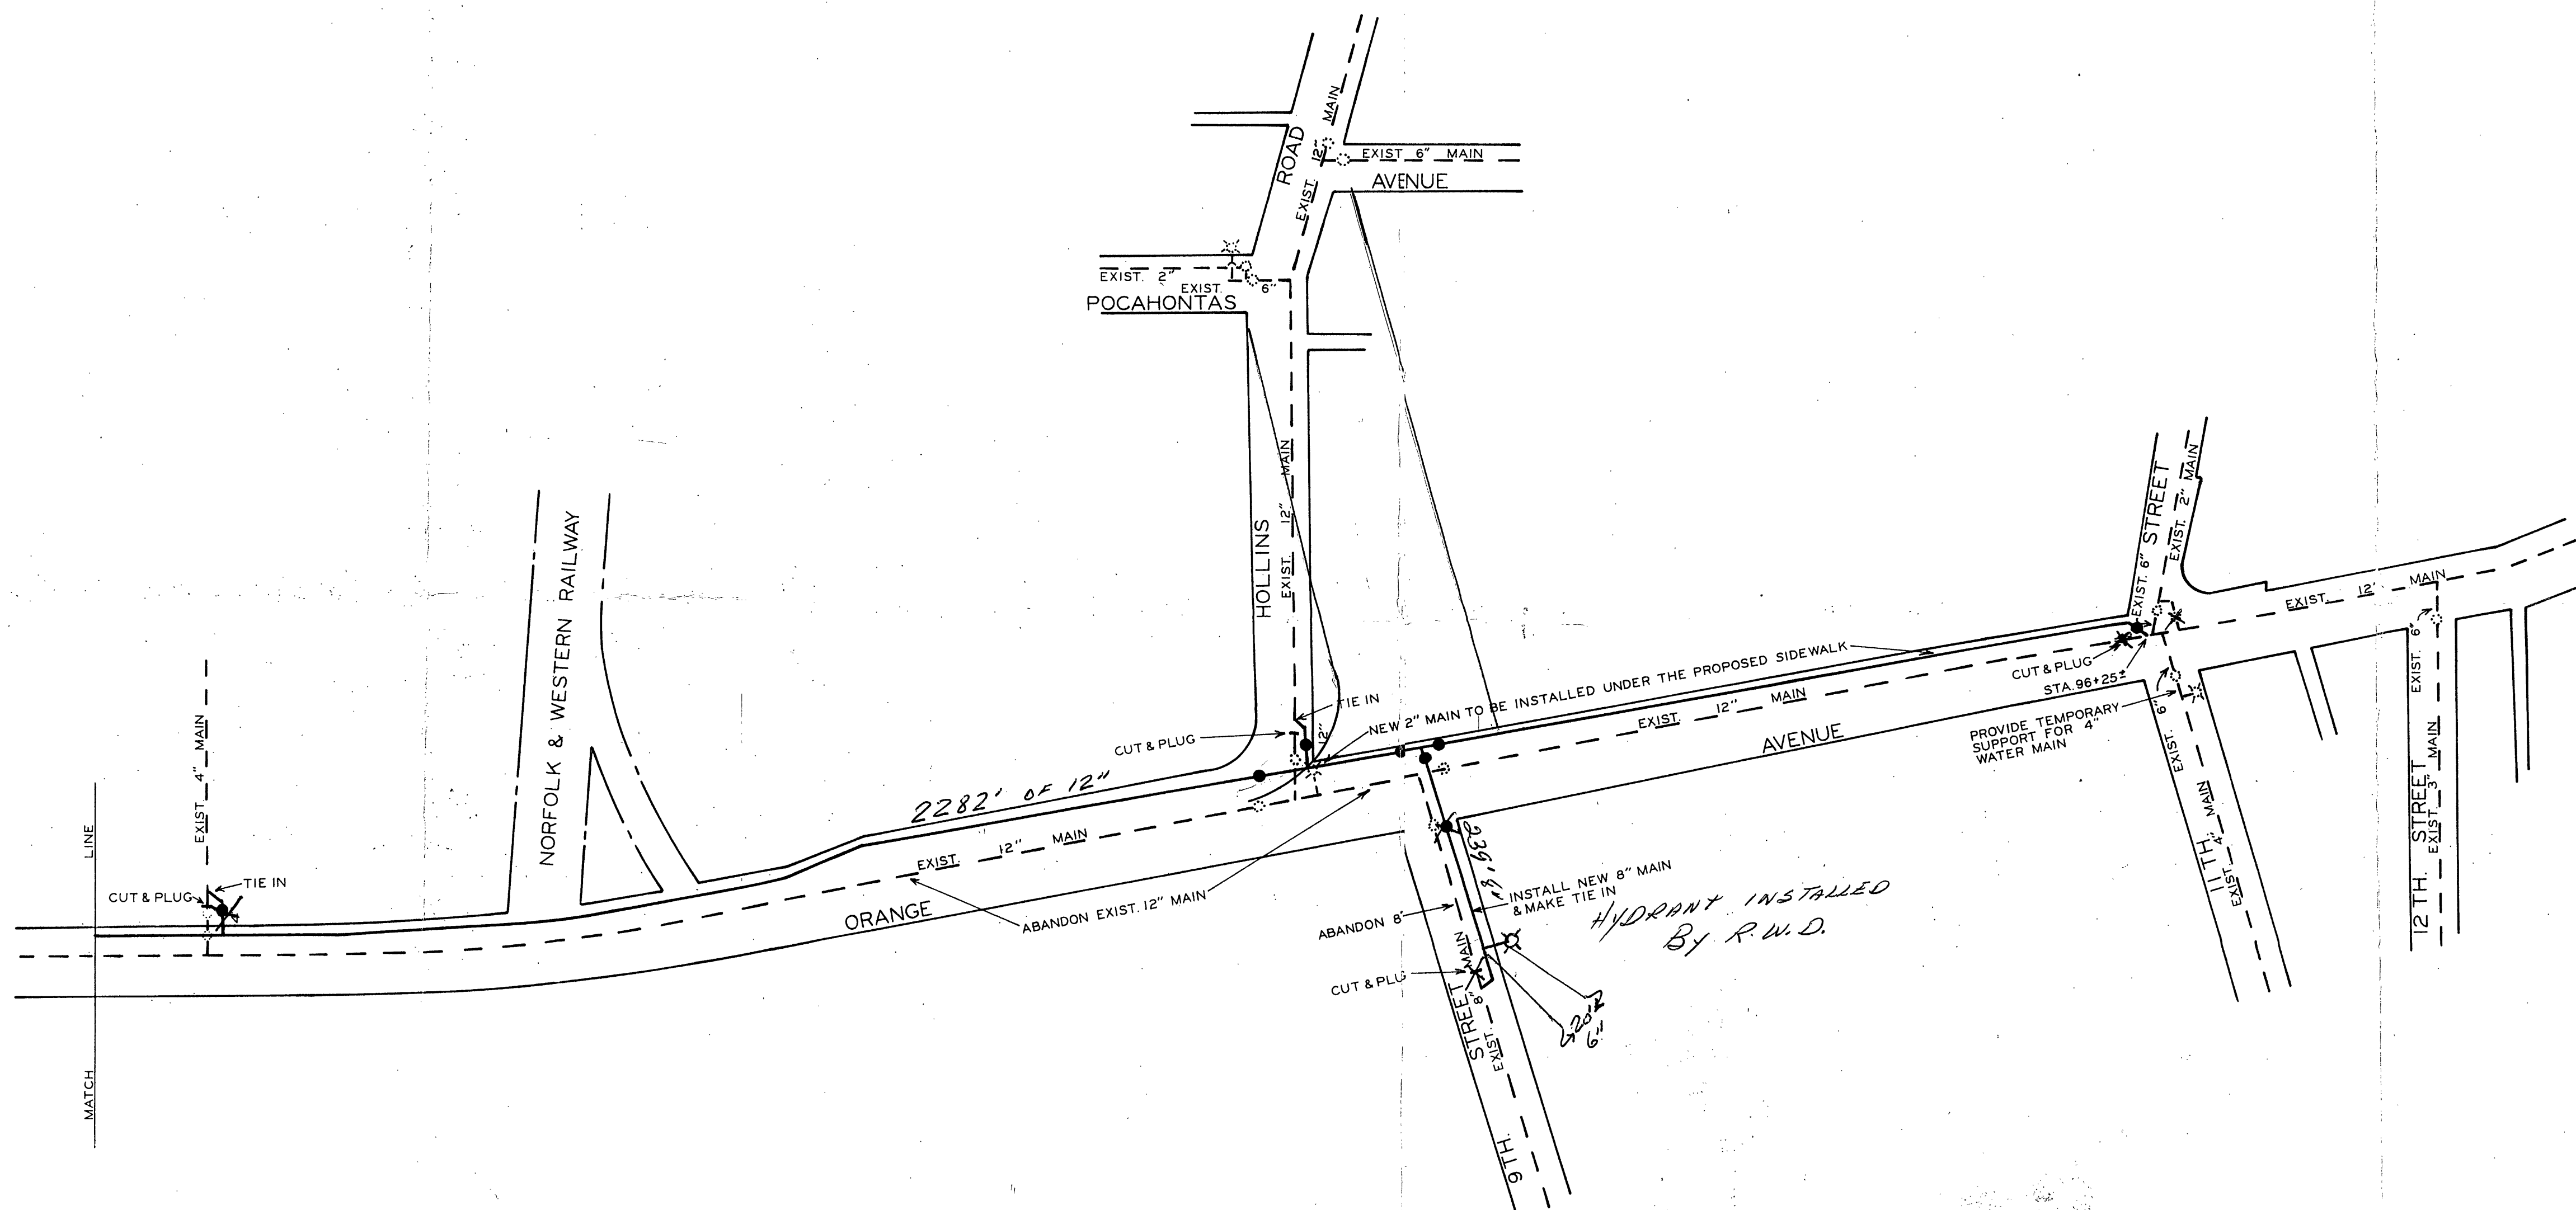

DATE STARTED	Nov 12 1971			
DATE COMP.	Sept 11 1972			
FEET MAIN	SIZE	VALVE	VAULT	BOX
2282'	12"	5	5	
239'	8"	1	1	
31'	4"			
F. H. COMP.				
F. H. STUB ONLY	20'	6"	1	1
SERV. INS. BY:				
MAINS INS. BY:	HARRIS Mech. Cont.			
NO. ¾" SERV. INS.				
CITY OR CO.	Roanoke City			
DEPT. INSP.	FAGONS			

WATER DEPARTMENT
CITY OF ROANOKE, VA.
ORANGE AVENUE N.E.
RELOCATION OF MAIN
SCALE - 1"=100'
DRAWN BY C.A.H. MAY 14, 1969