
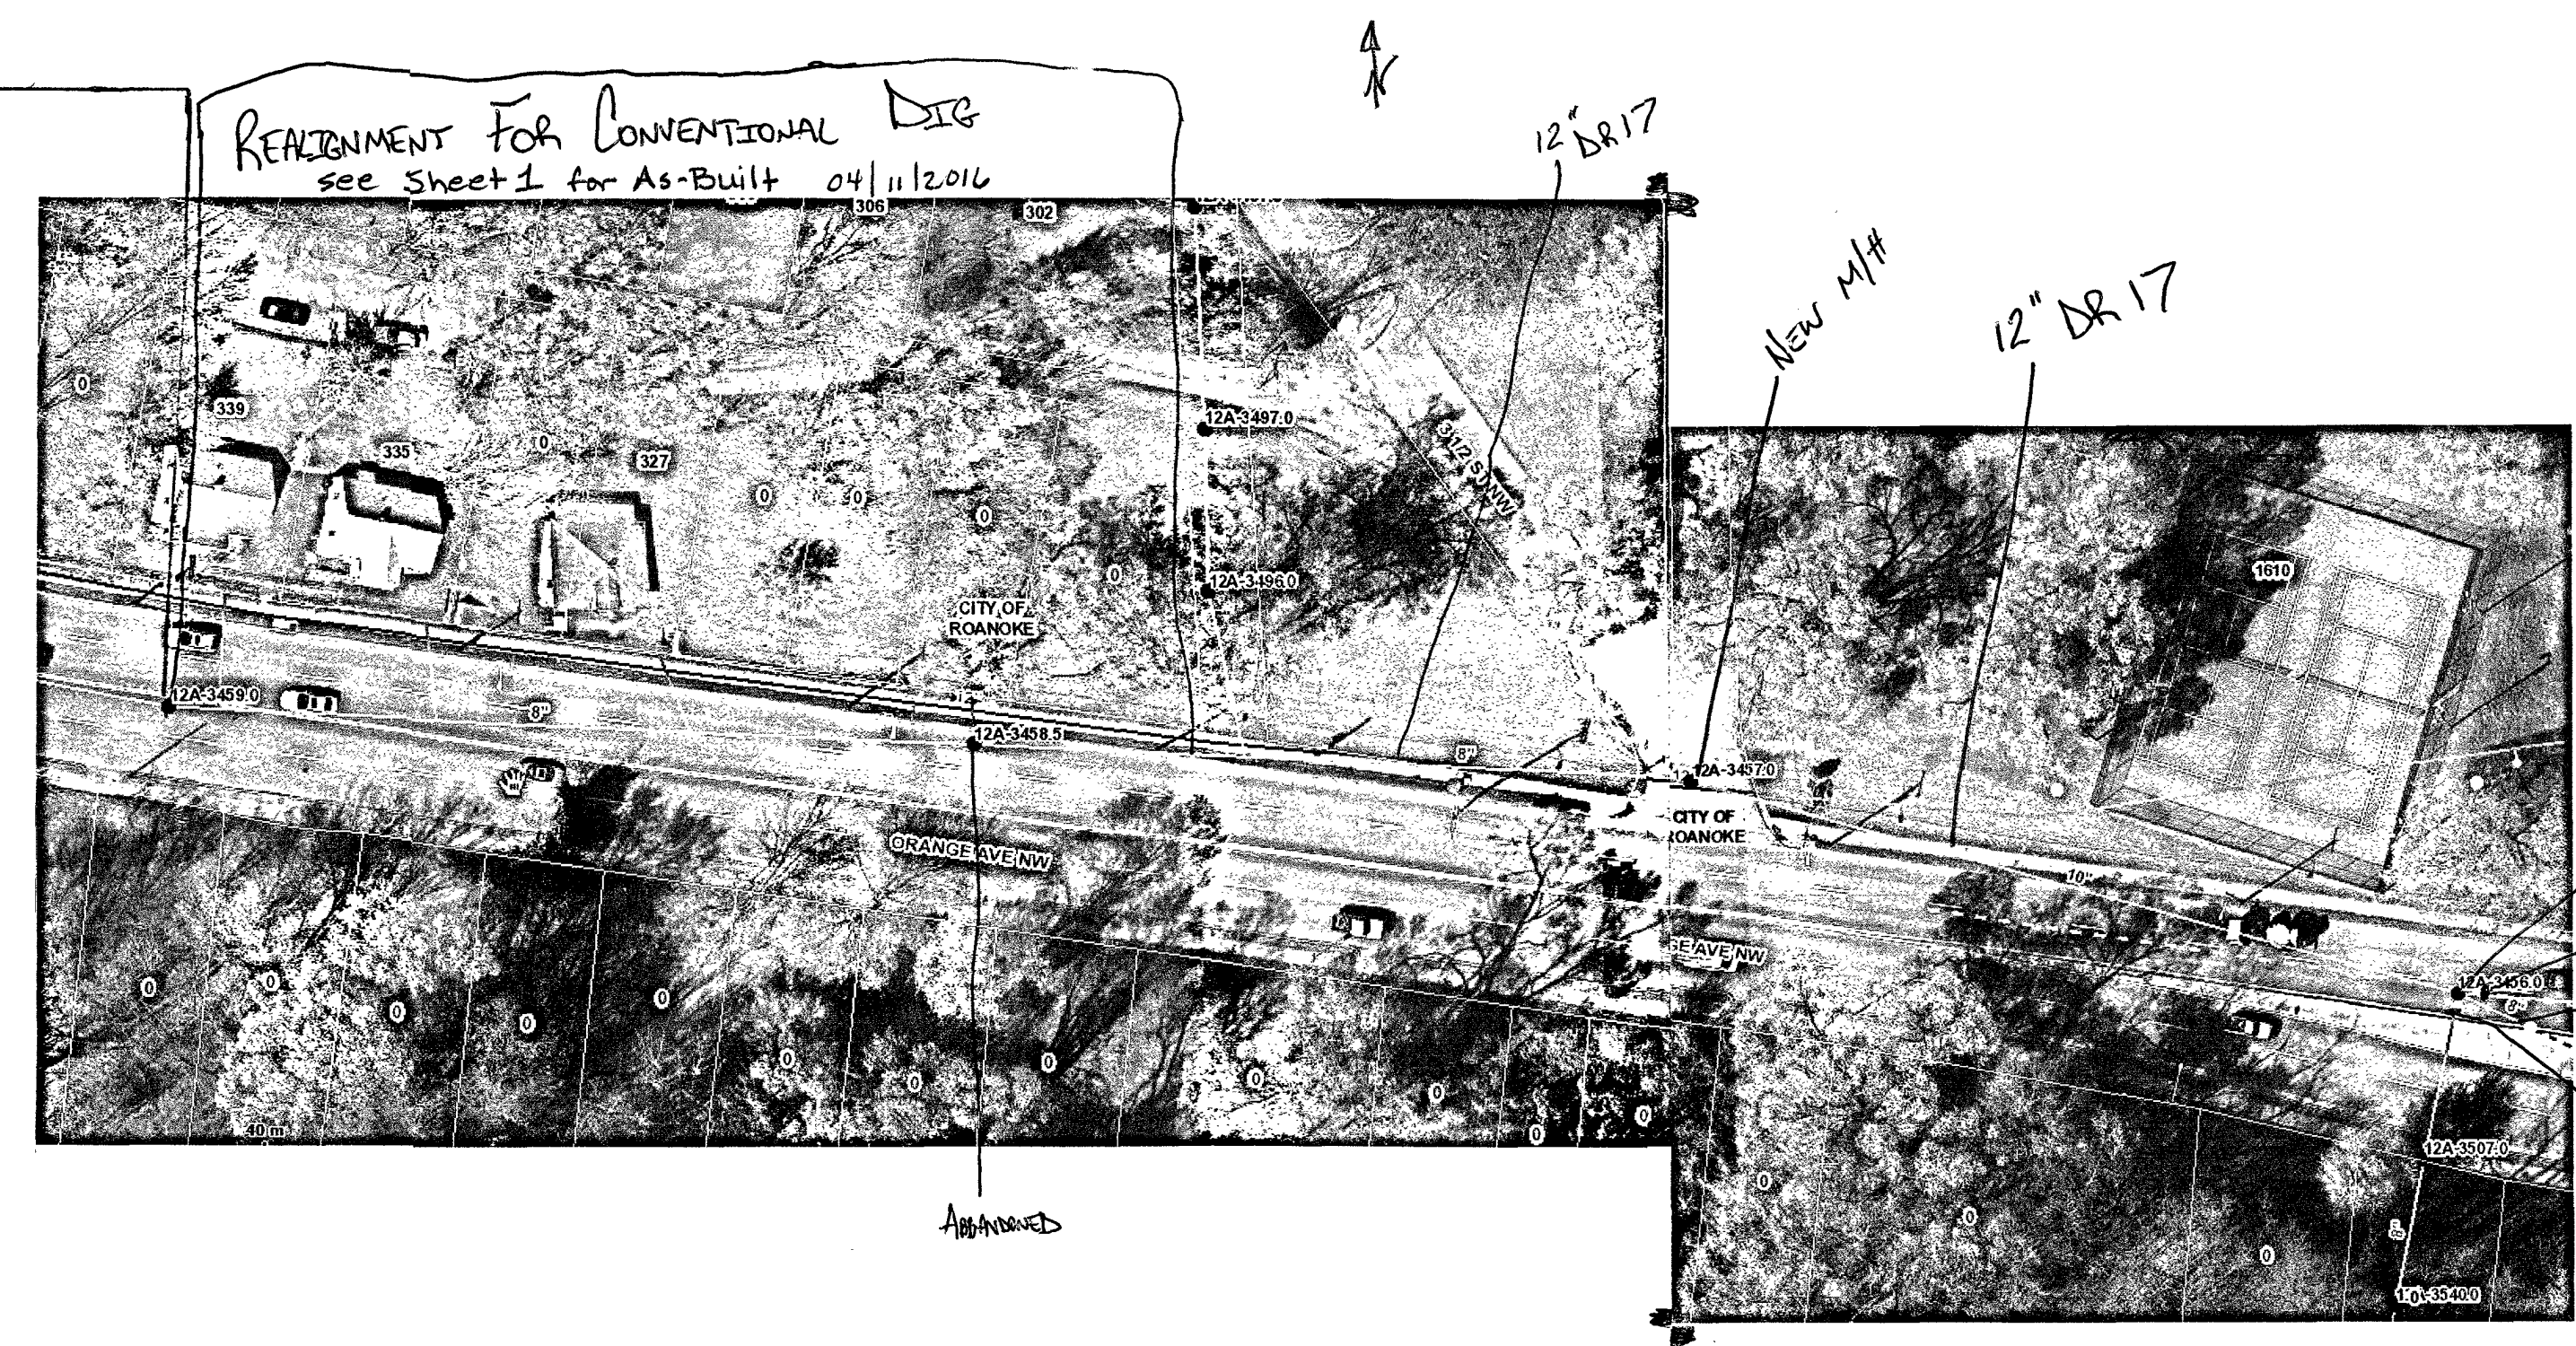


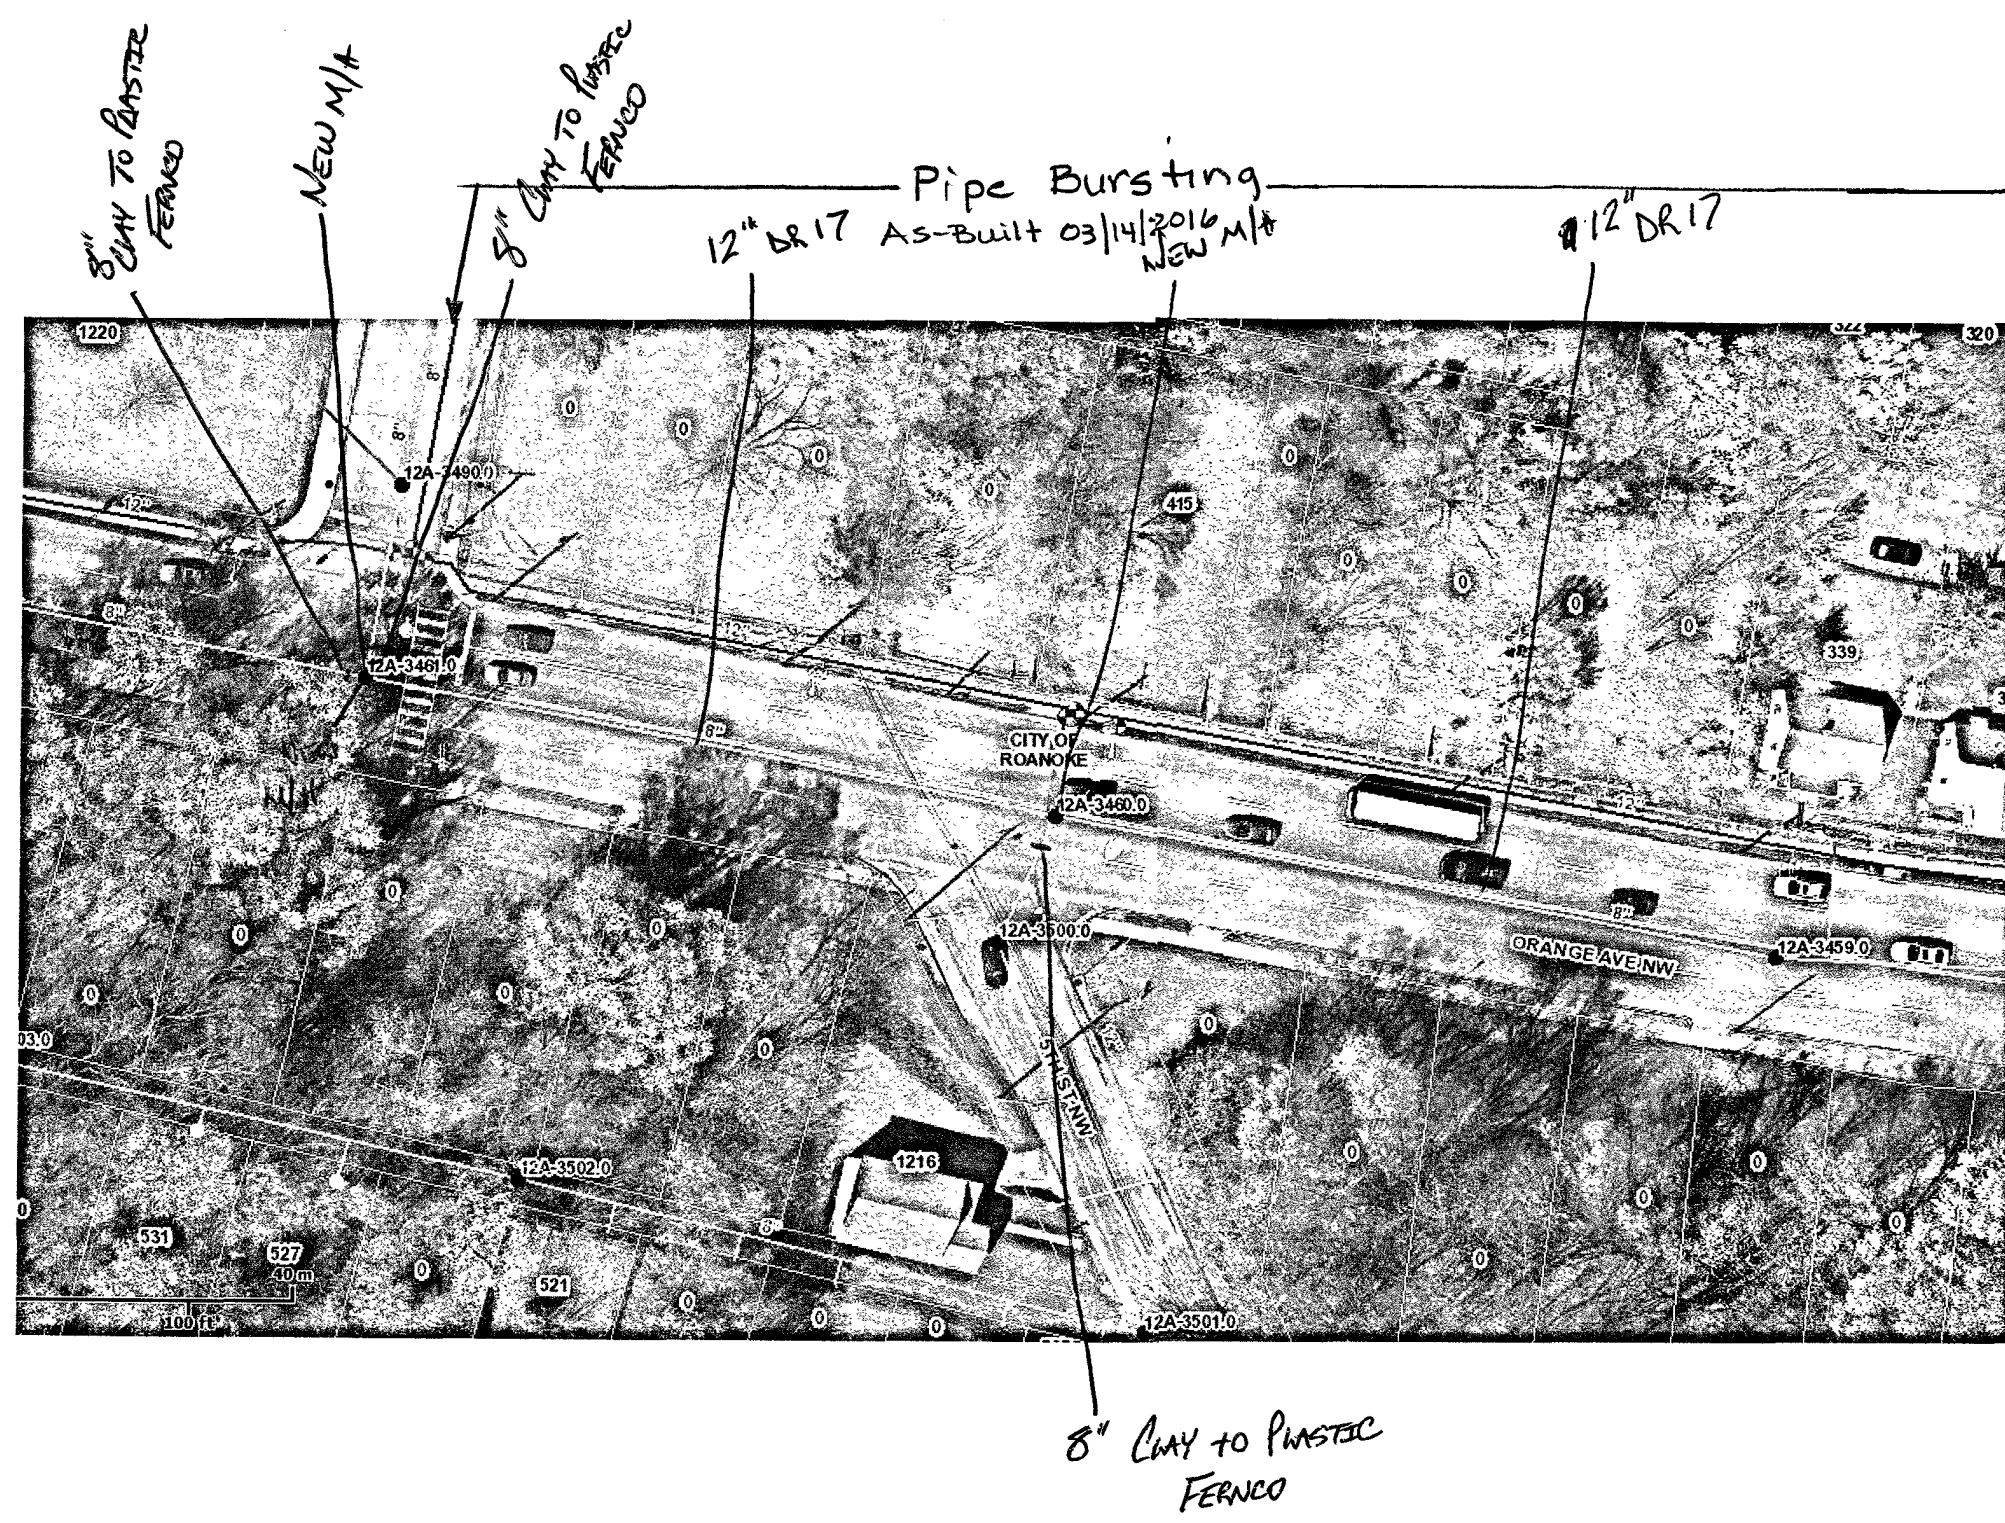

ORANGE AVE. PIPE BURSTING

- New M/H
- 8" CLAY TO PLASTIC FERRO
- 8" STUBOUT IS DEAD
- 8" CLAY TO PLASTIC FERRO

Work done by Western Virginia Water Authority
Field Operations

WESTERN VIRGINIA
WATER AUTHORITY

ENGINEERING SERVICES
601 S JEFFERSON ST, SUITE 300
ROANOKE, VA 24011
540-853-5641 or 540-853-5770

ORANGE AVE SEWER
CIP REALIGNMENT

Pipe Bursting and
CUT PLAN

Rev	Description	Date	By
1	As-Built - Sewer Realignment	04/11/2016	
2	As-Built - Pipe Bursting	03/14/2016	

Designed: JE
Drawn: DRJ
Checked:
Approved: JE, MJO
Date: 3-31-16
Project:

2
Sheet 2 of 2