


10th St., N.W.

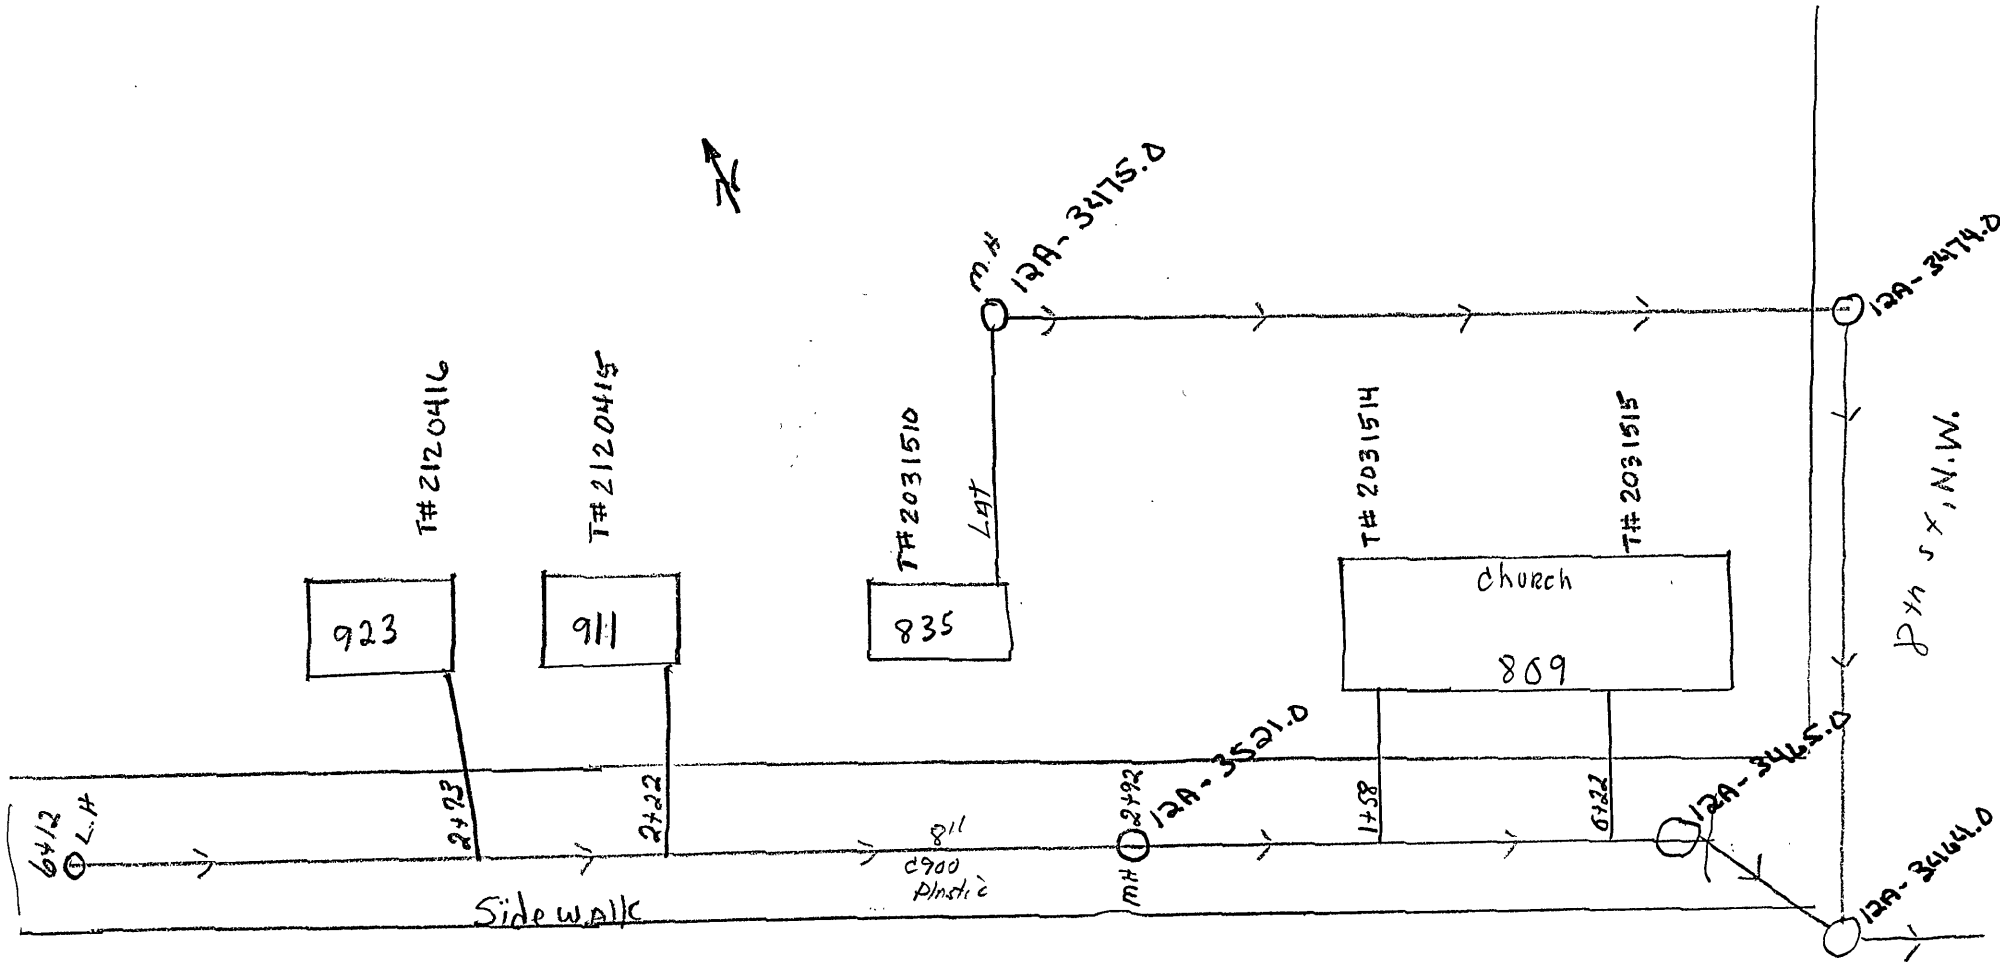

ORANGE AVE., N.W.

Rec. 5.16.05  
From Mark Sims