


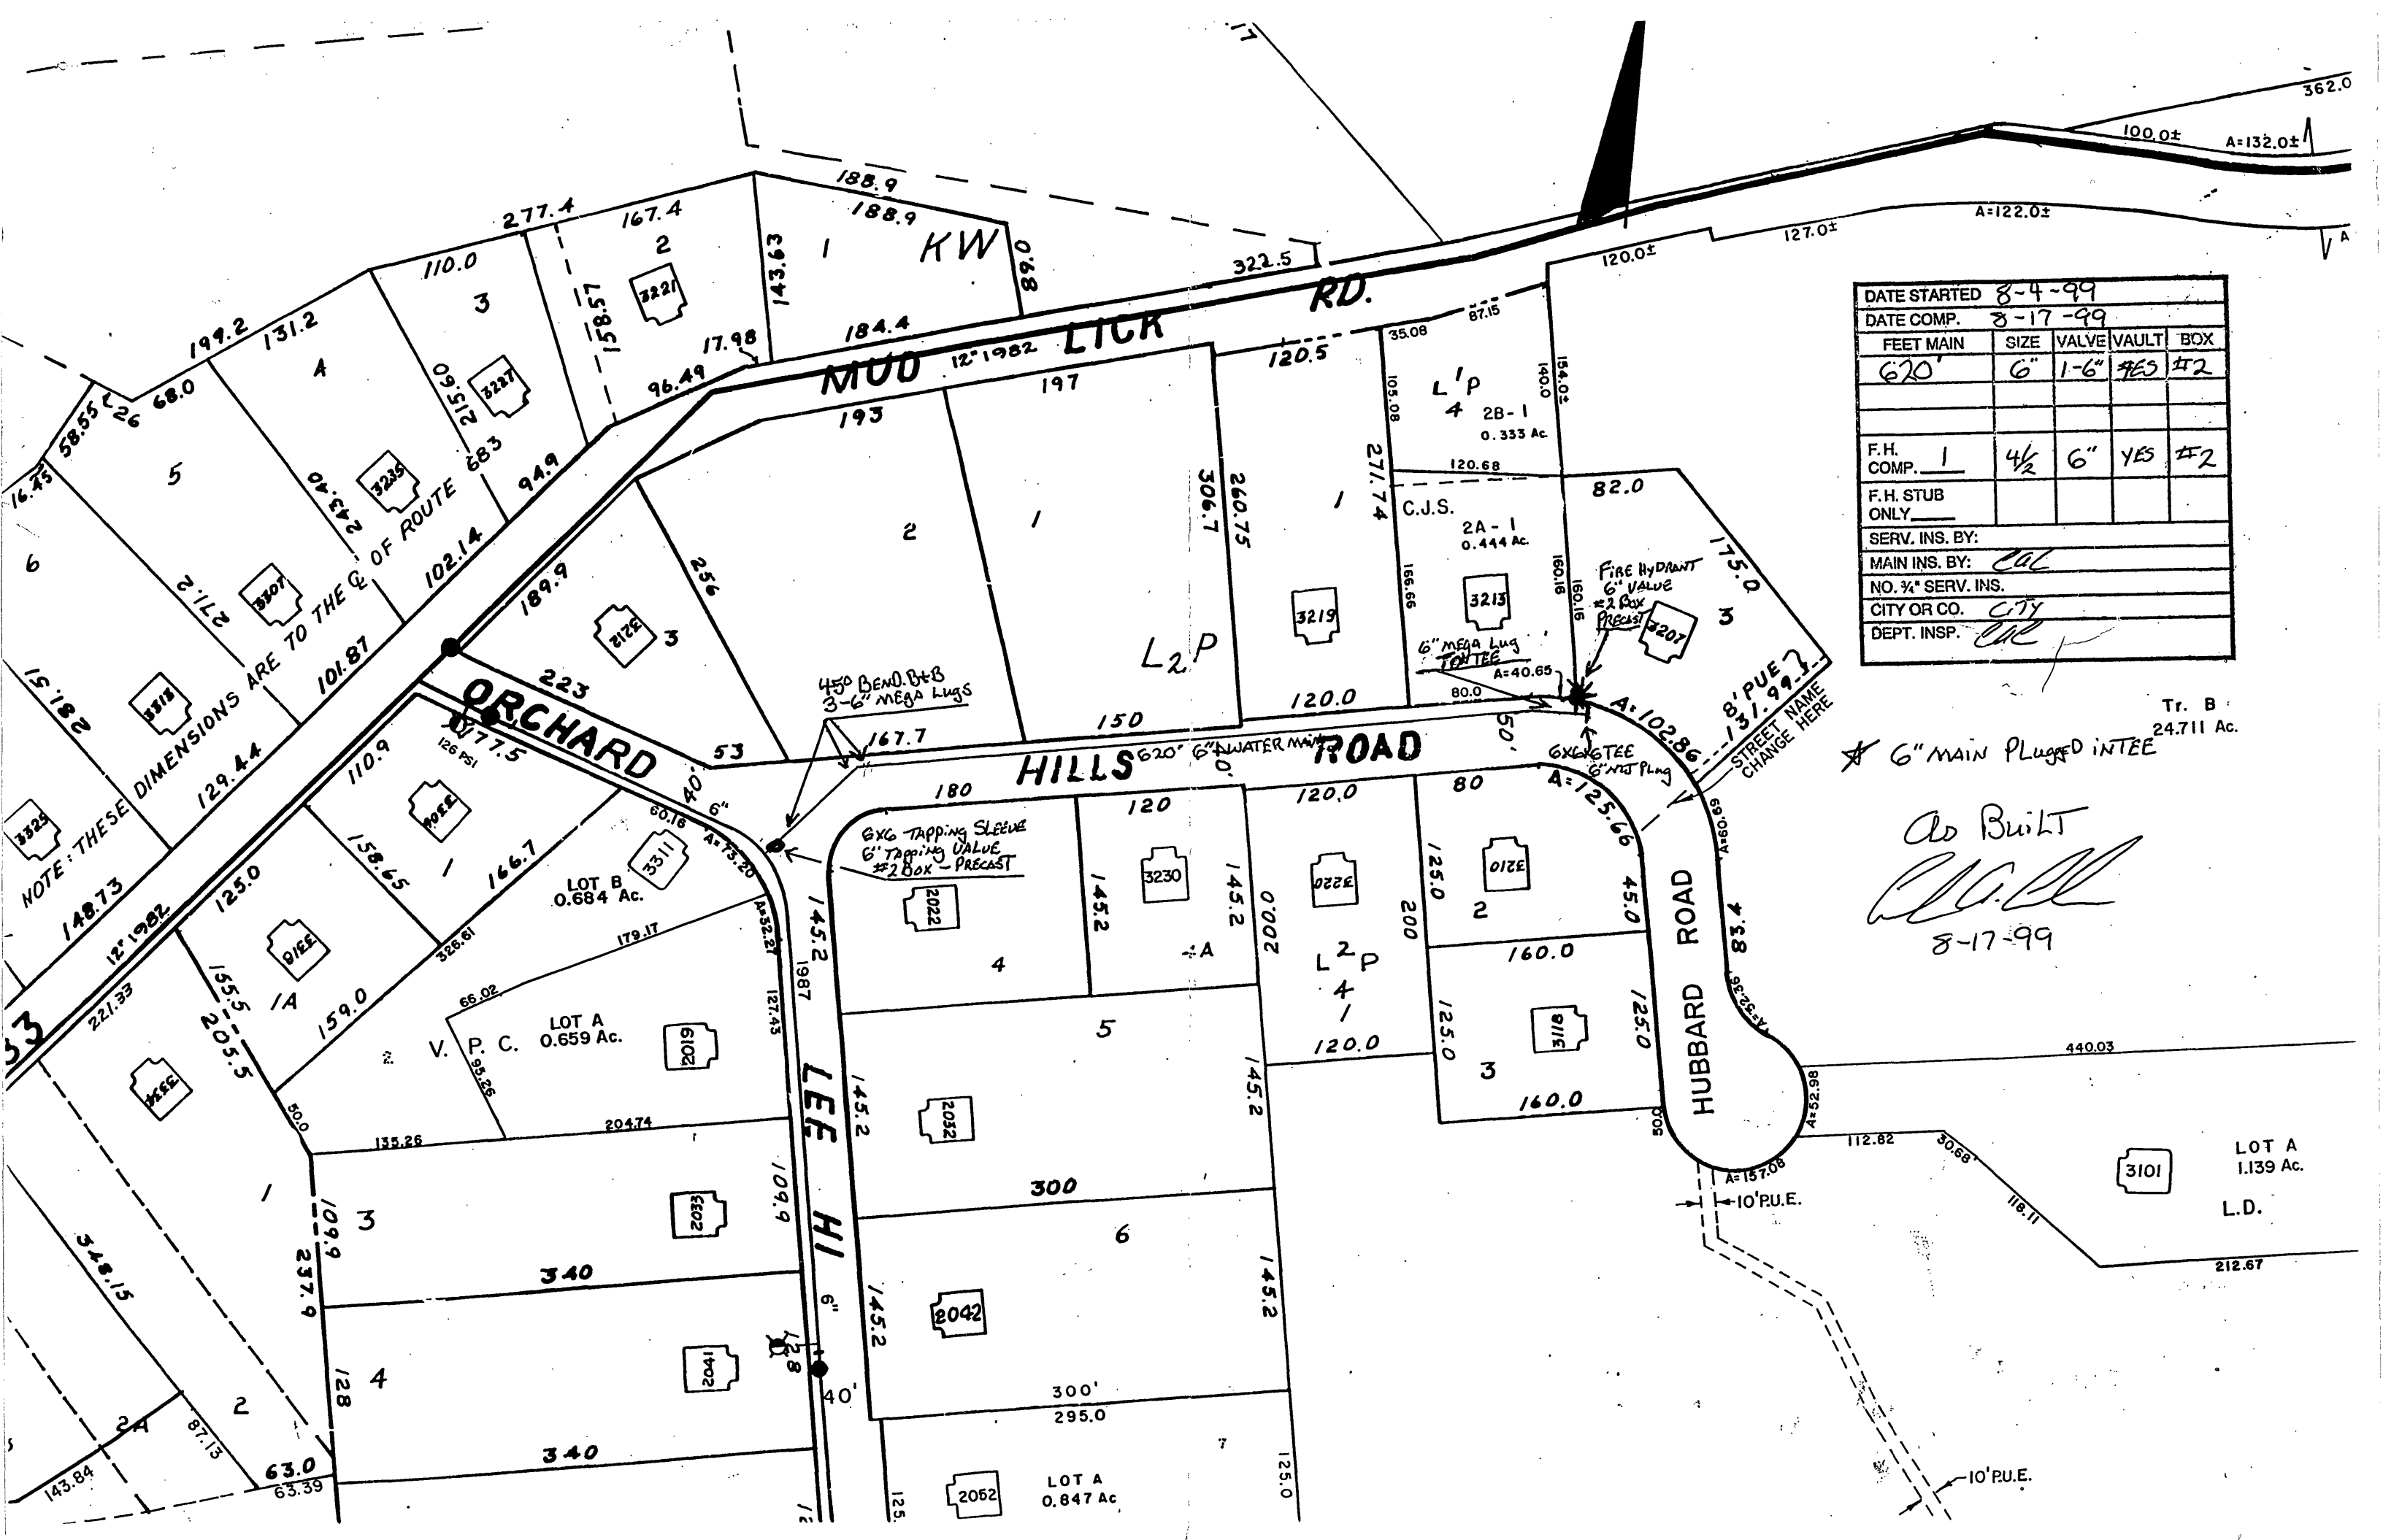

|                              |      |       |       |     |
|------------------------------|------|-------|-------|-----|
| DATE STARTED 8-4-99          |      |       |       |     |
| DATE COMP. 8-17-99           |      |       |       |     |
| FEET MAIN                    | SIZE | VALVE | VAULT | BOX |
| 620'                         | 6"   | 1-6"  | #63   | #2  |
| F.H. COMP. 1 4 1/2 6" YES #2 |      |       |       |     |
| F.H. STUB ONLY               |      |       |       |     |
| SERV. INS. BY:               |      |       |       |     |
| MAIN INS. BY: C.C.           |      |       |       |     |
| NO. 3/4" SERV. INS.          |      |       |       |     |
| CITY OR CO. CITY             |      |       |       |     |
| DEPT. INSP. C.C.             |      |       |       |     |

Tr. B 24.711 Ac.  
\* 6" MAIN PLUGGED INTEE  
As Built  
C.C.  
8-17-99

LOT A 1.139 Ac.  
L.D.