


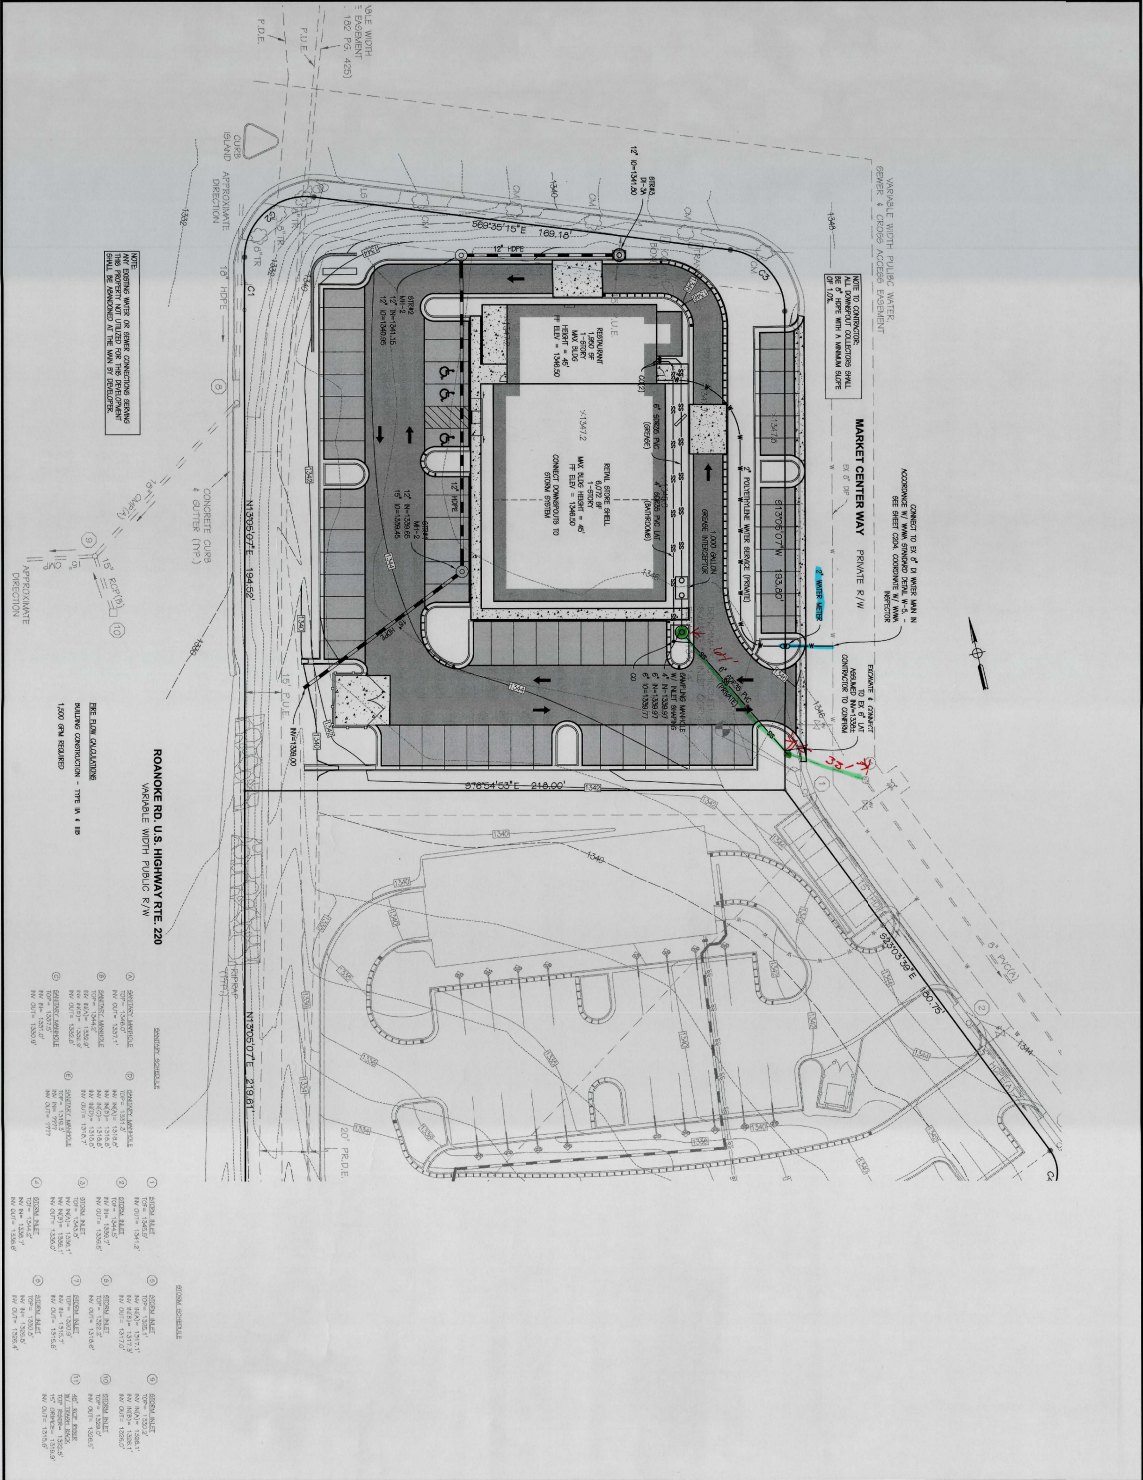

PEARSON CRIMSON ENGINEERING & PLANNING & SURVEYING 3010 E. 10TH AVE. SUITE 100 DENVER, CO 80202 PHONE: 303.733.8888 FAX: 303.733.8889 WWW.PEARSONCRIMSON.COM		CLIENT: THOMAS BUILDERS
JOB: ORCHARD MARKETPLACE RETAIL SHELL DISTRICT DANVILLE VIRGINIA BOTETOURT COUNTY		DATE: 08/21/2022
CONTRACT: 21222		DATE: 08/21/2022
DESIGNER: J. CRIMSON		DATE: 08/21/2022
CHECKED BY: J. CRIMSON		DATE: 08/21/2022
SCALE: 1" = 100'		DATE: 08/21/2022
PROJECT: 21222		DATE: 08/21/2022
SHEET: 6 OF 14		DATE: 08/21/2022