


APPLEWOOD, SECTION No. 19

HOLLINS MAGISTERIAL DISTRICT
ROANOKE COUNTY, VIRGINIA

DATE: MAY 5, 2008

F & W COMMUNITY DEVELOPMENT CORP.

DEVELOPMENT PLAN	
APPROVED	
FOR CONSTRUCTION	
BY ROANOKE COUNTY	
Department	Date
Development Review	6/3/08
Engineering	6/3/08
Water & Sewer	6/27/08
Planning & Zoning	6/3/08

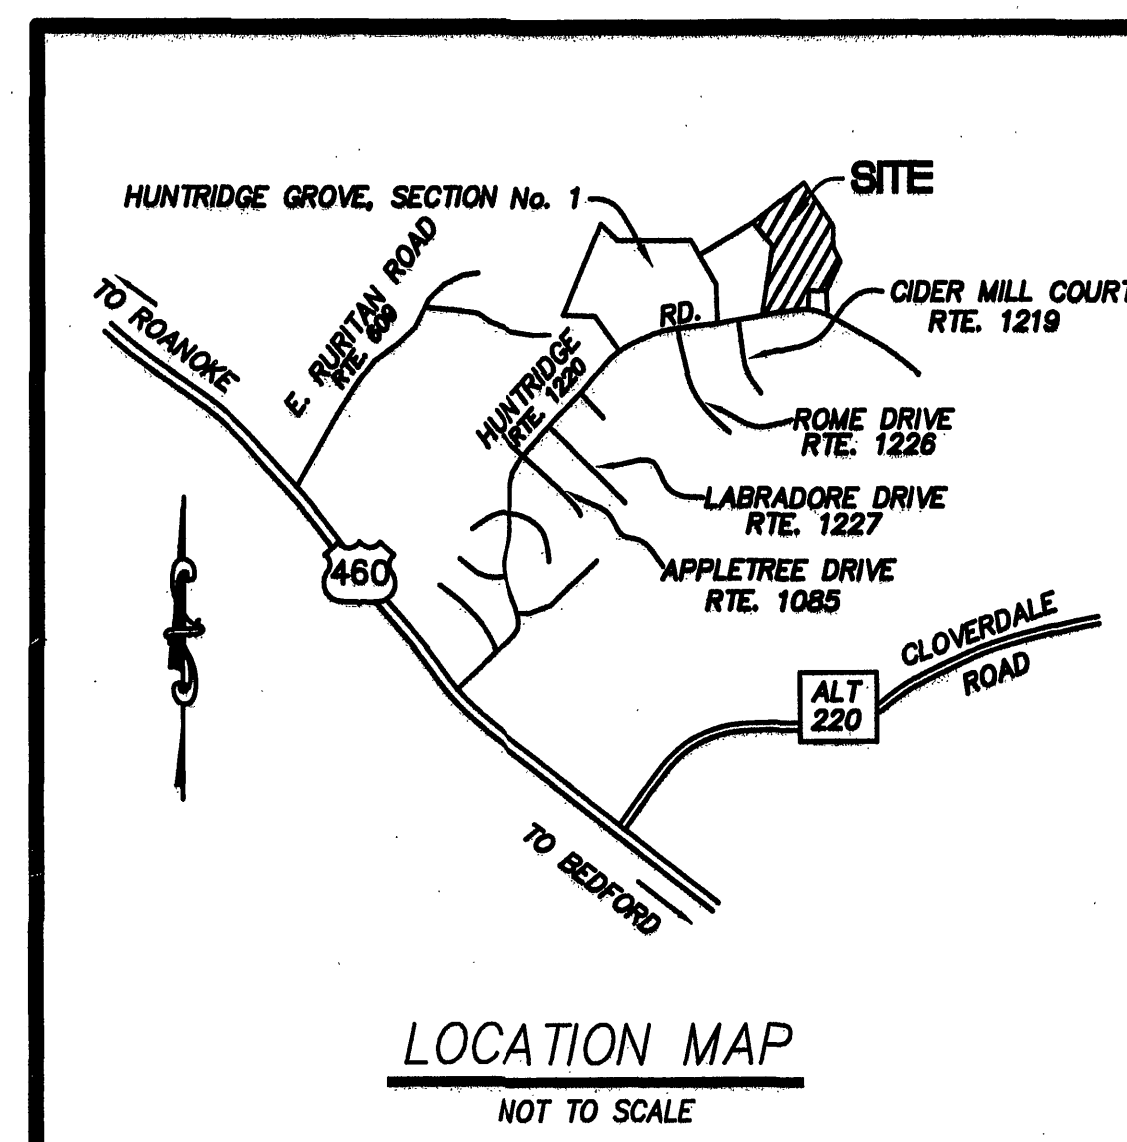

1. LUMSDEN ASSOCIATES COVER SHEET
2. ROANOKE COUNTY STANDARD COVER SHEET
3. RECORD PLAT
4. NOTES AND DETAILS
5. DIMENSIONAL LAYOUT
6. GRADING PLAN
7. DETAILED GRADING PLAN
8. ROAD, WATER, AND SANITARY SEWER PROFILES
9. STORM DRAIN PROFILES
10. EROSION AND SEDIMENT CONTROL PLAN
11. EROSION AND SEDIMENT CONTROL DETAILS
12. WATER AND SANITARY SEWER DETAILS
13. WATER AND SANITARY SEWER DETAILS

APPENDIX

I AM CERTIFIED BY THE STATE OF VIRGINIA AS A "RESPONSIBLE LAND DISTURBER". I SHALL BE RESPONSIBLE FOR THE IMPLEMENTATION OF THE EROSION AND SEDIMENT CONTROL PLAN AS SHOWN.


SIGNATURE:
PRINTED NAME:
CERTIFICATE No.:
EXPIRATION DATE:
TELEPHONE No.:
ADDRESS:
.



LUMSDEN ASSOCIATES, P.C.
ENGINEERS-SURVEYORS-PLANNERS

4664 BRAMBLETON AVENUE, SW
P.O. BOX 20669
ROANOKE, VIRGINIA 24018

PHONE: (540) 774-4411
FAX: (540) 772-9445
E-MAIL: MAIL@LUMSDENPC.COM

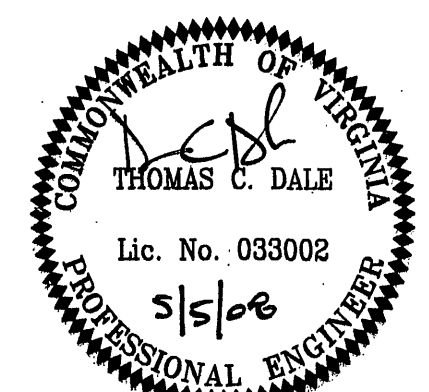

REVISIONS	
DATE	SHEETS
COMMISSION NO.	
2007-230	
SHEET 1 OF 13	

As-Built 2.27.09 K. Winslow