


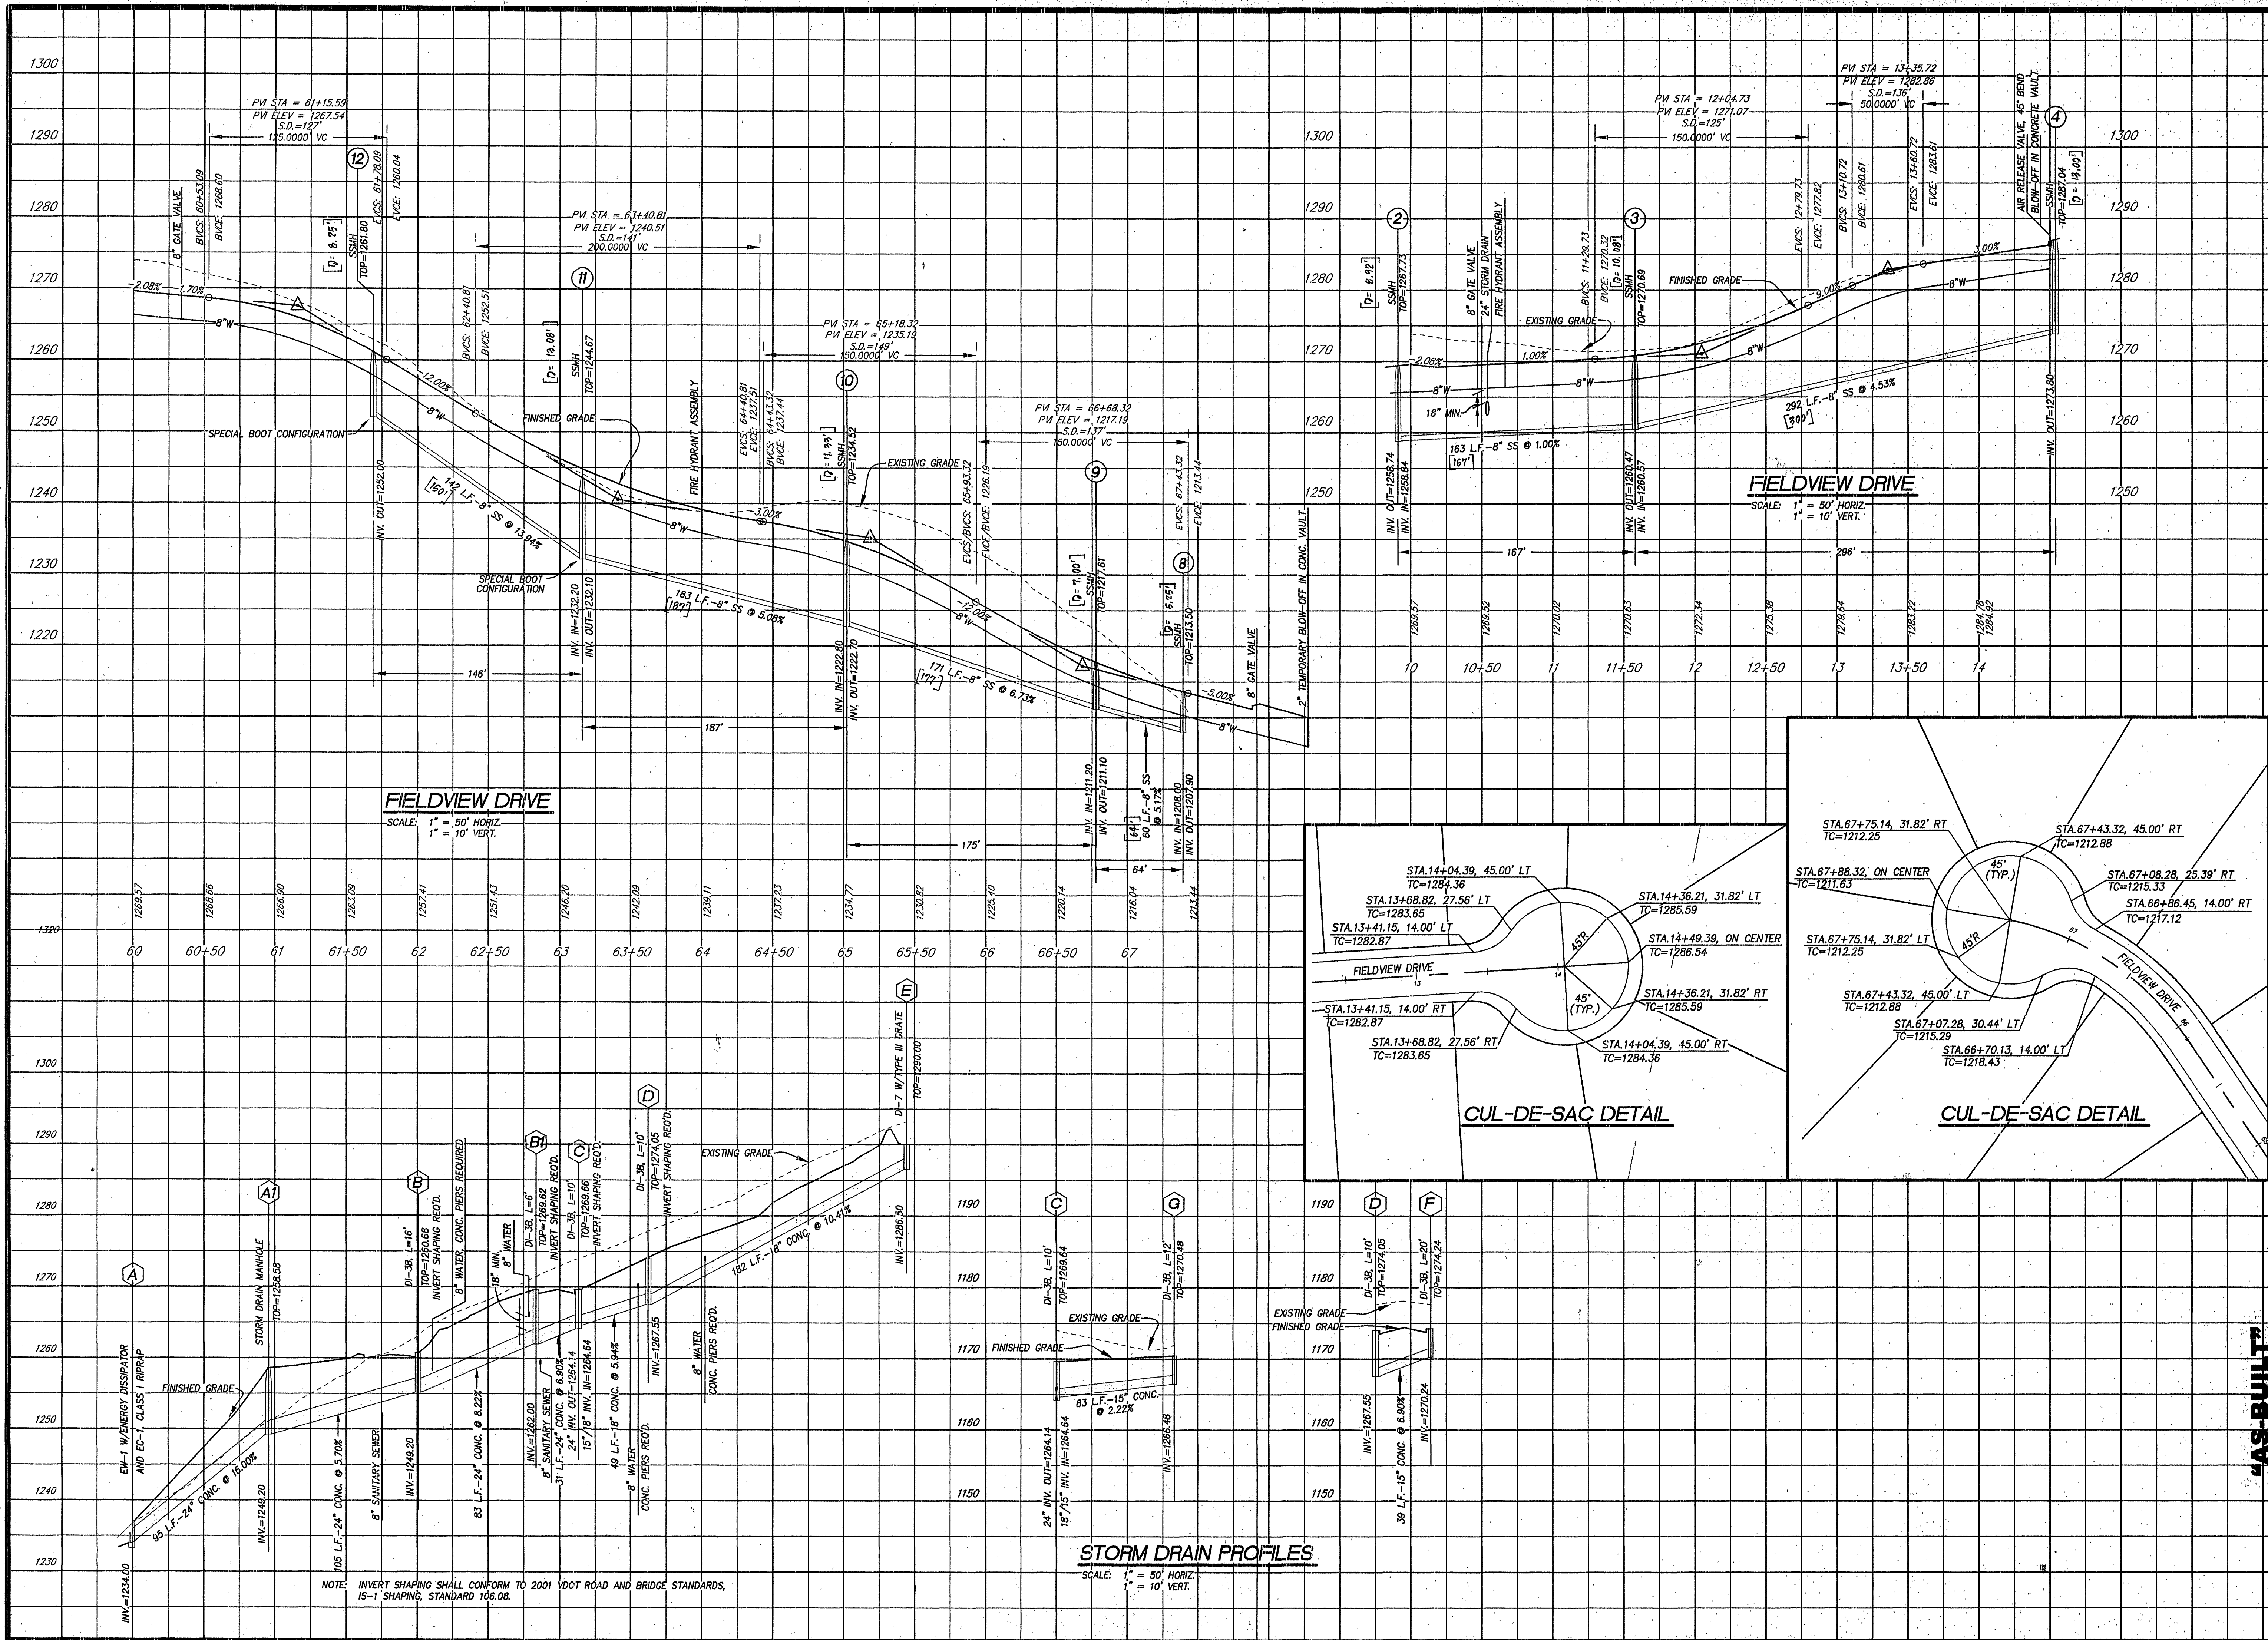

LUMSDEN ASSOCIATES, P.C.
ENGINEERS-SURVEYORS-PLANNERS
ROANOKE, VIRGINIA

4665 BRAMBLETON AVENUE
P.O. BOX 20669
ROANOKE, VIRGINIA 24018

PHONE: (540) 774-4411
FAX: (540) 772-9445
E-MAIL: MAIL@LUMSDENPC.COM

PROFESSIONAL ENGINEER
MICHAEL S. WEBB
No. 012656
6-7-02

PROFILES

THE ORCHARDS
SECTION No. 2
CORTLAND MEADOWS

PREPARED FOR
F. & W. COMMUNITY DEVELOPMENT CORP.
HOLLINS MAGISTERIAL DISTRICT - ROANOKE COUNTY, VIRGINIA
VALLEY MAGISTERIAL DISTRICT - BOTETOURT COUNTY, VIRGINIA

WWW.ID# 6PVJHL

NO.	DATE	DESCRIPTION
1	1/27/13	AS-BUILT SANITARY SEWER
2		
3		
4		
5		

DATE: 6 JUNE 2002
SCALE: AS SHOWN
COMMISSION NO.: 01-307
SHEET 8 OF 12