


03332comp-fr01.plt

f:\2003\03332\enp\03332comp.dwg

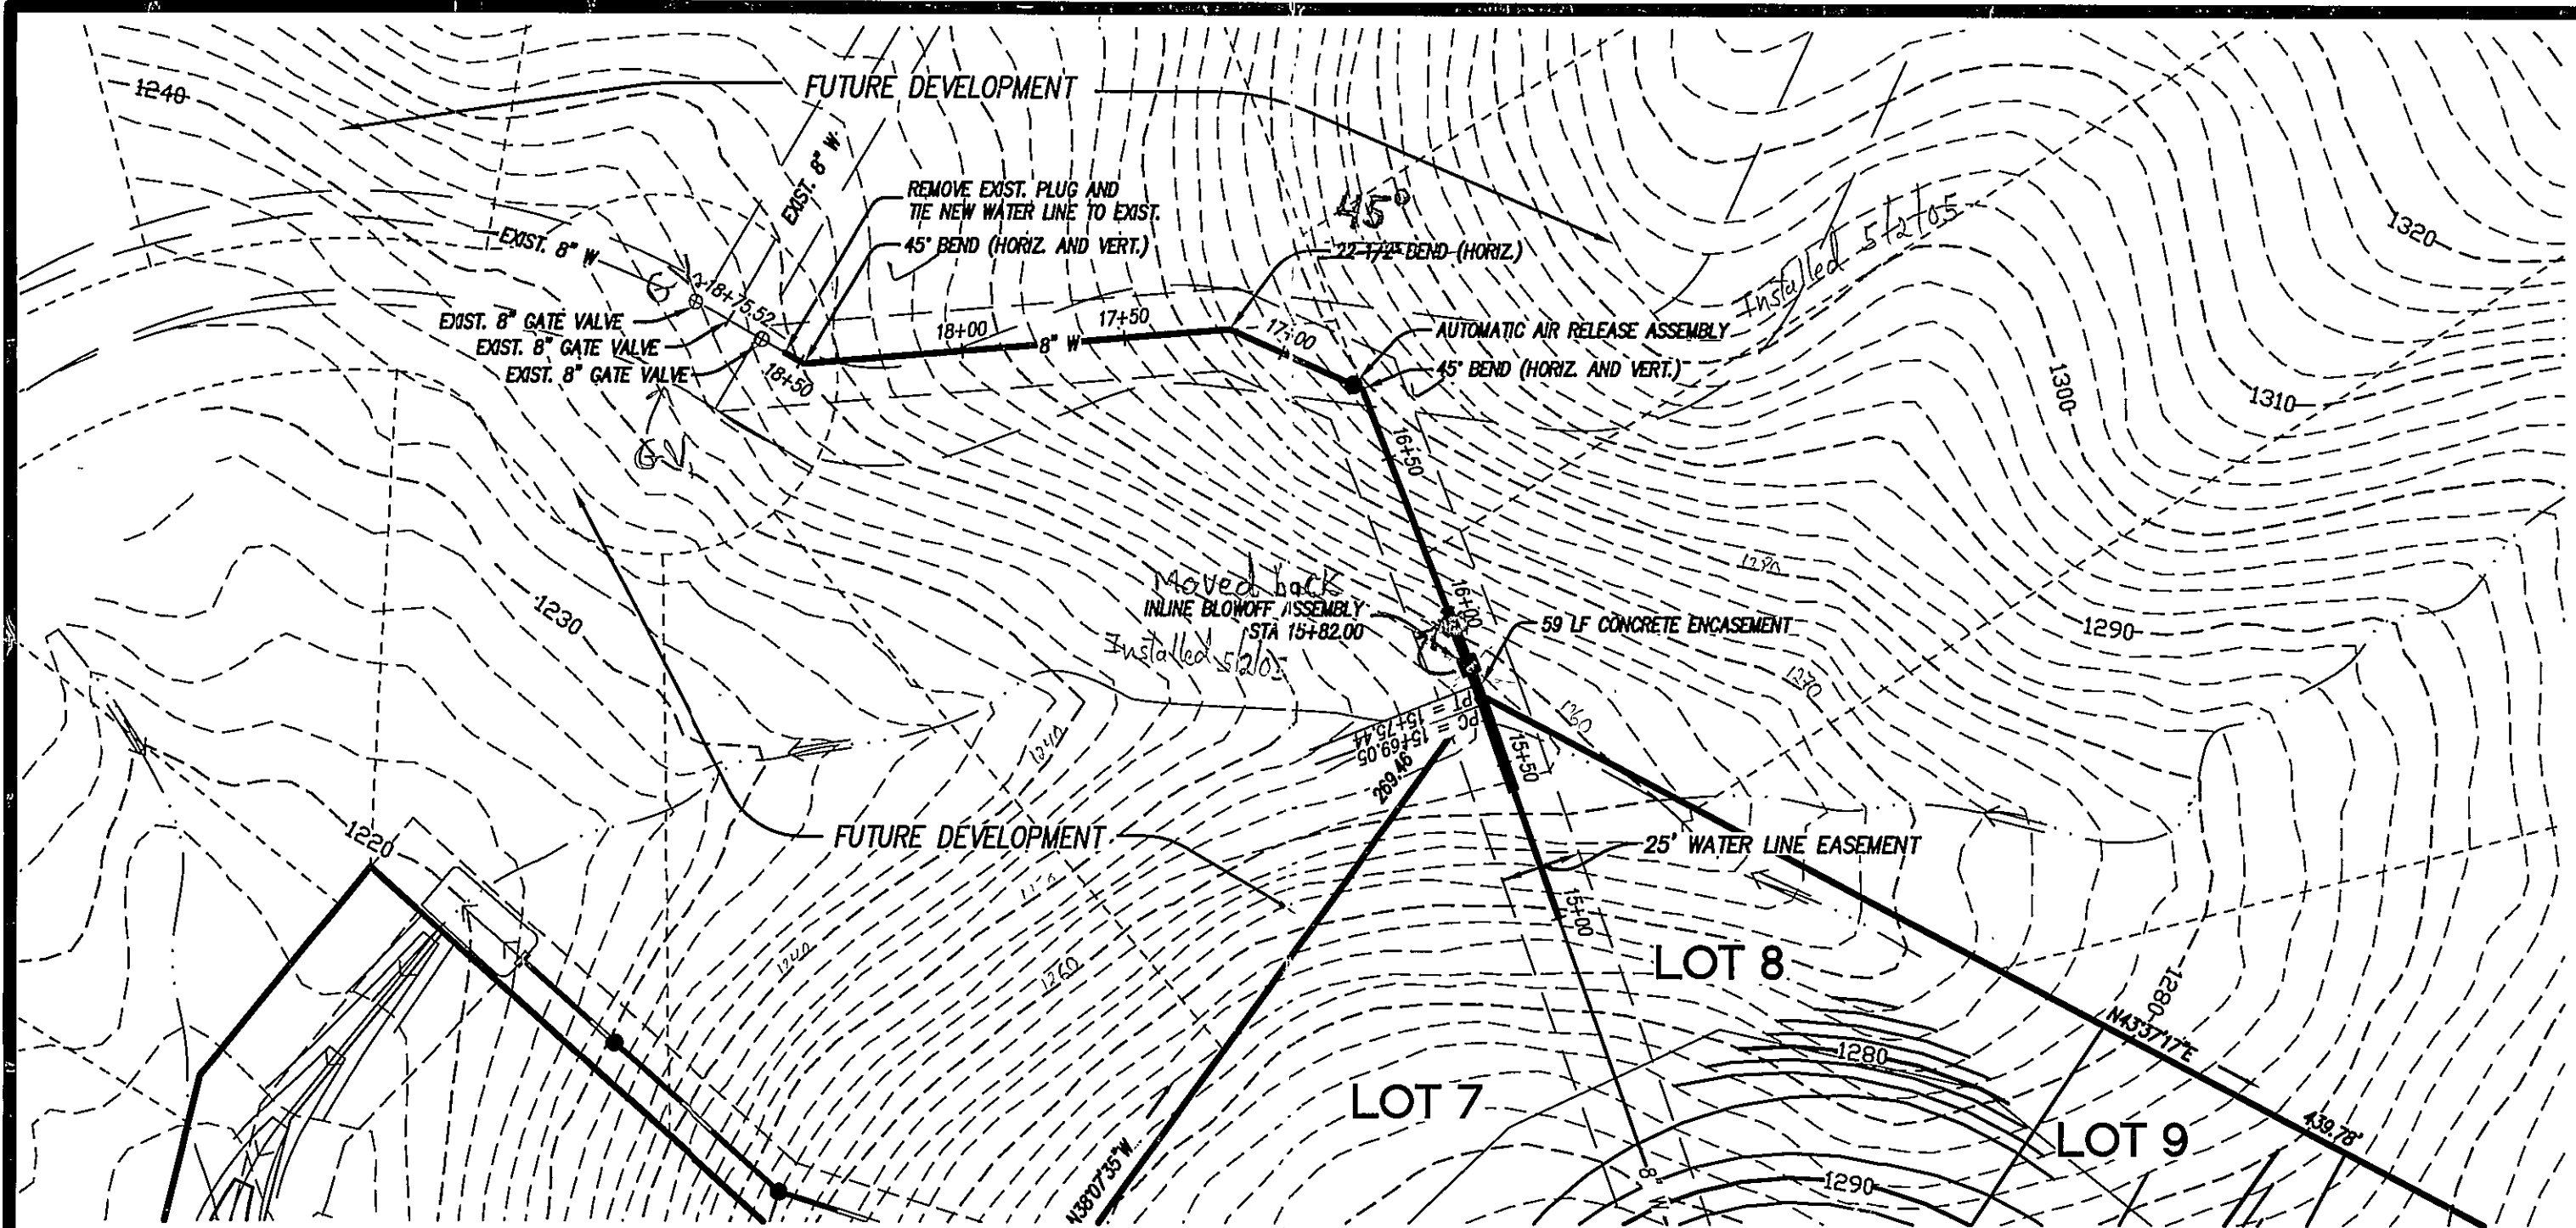

G-V₁ → ARV = 208'
G-V₂ → ARV = 230'
G-V₁ → Blowoff = 253'
G-V₂ → BO = 272'

FIELD REVISION TO THE WATER LINE AT
CORTLAND MEADOWS, SECTION No. 3

PROPERTY OF
F. & W. COMMUNITY DEVELOPMENT CORPORATION
HOLLINS MAGISTERIAL DISTRICT
ROANOKE COUNTY, VIRGINIA

As-Built



LUMSDEN ASSOCIATES, P.C.
ENGINEERS-SURVEYORS-PLANNERS
ROANOKE, VIRGINIA

4664 BRAMBLETON AVENUE
P.O. BOX 20669
ROANOKE, VIRGINIA 24018

PHONE: (540) 774-4411
FAX: (540) 772-9445
E-MAIL: MAIL@LUMSDENPC.COM

DATE:	April 19, 2005
COMM. NO.:	2003-332
SCALE:	1" = 50'