R&E 191253 8-77 MC66

NO. DATE APPR.


REVISION

RECORD DRAWING

Revised to show the conditions according to construction records of APRIL, 1988

Date: 5/10/02 By: ROY F. WESTON, P.E. RICHMOND, VIRGINIA

## CITY OF ROANOKE, VIRGINIA OFFICE OF CITY ENGINEER ORE BRANCH SANITARY SEWER UPPER SEGMENT

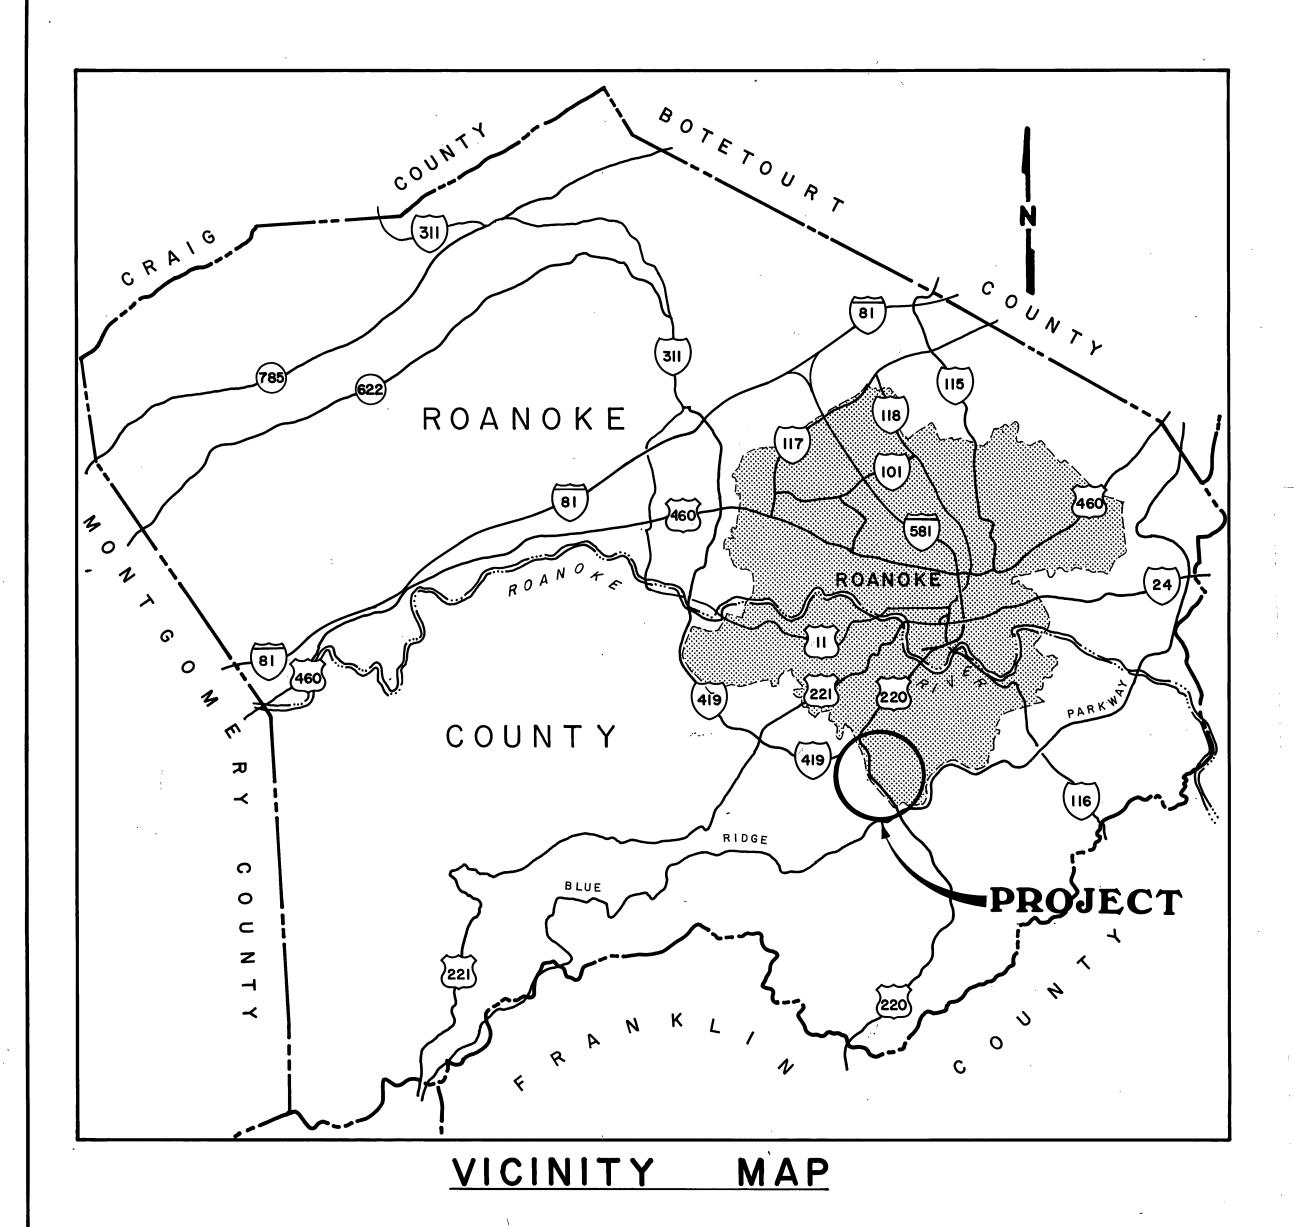

NO. DATE APPR.

REVISION

## DRAWING INDEX

DWG. NO.


DESCRIPTION

TITLE SHEET

PLAN AND PROFILE

## LEGEND

----x---x--- FENCE S- SANITARY SEWER & M.H. -W---- WATER LINE & VALVE --- HIGH PRESSURE GAS LINE —D → STORM DRAIN \_\_ TELEPHONE CABLE UNDERGROUND ELECTRICAL DROPINLET OR CATCH BASIN WATER METER HYDRANT POWER POLE PAVED SURFACE UNPAVED SURFACÉ SIGN BASE BENCH MARK — FUTURE FACILITIES PROPOSED FACILITIES ★ SANITARY SEWER & M.H.

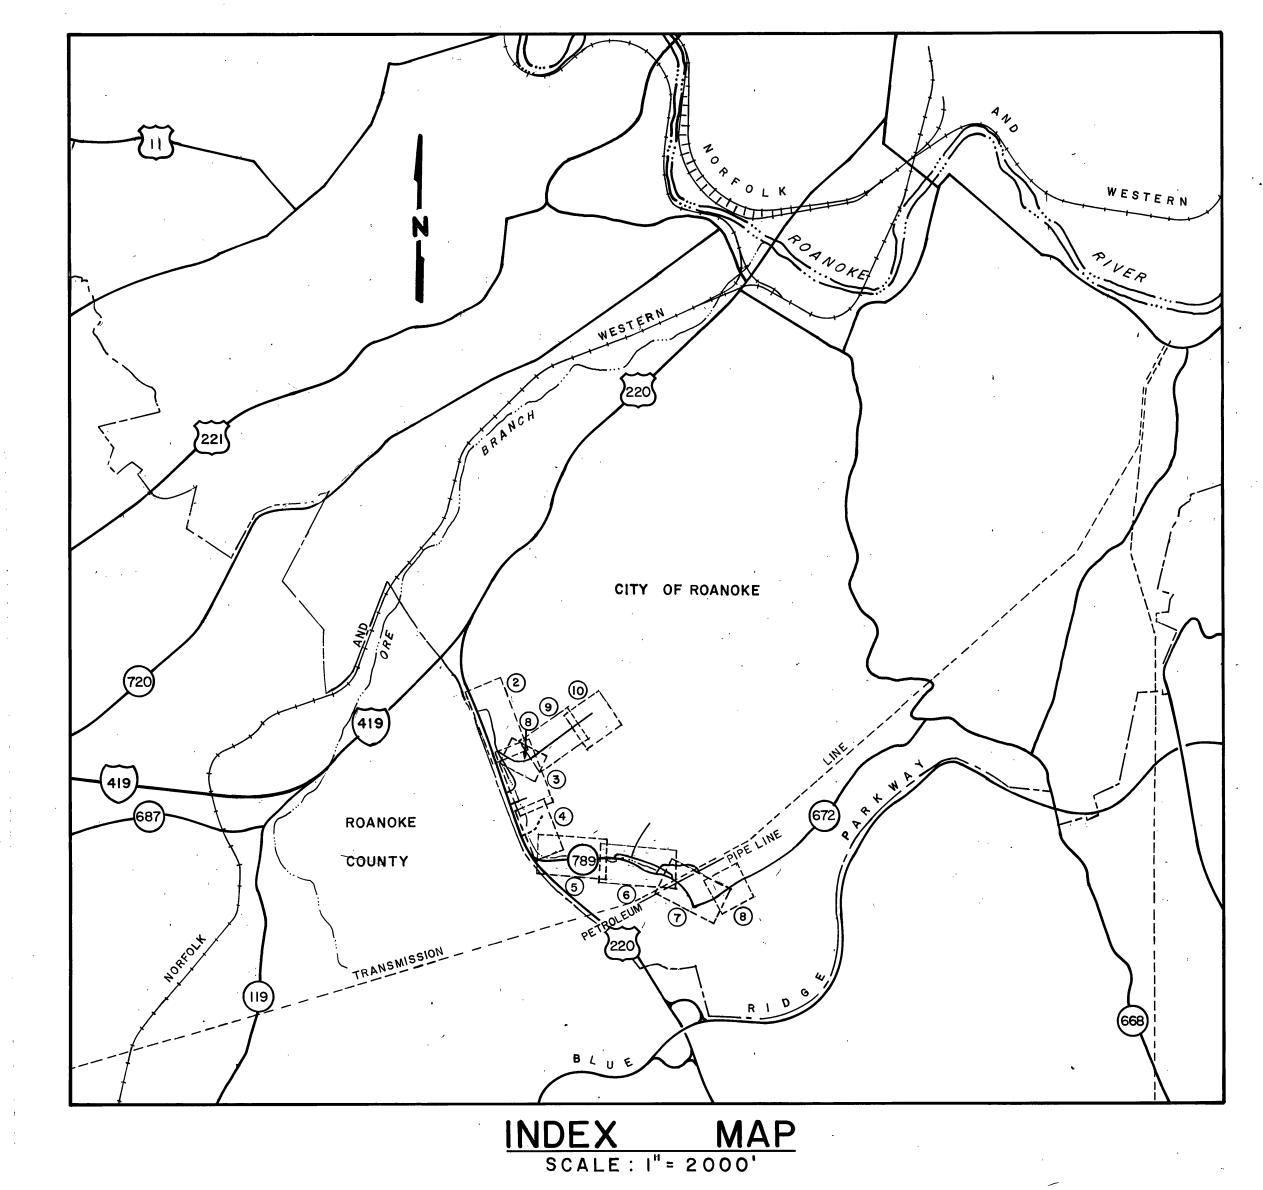

ORE BRANCH SANITARY SEWER CITY OF ROANOKE, VIRGINIA

SERVICE LATERAL CONNECTION

ENVIRONMENTAL CONSULTANTS-DESIGNERS

DES. ENG.

PROJ. ENG.

PROJ. MGR.

APPROVED

DATE

CLIENT APPROVALS

DATE

CLIENT APPROVALS

DATE

WENDLE R. SMAPP

SMAULL ( May)

CERTIFICATE No.

2525

APPROVED

ISSUED FOR

CONSTRUCTION

DATE

2/9/81

TITLE SHEET

DRAWN
C. L. GIBSON
SEPT. 1980
PLAN NO. 5772
SCALE
W.O. NO.
0384-05-01
SHT. I OF IO