


VICINITY MAP



INDEX OF SHEETS

SHEET NO.	DESCRIPTION
A	COVER SHEET
1	SUMMARY SHEET
2	PLAN & PROFILE
3	" "
4	" "
5	" "
6	" "
7	" "
8	" "
9	CROSS SECTION SHEET
10	" " "

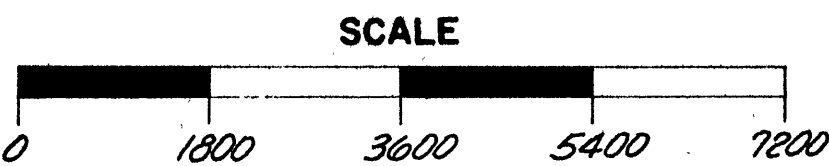

ROANOKE , VIRGINIA

OFFICE OF CITY ENGINEER
CONSTRUCTION PLAN
PROPOSED ORE BRANCH
SANITARY SEWER

As-Built
Red-lined copy

COMMONWEALTH OF VIRGINIA
STATE WATER CONTROL BOARD
Date: MAY 1 1978
☒ Approved
☐ Conditionally Approved
☐ Plans and Specifications
☐ O & M Manual
☐ Addendum
☐ Change Order
☐ Revised Plans and Specifications
☐ Approval Memorandum
by: [Signature]
dated: APR 3 1978
from: E. G. LAWSON
Regional Director

Commonwealth of Virginia
State Health Department
Bureau of Wastewater Engineering
Date: MAR 9 1978
☒ Plans and Specifications Approved
☐ Plans and Specifications Approved with conditions
☐ Plans and Specifications Disapproved
Date of letter: MAR 9 1978
[Signature]
Director, Bureau of Wastewater Engineering



SHEET NO.	DATE	SHEET NO.	DATE
PLANS REVISED			

APPROVED FOR CONSTRUCTION	
2-14-78 DATE	Thomas F. Brady CITY ENGINEER
DATE	
DATE	
APPROVED
DATE
APPROVED
DATE