
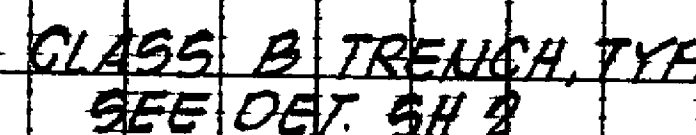


Hand-drawn detail of a metal corner connection. It shows a metal corner (V.D.H. #T.D.I.) with a D.I. #6 bolt. The connection is secured with a P.K. Nail in E.F. The dimensions are 15.20' and 9.95'. The angle is 15.01'.

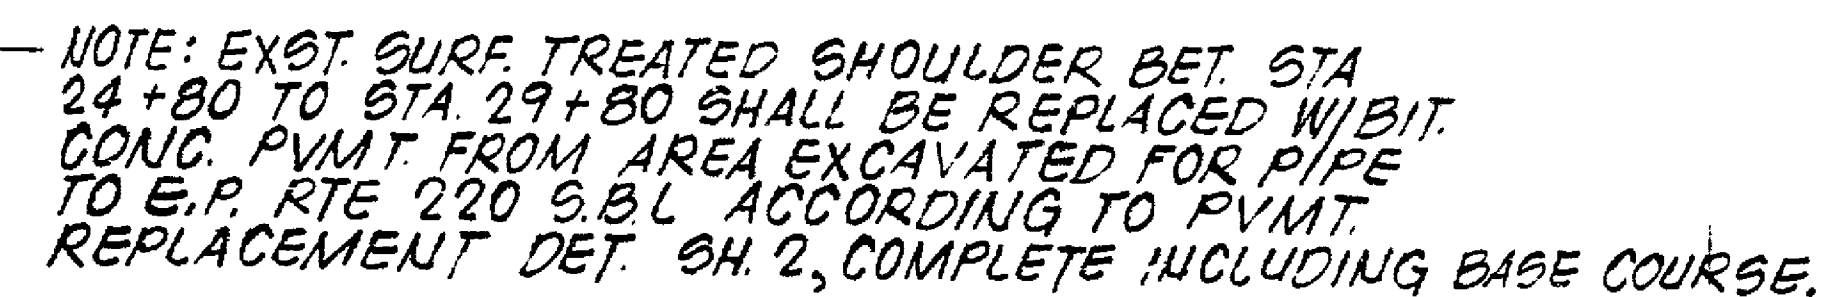

Scale: 1" = 50' Horiz
1" = 10' Vert

AS BUILT

REVISION	DATE	DESCRIPTION	BY	APP
DESIGNED	<i>DM</i>	ORE BRANCH EXTENSION ROANOKE COUNTY, VA. PLAN AND PROFILE STA. 20+00 - STA. 29+00		
DRAWN	<i>DSM</i>			
CHECKED	<i>SWH</i>			
APPROVED	<i>AKC</i>			
SUBMITTED	<i>SWC</i>			
Mattern and Craig CONSULTING ENGINEERS ROANOKE, VIRGINIA			SCALE: <i>NOTED</i> DATE: <i>FEB. 83</i>	COMM. NO. <i>418</i> SHEET <i>5</i>

PROJECT 82-1-S

