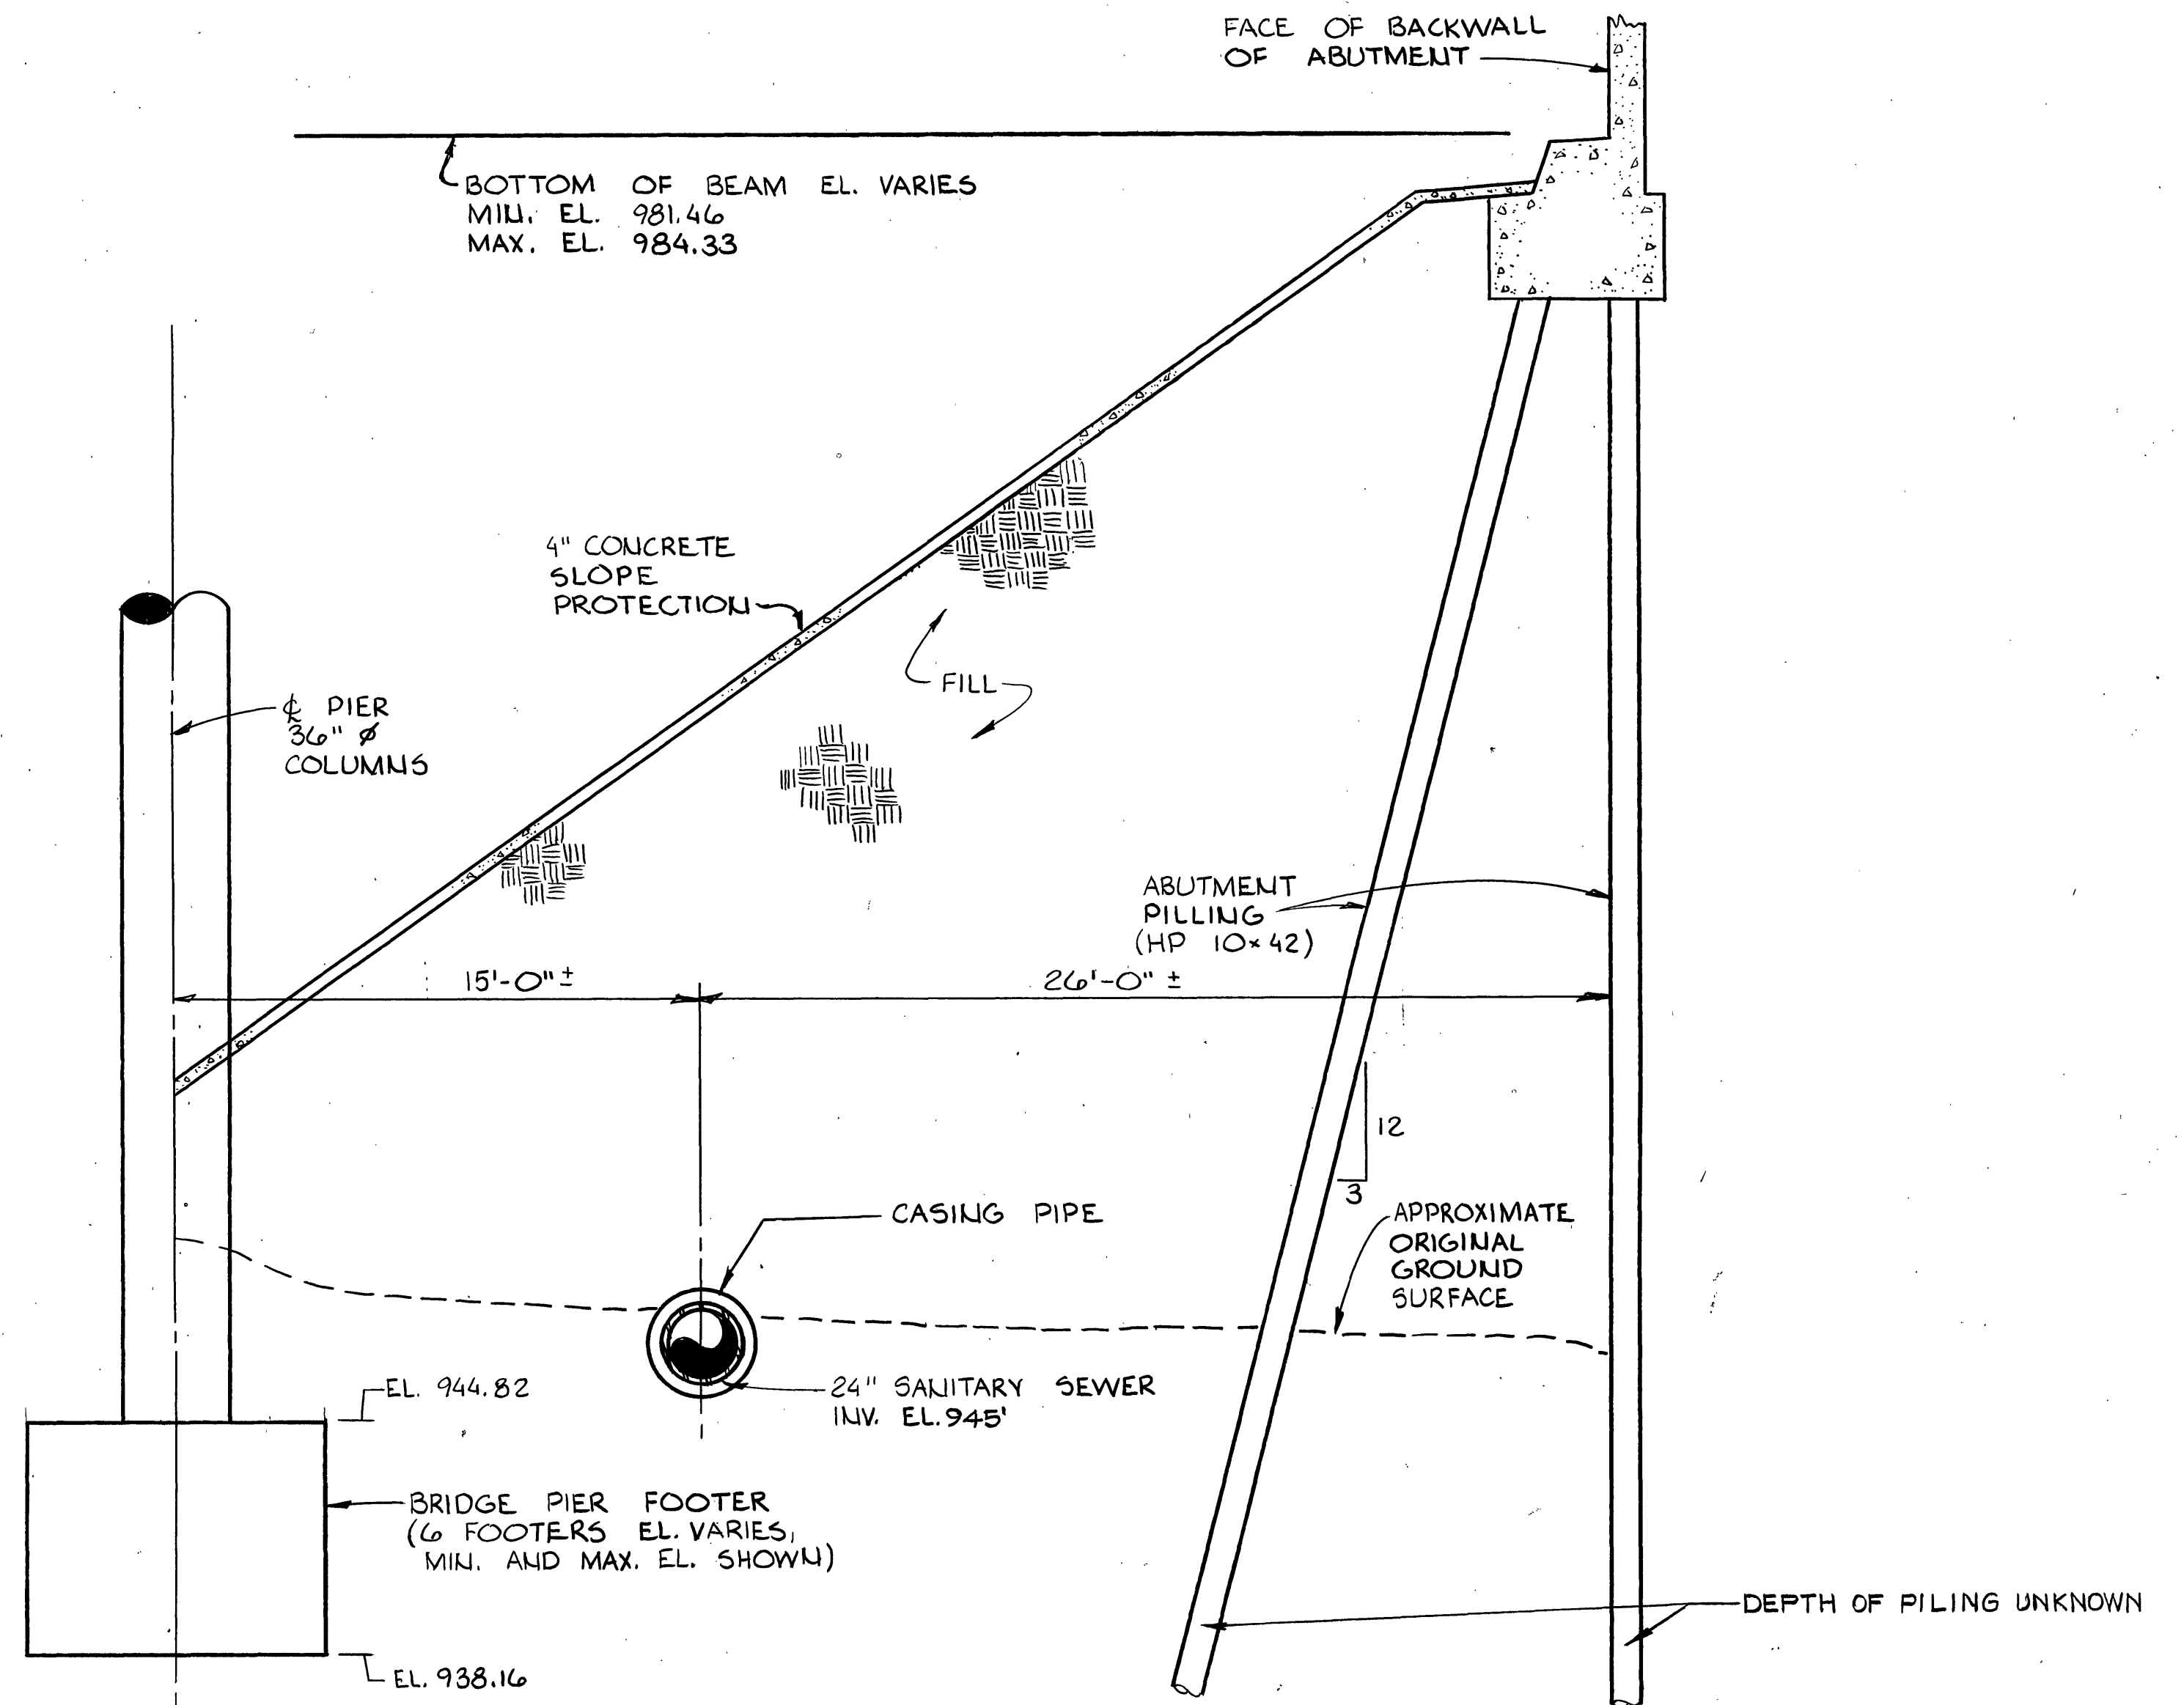
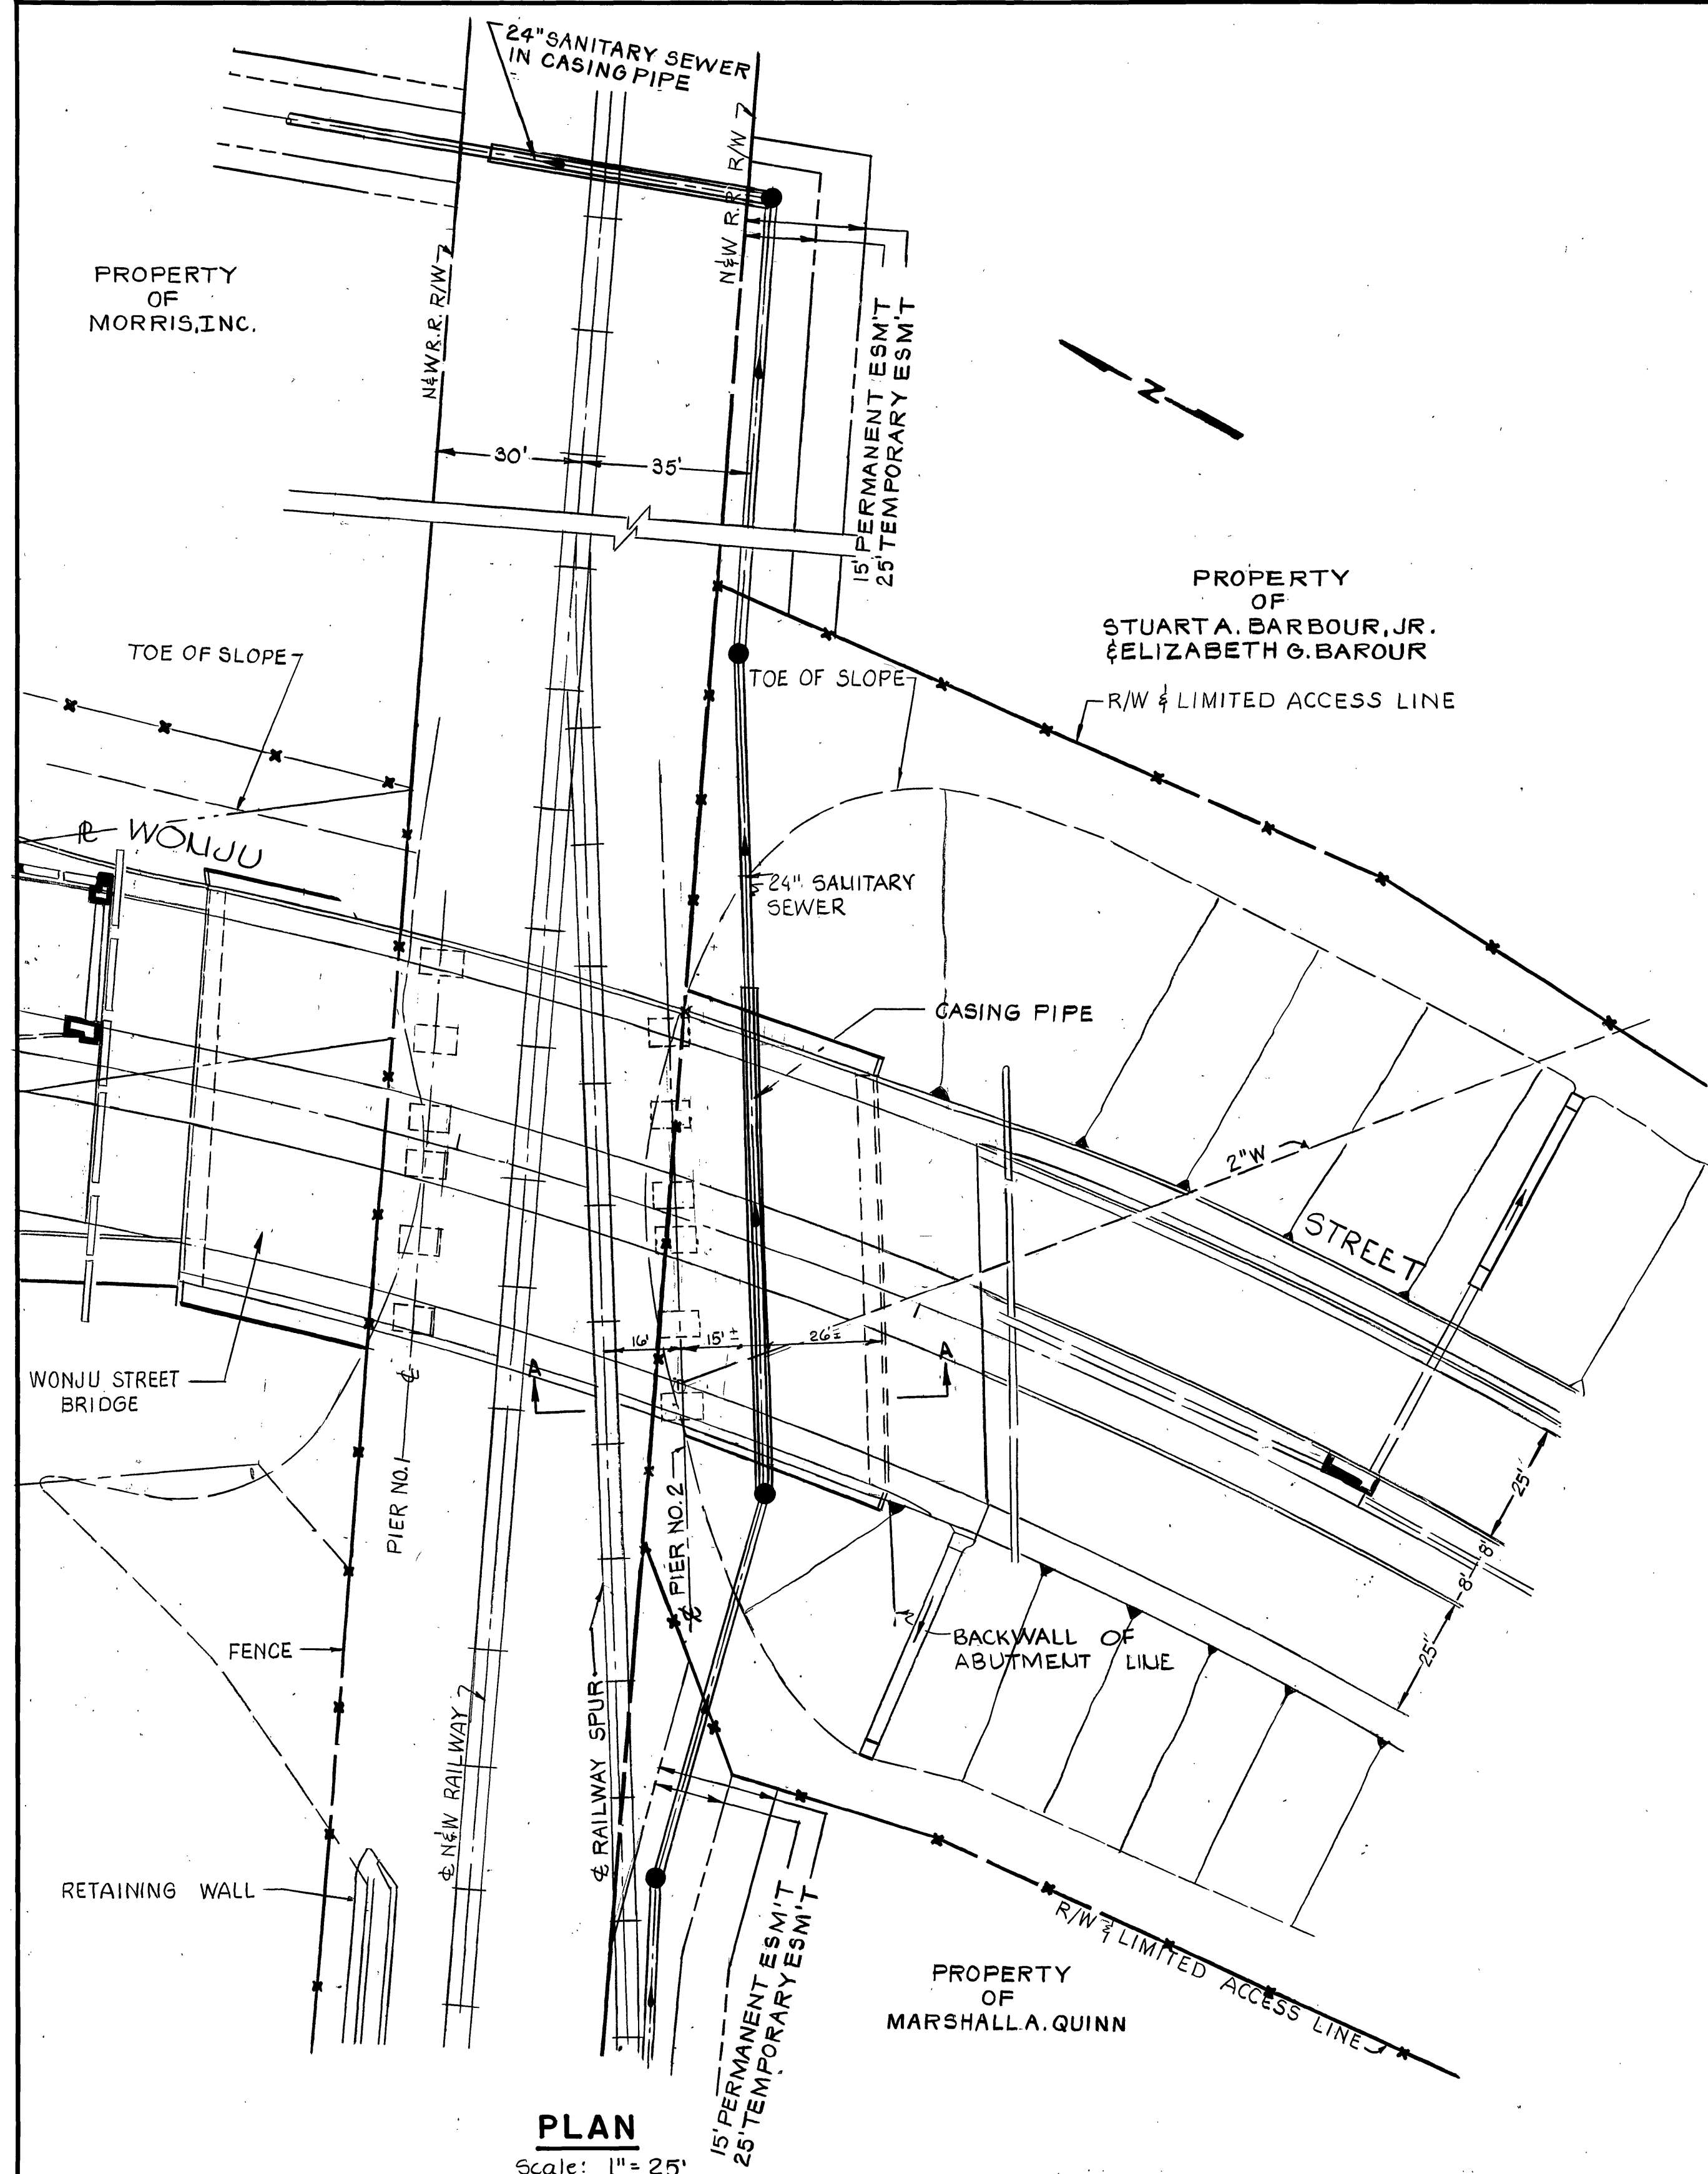



RECORD DRAWING

Revised to show the conditions according to
construction records of APRIL, 1982Date: 4/12/82By: Roy F. WestonROY F. WESTON, P.E.
RICHMOND, VIRGINIAORE BRANCH SANITARY SEWER
CITY OF ROANOKE, VIRGINIAWESTON
ENVIRONMENTAL CONSULTANTS-DESIGNERS

RICHMOND

VIRGINIA

CHECKED	DATE	CLIENT APPROVALS	DATE
DES. ENG.			
PROJ. ENG.	<u>11/26/80</u>		
PROJ. MGR.	<u>11/26/80</u>		
APPROVED			
APPROVED		ISSUED FOR CONSTRUCTION	DATE <u>2/3/81</u>

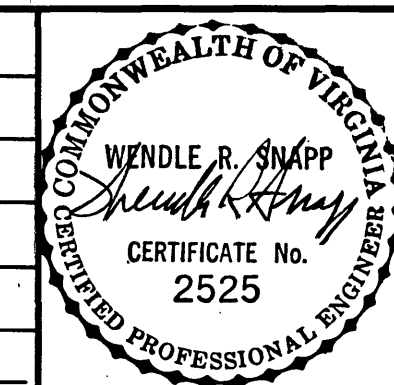LOWER SEGMENT
N&W RAILWAY AND WONJU STREET
BRIDGE CROSSINGS

DRAWN D. PHILLIPS	DATE JUNE 1980	DWG. NO. PLAN NO. 4924	REV. NO.
SCALE AS SHOWN	W.O. NO. 0384-05-01	SHT. 6 OF 6	