
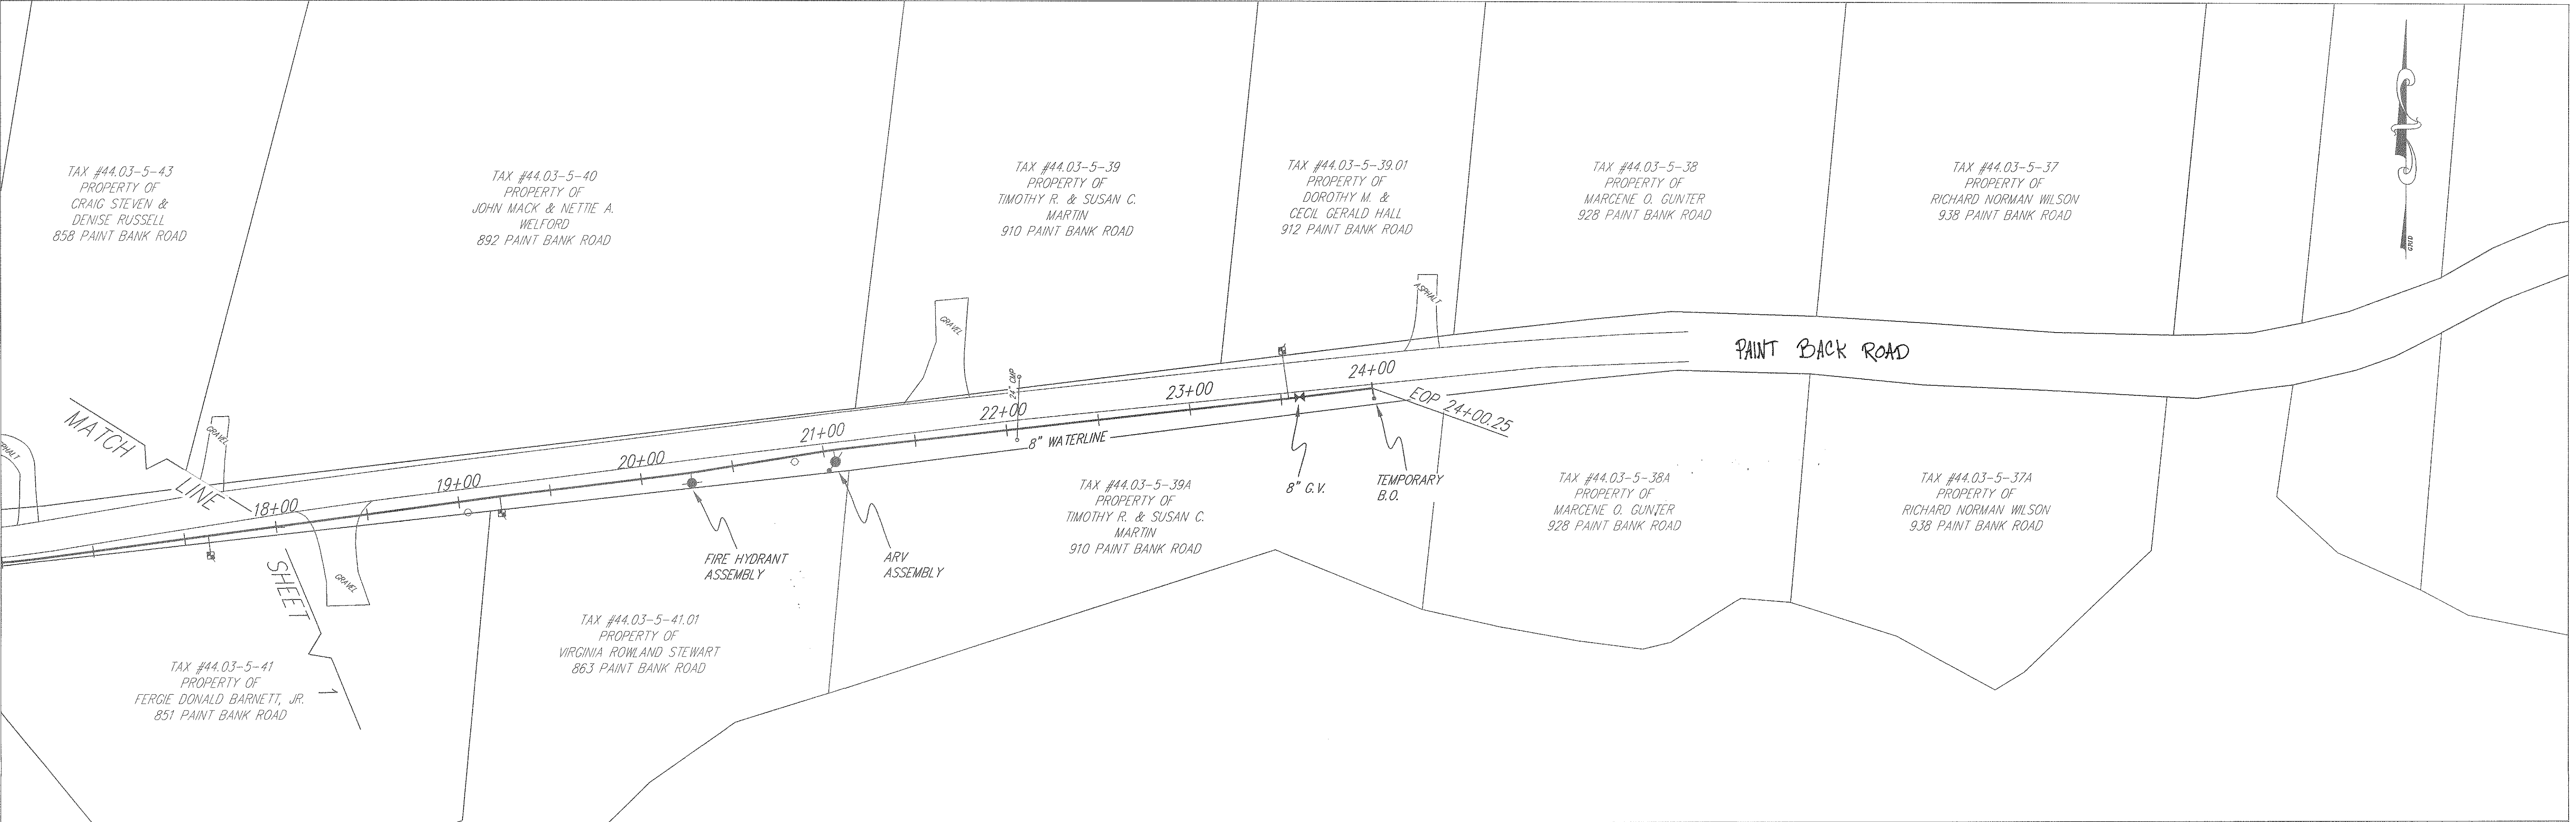


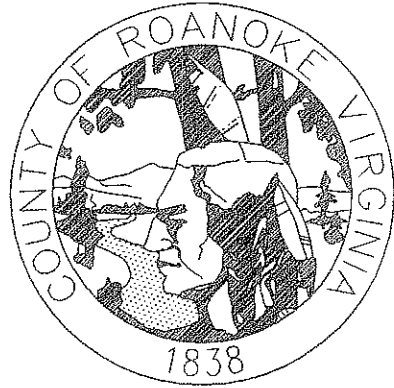

- NOTES:
1. ALL WATER SERVICE LINES SHALL BE PUNCHED OR "HOLE-HOGGED" NO OPEN CUTS.
 2. WATER LINES SHALL BE INSTALLED AT LEAST 3 FEET FROM THE EDGE OF PAVEMENT.
 3. ALL BORINGS SHALL BE IN COMPLIANCE WITH FIGURE 1 FROM THE "DOT" "LAND USE PERMIT MANUAL".
 4. ALL FIRE HYDRANTS SHALL BE LOCATED AT THE EDGE OF THE RIGHT AWAY.
 5. ALL PAVEMENT CUTTING SHALL BE IN COMPLIANCE WITH THE LATEST EDITION OF THE "DOT" "ROAD AND BRIDGE SPECIFICATIONS".

AS-BUILT
3 DEC 2001

REVISION	DATE	DESCRIPTION
DESIGNED BY:	RCF	 PAINT BANK ROAD WATER LINE REPLACEMENT PROJECT CAVE SPRING MAGISTERIAL DISTRICT ROANOKE COUNTY, VIRGINIA ROANOKE COUNTY UTILITY DEPARTMENT 1208 KESSLER MILL ROAD SALEM, VIRGINIA 24153
DRAWN BY:	SJY	
CHECKED BY:		
SCALE:	1"= 50' HOR. 1"= 10' VERT.	
DATE:	15 AUG 2001	