


Contractor J.P. Turner
as-built 10/1994

PARK
LANE

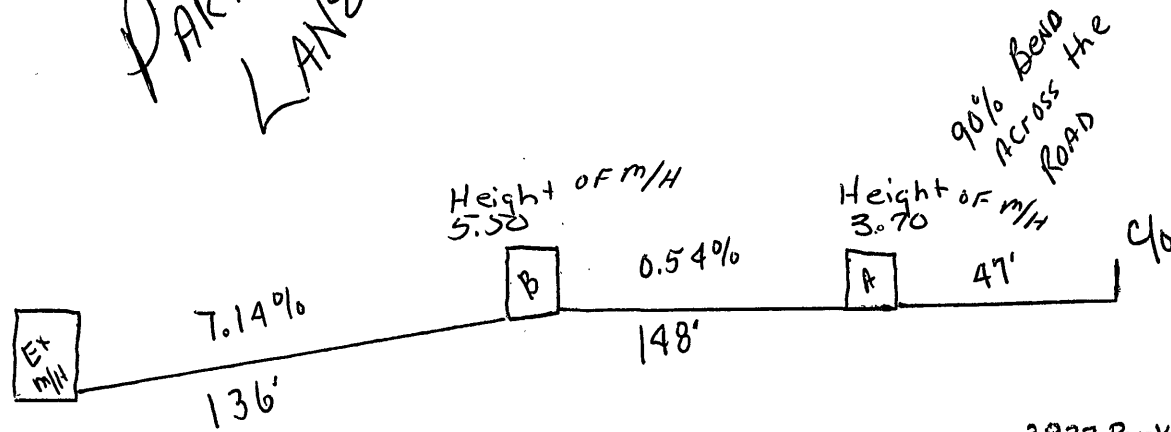

3833 Park Ln.
To Lot D
C/L

Park Lane

