


Redford Co. 202 Over 1/2 way
Rt. 24 Turn on Rt 1015 Park Kurnes Estates

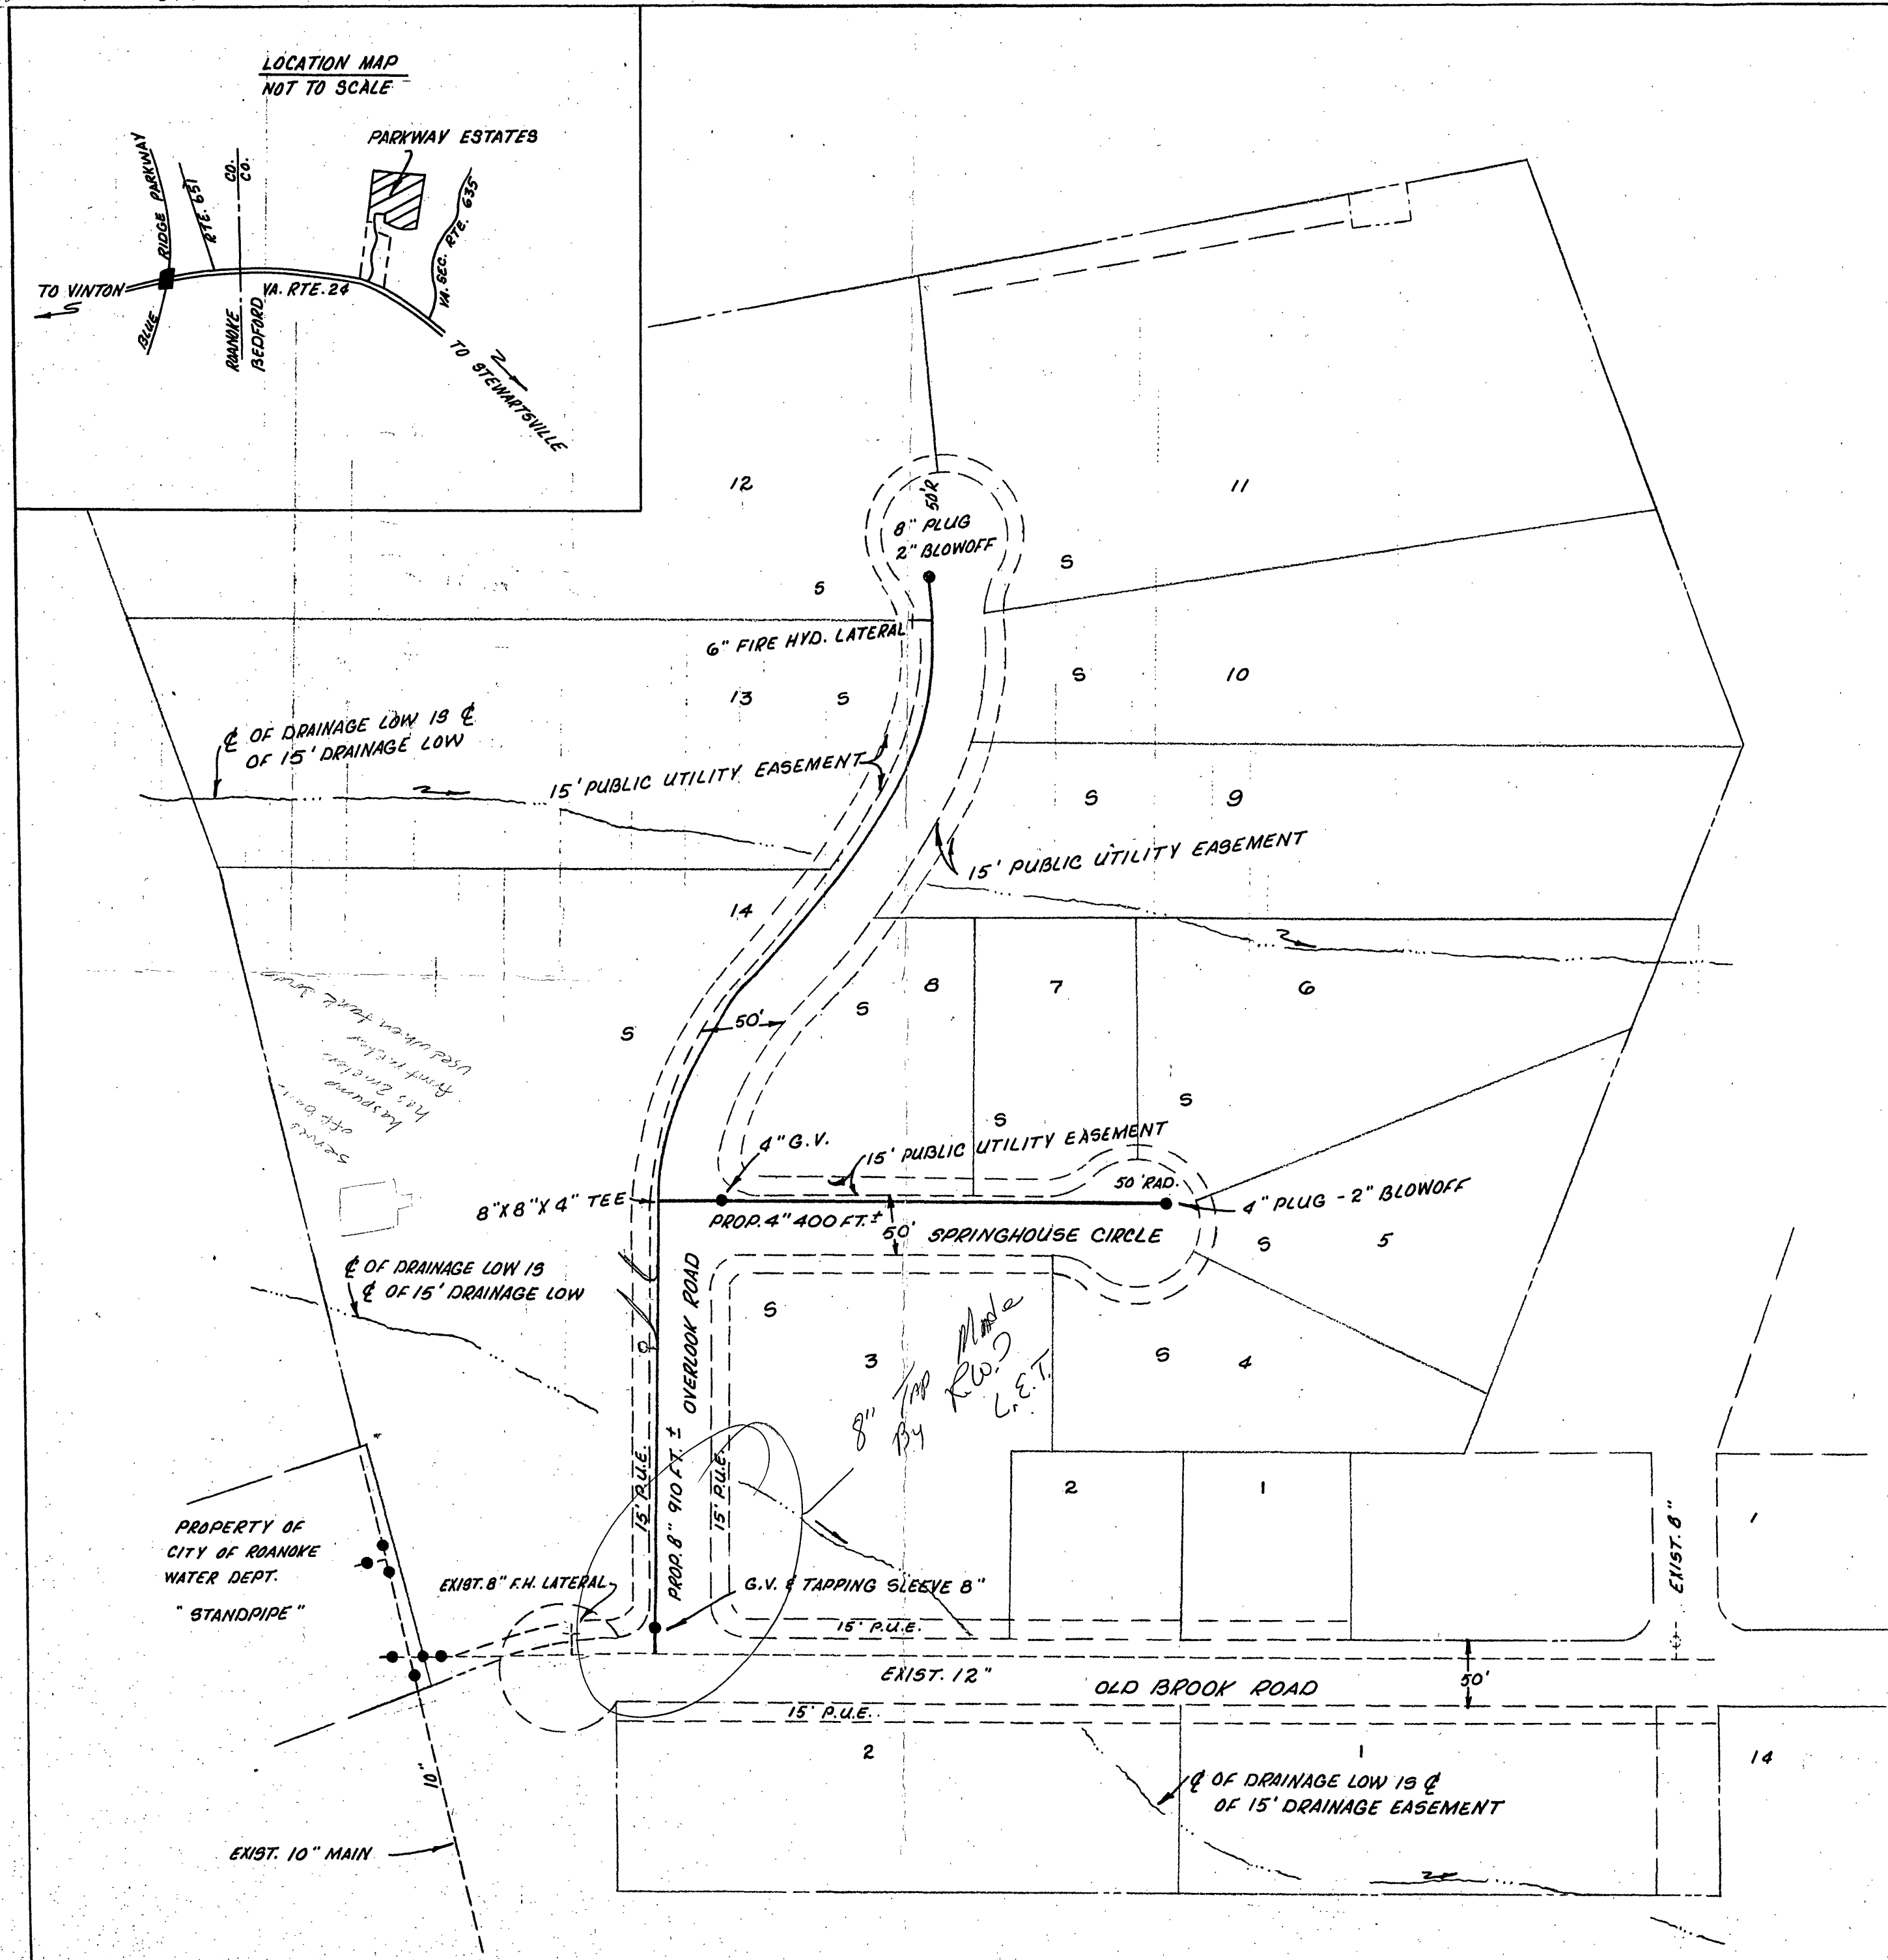


 MERIDIAN OF PARKWAY ESTATES, SEC. 1 P.B. 16, PG. 82

NOTES: EXISTING UTILITIES TO BE ASCERTAINED IN THE
FIELD PRIOR TO CONSTRUCTION.

ALL LOTS CAN BE SERVED FROM TANK. LOT 14
WOULD HAVE 22 PSI MIN. AT METER, ALL
OTHER LOTS 32 PSI

[illegible]

for City Engineer of Roanoke, Va.
William J. Kelly
DIRECTOR OF PUBLIC WORKS
AGENT FOR ROANOKE PLANNING COM.

Sept. 27, 1978
DATE
Sept. 28, 1978
DATE
Sept 27, 1978
DATE
SEPT. 27, 1978
DATE

DATE	REV.	DESCRIPTION	BY
			CITY ENGINEER
<i>PROPOSED WATER MAIN 8" 910 FT. ± AT OVERLOOK ROAD</i> <i>PROPOSED WATER MAIN 4" 400 FT. ± AT SPRINGHOUSE CIRCLE</i> <i>SCALE: 1" = 100'</i>			DRAWN M. COLSTON CHECKED C. HARLOW DESIGNED C. BLUSS DATE SEPT 27, 1978 JOB NO. 78-10 SHEET 1
CONTRACTOR MUST VERIFY ALL DIMENSIONS AT PROJECT BEFORE PROCEEDING WITH WORK			