

6.4'



Patrick Henry High School
As Built Coordinates - Based on Project plan Coordinate System
16 July 2021

Exist 6" Water Line






Return to Plan Location

6" 45° Elbow for Line & Elevation Change

6" Water Between 45° Elbows

6" 45° Elbow for Line & Elevation Change

Minor Adjustment to the West
Due to Existing Inline Tee and
Other Infrastructure including Power
Pole & Guy Wire in Sidewalk

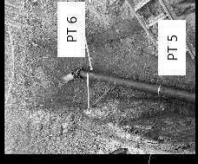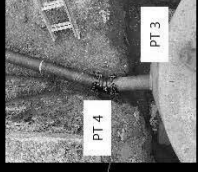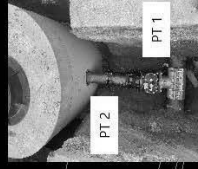

1. water line as built: 5045.334, 4708.130, 1049.550, 02/24/21 17:17:11, Top of NUT Valve at Tapping Sleeve
2. water line as built: 5047.566, 4708.505, 1048.362, 02/24/21 17:17:59, Top Pipe
3. water line as built: 5055.031, 4709.914, 1048.316, 02/24/21 17:18:19, Top Pipe
4. water line as built: 5056.668, 4710.317, 1048.437, 02/24/21 17:18:21, Top Pipe
5. water line as built: 5061.149, 4712.842, 1049.288, 02/24/21 17:19:07, Top Pipe
6. water line as built: 5065.970, 4715.619, 1050.341, 02/24/21 17:19:29, Top Pipe
7. water line as built: 5067.653, 4715.907, 1050.652, 02/24/21 17:19:41, Top Pipe