


Siterior tait, neireby certines that that the work shown hereon was completed in substantial accordance with the ing State, Municipal, Authority and or project specific standards and specifications. All materials conform with the rements within the same standards and specifications.

The locations of existing williny lines and or structures (if any) are approximate and furnished as a courtesy. They or be used for the purpose of deeign or construction. Any such use is at risk, and SitePro Inc., shall not be liable for

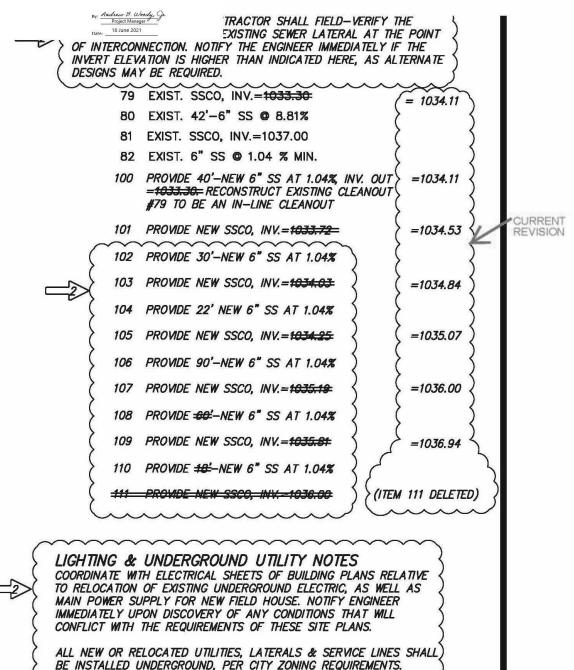

PATRICK HENRY FIELD HOUSE - FIELD REVISION TO PRIVATE SANITARY SEWER LATERAL REVISION REQUIRED DUE TO INVERT ELEVATION AT POINT OF INTERCONNECTION BEING 0.81 FEET HIGHER THAN ANTICIPATED. ALL SLOPES REMAIN PER PLAN, HOWEVER, THE POINT OF EXIT FROM THE BUILDING HAS BEEN REVISED TO THE PRACTICE FIELD SIDE DATE: 2020-12-23 PREPARED BY C.L. White - CWA SHEET 1 OF 2 (PORTION OF C-05)