


STARTED APRIL 24, 1996				
DATE COMP. JUNE 24, 1996				
FEET MAIN	SIZE	VALVE	VAULT	BOX
1656	6"	-	-	-
F.H. COMP. 3 4 1/2 6" P.C. #2				
C.H. STUB ONLY 0				
INS. BY: [Signature]				
MAIN INS. BY: [Signature]				
NO. 44 SERV. INS.				
CITY OR CO. City				
DEPT. WSP				

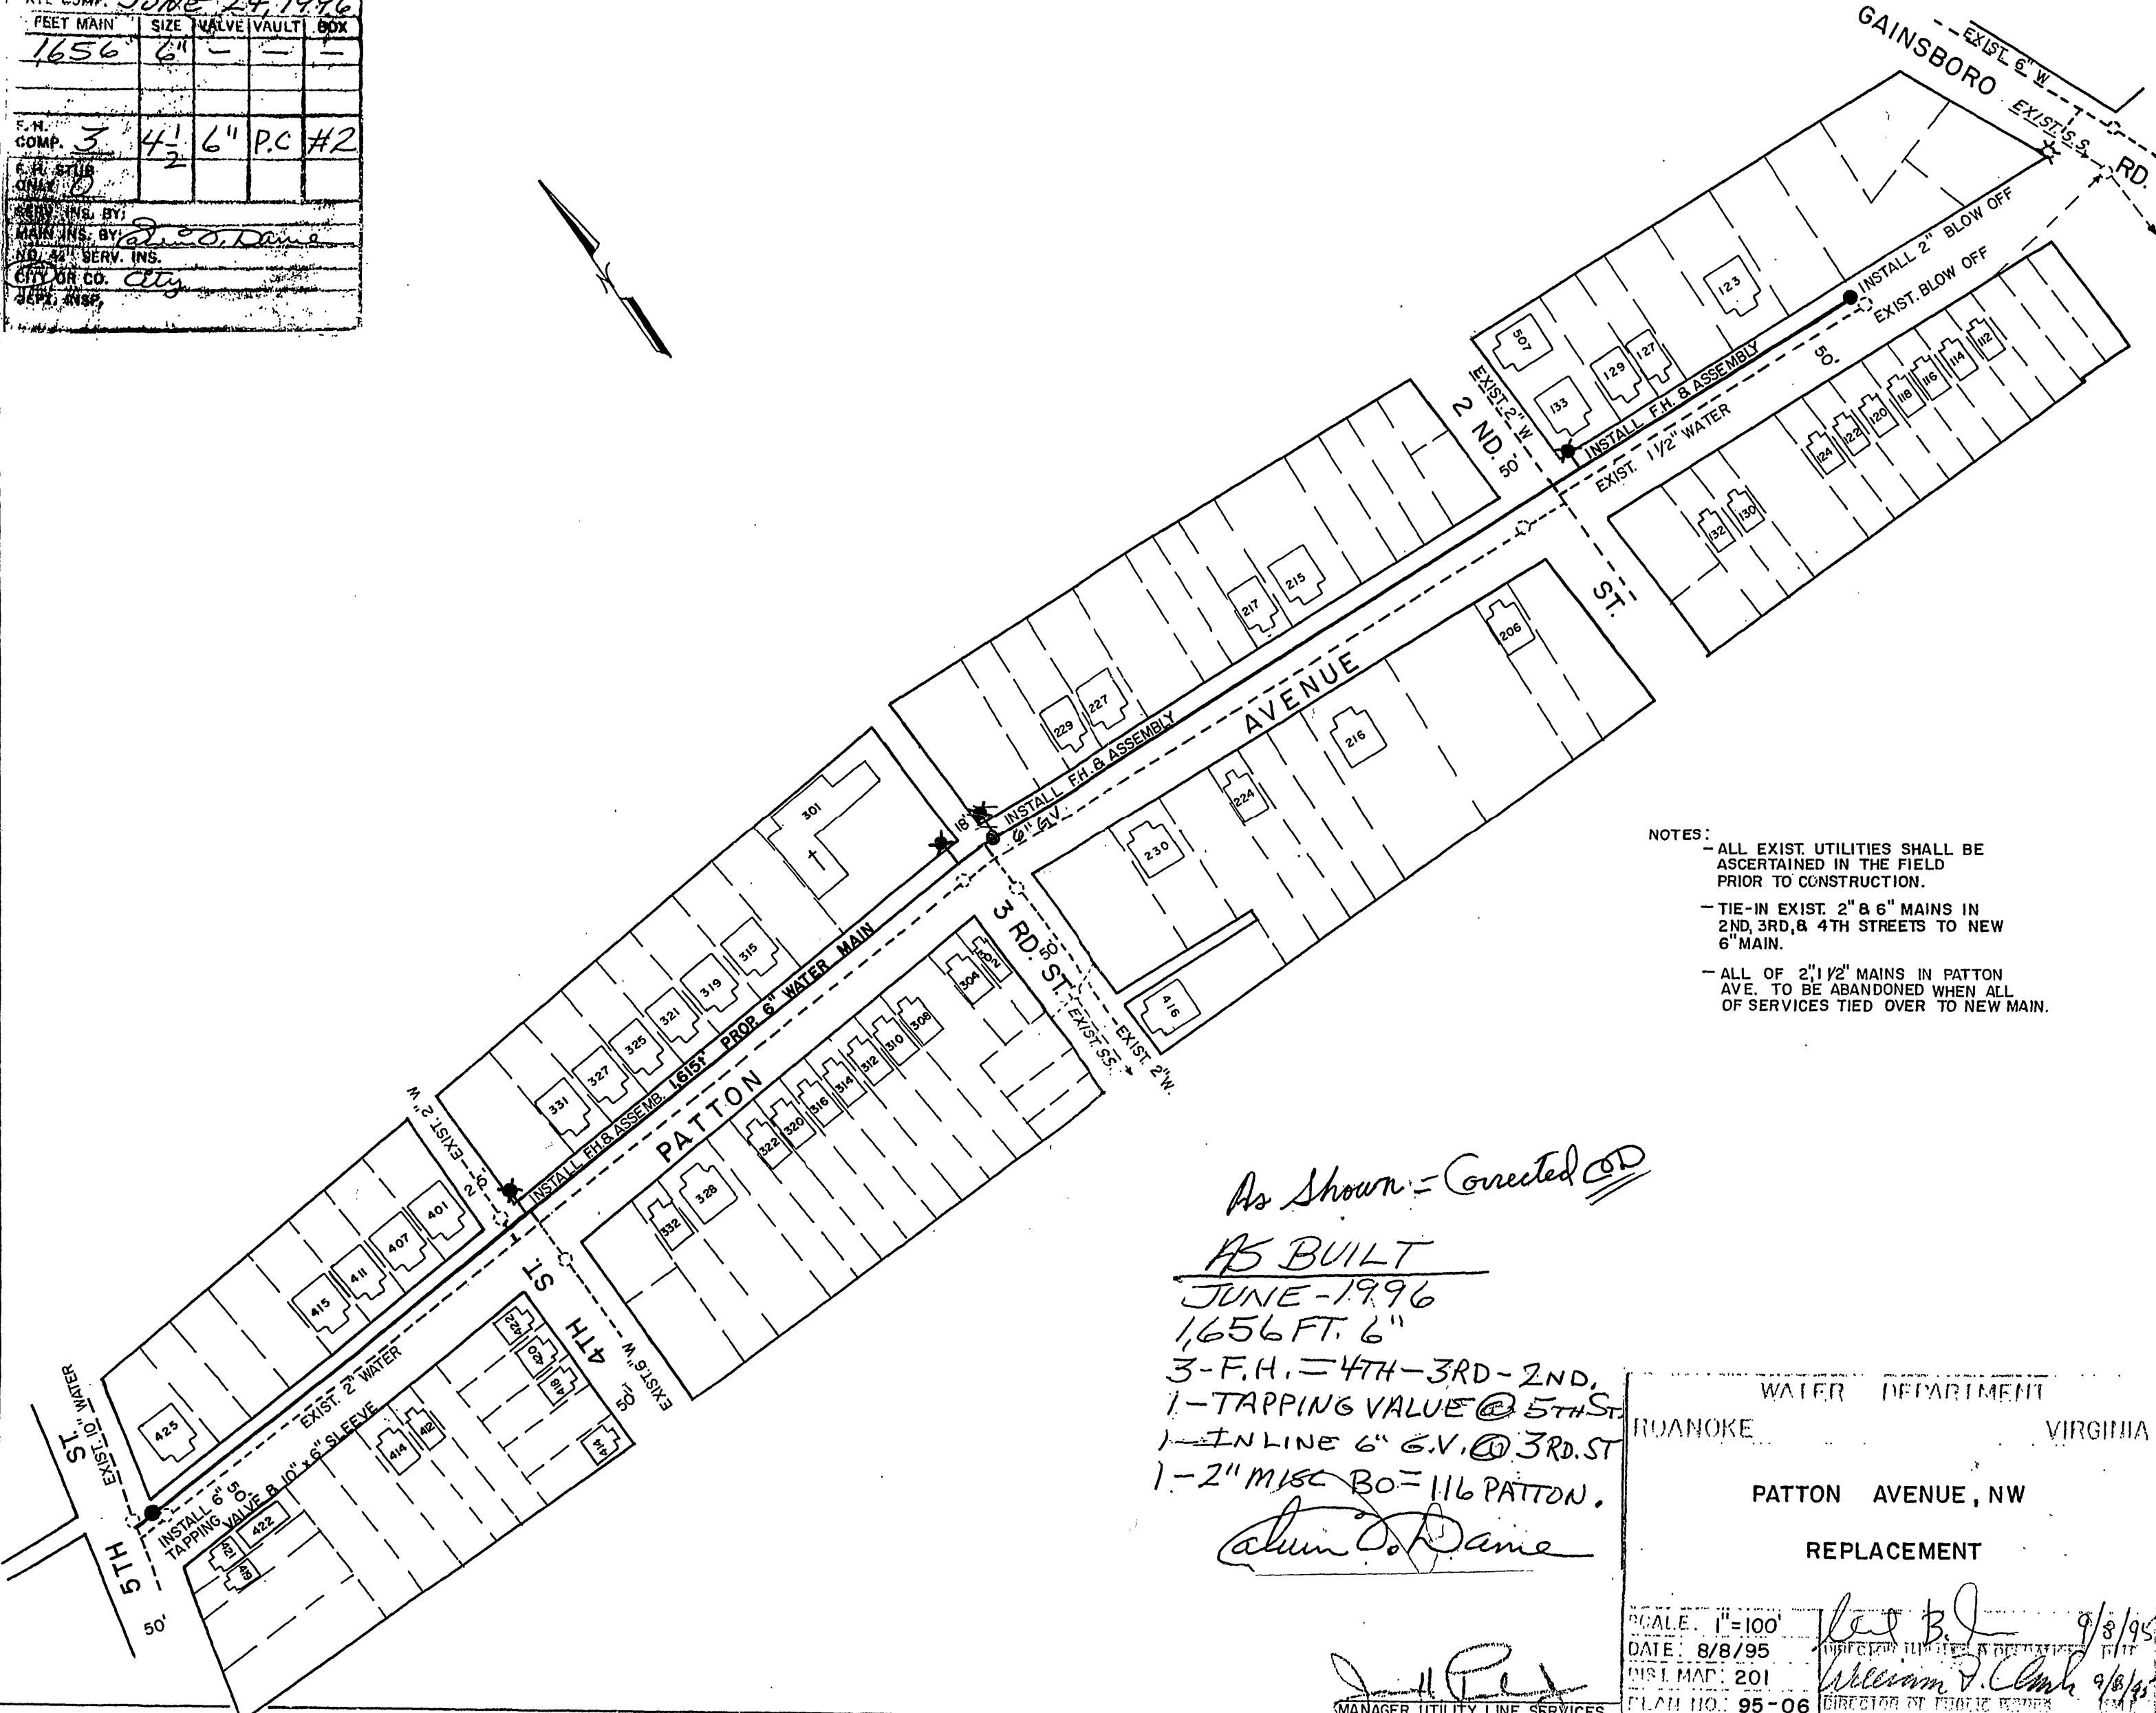

- NOTES:
- ALL EXIST. UTILITIES SHALL BE ASCERTAINED IN THE FIELD PRIOR TO CONSTRUCTION.
 - TIE-IN EXIST. 2" & 6" MAINS IN 2ND, 3RD, & 4TH STREETS TO NEW 6" MAIN.
 - ALL OF 2" 1/2" MAINS IN PATTON AVE. TO BE ABANDONED WHEN ALL OF SERVICES TIED OVER TO NEW MAIN.

As Shown = Corrected *CD*
AS BUILT
 JUNE-1996
 1,656 FT. 6"
 3-F.H. = 4TH-3RD-2ND,
 1-TAPPING VALVE @ 5TH ST
 1-INLINE 6" G.V. @ 3RD ST
 1-2" MISC BO = 116 PATTON.
Alvin D. Dame

WATER DEPARTMENT	
ROANOKE	VIRGINIA
PATTON AVENUE, NW	
REPLACEMENT	
SCALE: 1"=100'	DATE: 8/8/95
DIST. MAP: 201	PLAN NO.: 95-06
<i>[Signature]</i> 9/8/95 DIRECTOR OF PUBLIC WORKS	

[Signature]
 MANAGER UTILITY LINE SERVICES