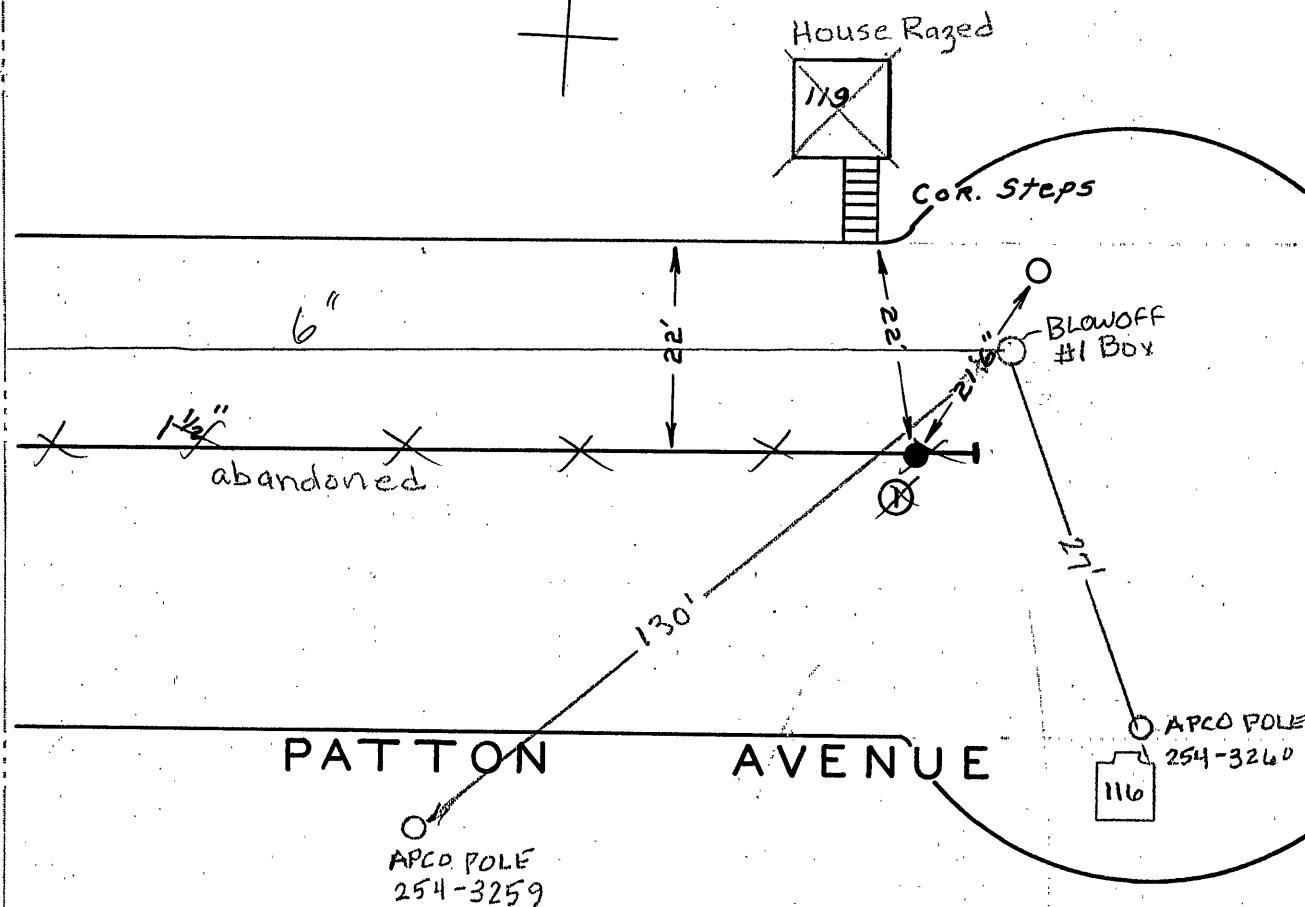


[illegible]

CITY OF ROANOKE — WATER DEPT.
VALVE DIAGRAM

PATTON AVE.
E. OF 2ND. STREET

SEC. MAP 201

N. W.

DATE: 11/17/2009

PAGE NO.