


PETERS CREEK RD.



234 — 13 PCS

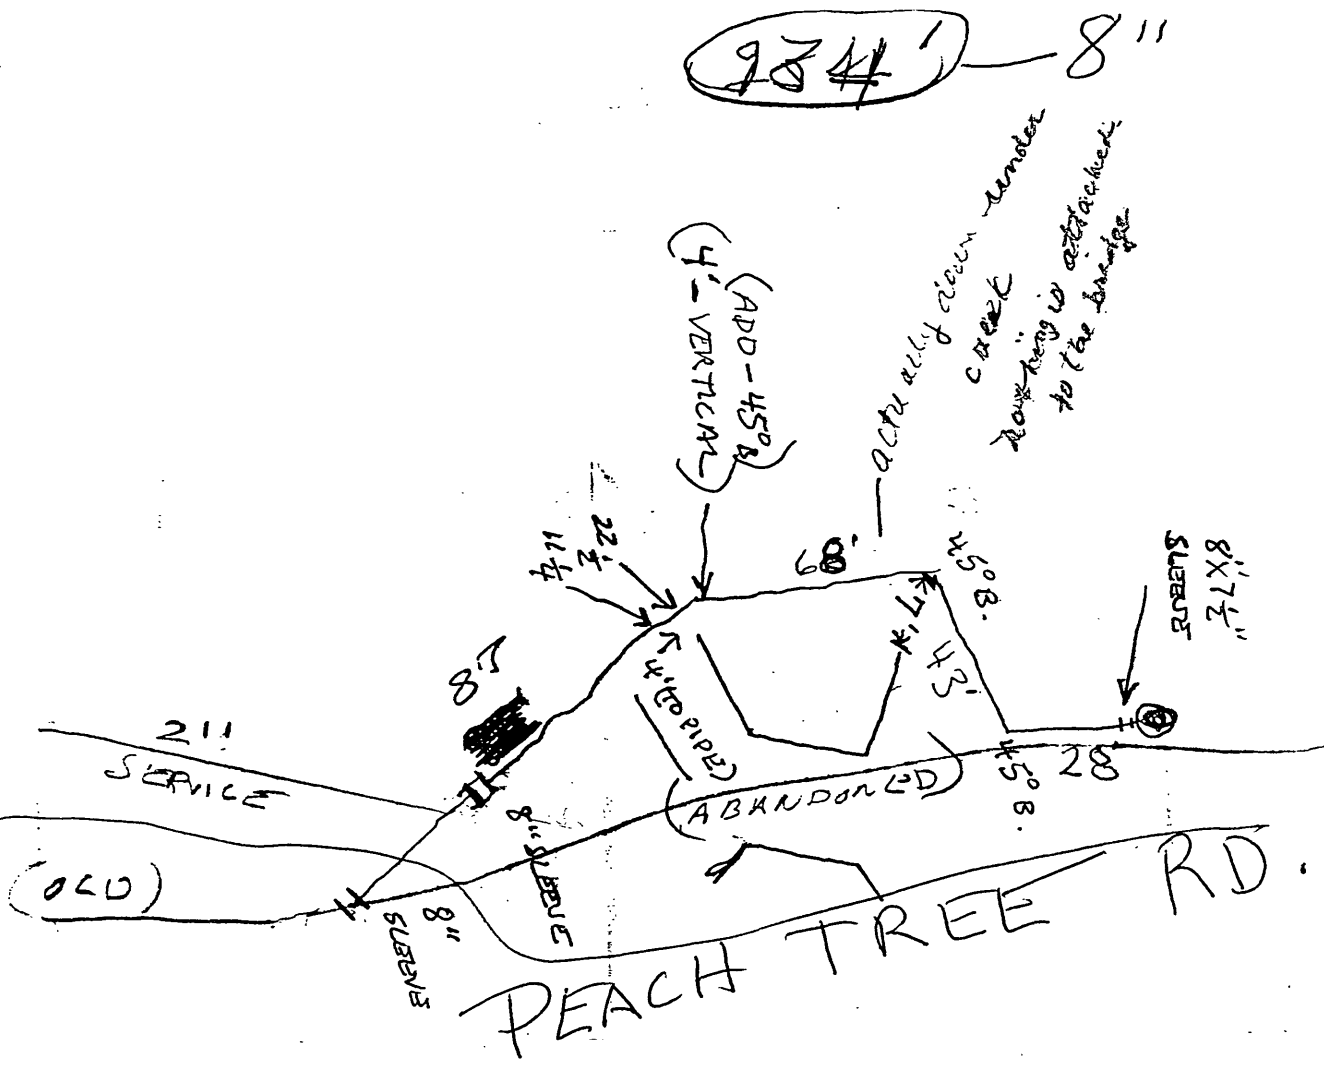

605-2-320-182-600400001

~~Replace Main (8")~~

AS BUILT — 234' — 8"

PEACH TREE RD.

① PETERS CREEK
UNDER BRIDGE / CREEK
O. D. Dain