


**PEAKWOOD DRIVE
WATERLINE REPLACEMENTS**
PREPARED FOR
WESTERN VIRGINIA WATER AUTHORITY
STATIONED IN
THE CITY OF HOANKE, VIRGINIA



**PLAN & PROFILE
PEAKWOOD DRIVE
(STA. 1+00 - 6+50)**

Lumsden Associates, P.C.
ENGINEERS | SURVEYORS | PLANNERS
1000 BOWLING GREEN AVENUE
SUITE 200
HOANKE, VIRGINIA 22060
PHONE (540) 773-9443
WWW.LUMSDENPC.COM

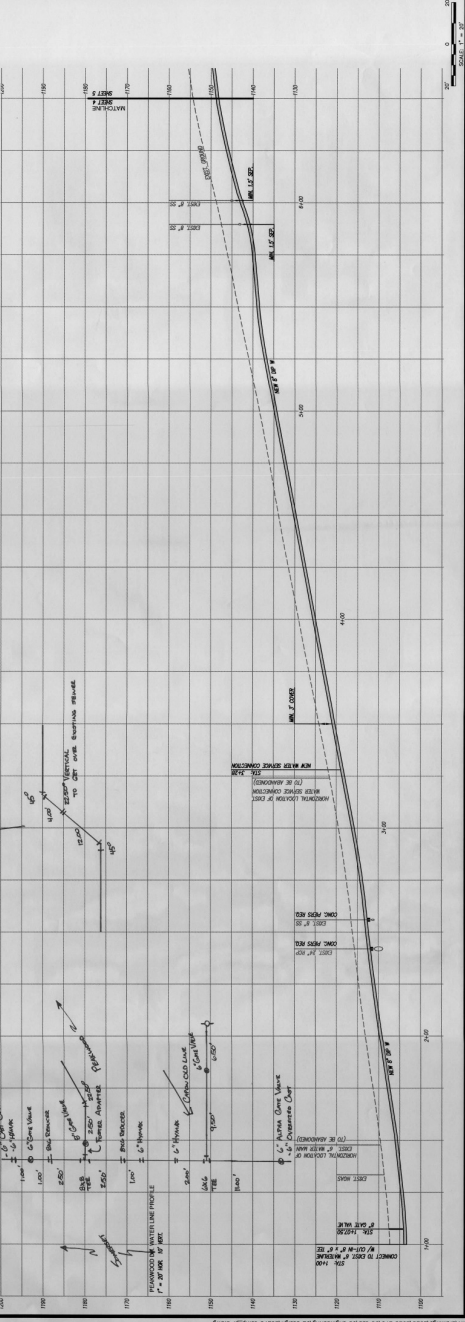