




NOTES:
1. THIS PLAN IS A PART OF THE PROJECT AND IS NOT TO BE USED FOR ANY OTHER PURPOSE.
2. THE WATERLINE IS SHOWN IN RED DOTS FROM THE WATERLINE ASSEMBLY.
3. THE WATERLINE IS SHOWN IN RED DOTS FROM THE WATERLINE ASSEMBLY.
4. THE WATERLINE IS SHOWN IN RED DOTS FROM THE WATERLINE ASSEMBLY.
5. THE WATERLINE IS SHOWN IN RED DOTS FROM THE WATERLINE ASSEMBLY.
6. THE WATERLINE IS SHOWN IN RED DOTS FROM THE WATERLINE ASSEMBLY.
7. THE WATERLINE IS SHOWN IN RED DOTS FROM THE WATERLINE ASSEMBLY.
8. THE WATERLINE IS SHOWN IN RED DOTS FROM THE WATERLINE ASSEMBLY.
9. THE WATERLINE IS SHOWN IN RED DOTS FROM THE WATERLINE ASSEMBLY.
10. THE WATERLINE IS SHOWN IN RED DOTS FROM THE WATERLINE ASSEMBLY.

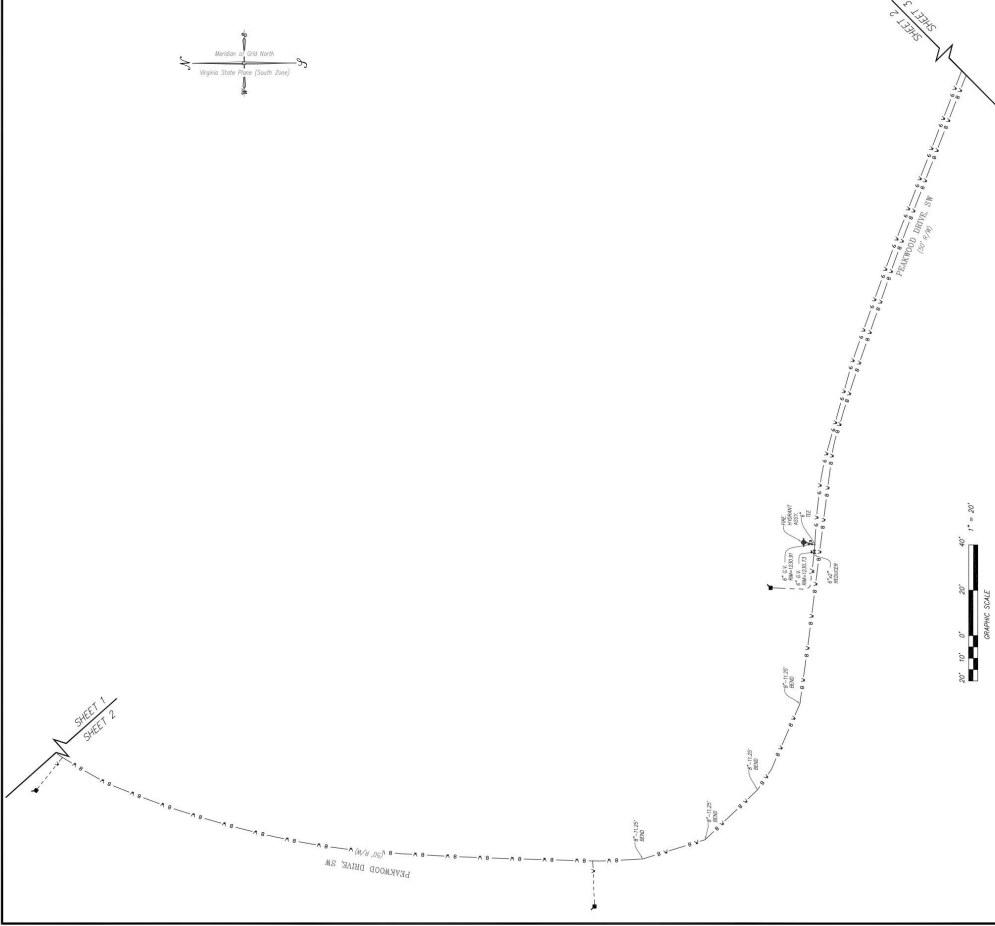

- LEGEND
- CUT FOR WALK ROW
 - ONE-PIECE ASSEMBLY
 - WATER METER
 - WATER MILE

WATERLINE AS-BUILT SURVEY
FOR
JACK ST. CLAIR INC.
SHOWING WATERLINE IMPROVEMENTS
SITUATE AT THE INTERSECTION OF WATER STREET, S.E.
CITY OF INDIANAPOLIS, INDIANA

Drawn: J. C. Noy
Checked: J. C. Noy
Scale: 1" = 40'
Date: 10/1/2023
Sheet: 2 of 2

CWA
Caldwell White Associates
14101 N. WINDYBROOK, SUITE 100
INDIANAPOLIS, INDIANA 46240
Phone: (317) 251-1111
Fax: (317) 251-1112
Email: info@cwa.com

SHEET 2