
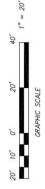


LEGEND

	CAST IRON VALVE BOX
	FIRE HYDRANT ASSEMBLY
	WATER METER
	WATER VALVE

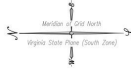

SHEET 4

SHEET 5



WATERLINE AS-BUILT SURVEY
FOR
JACK ST. CLAIR INC.
SHOWING WATERLINE IMPROVEMENTS
SITUATE AT PEAKWOOD DRIVE, S.W. & EXETER STREET, S.W.

SITUATE AT PEAKWOOD DRIVE, S.W. & EXETER STREET, S.W.

Drawn	CL Refd
Ordered	#2 Colored
Date	NOVEMBER 7, 2023
Scale	1"=20'
Per Sheet	WS04
Field Book	WS04 4