
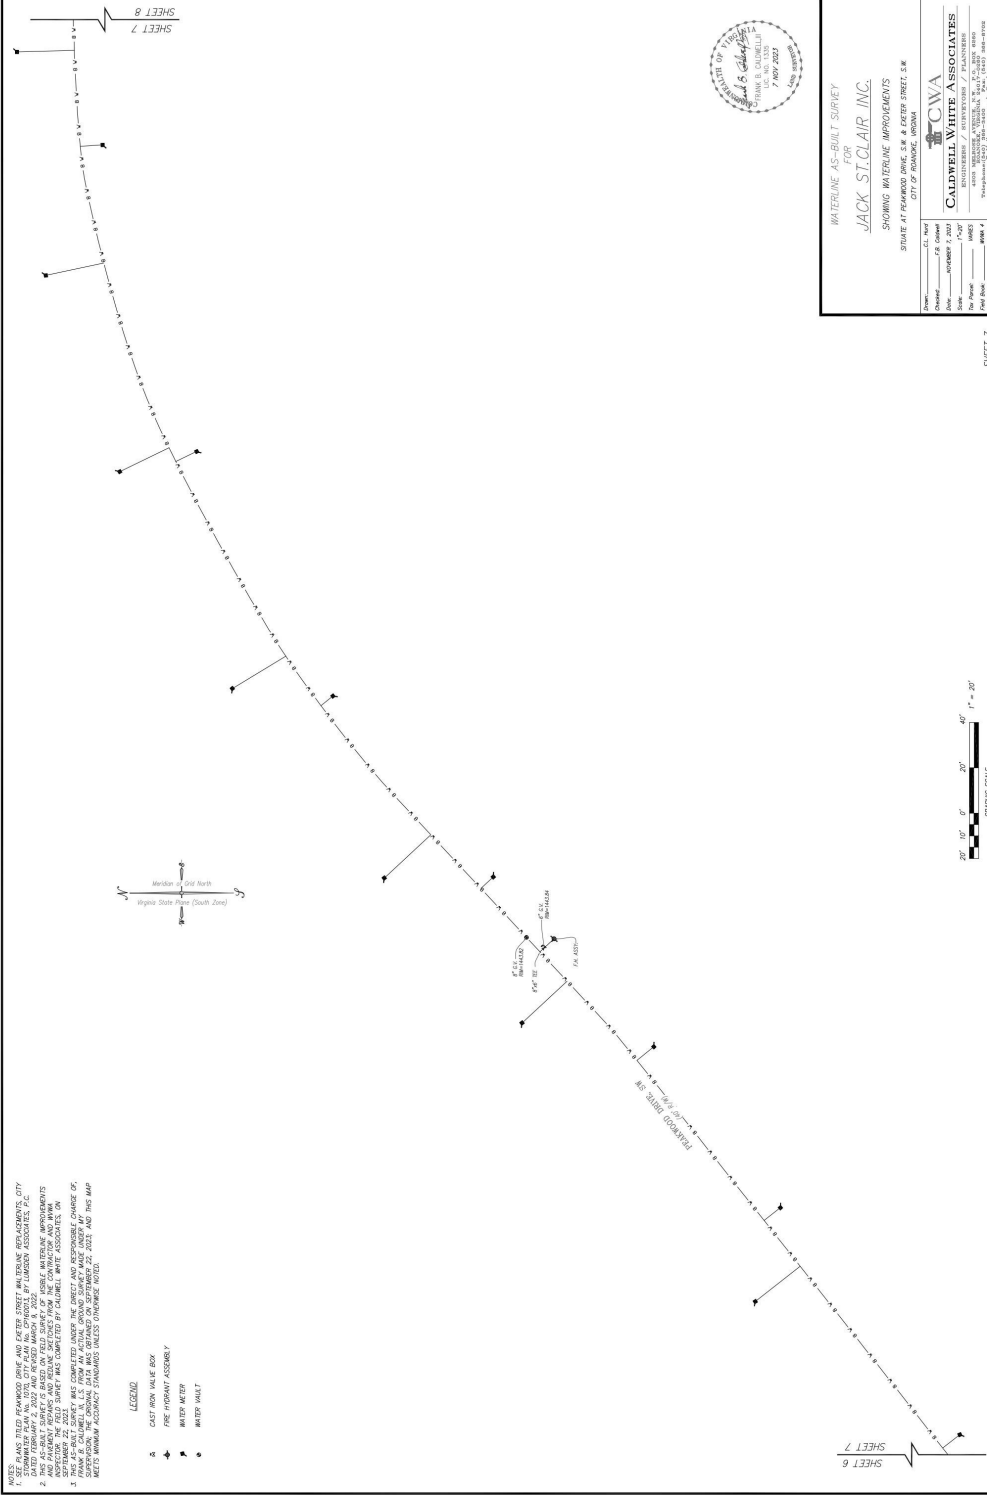


LEGEND

	CAST IRON VALVE BOX
	FIRE HYDRANT ASSEMBLY
	WATER METER
	WATER VALVE

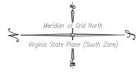

SHEET 6
SHEET 7

WATERLINE AS-BUILT SURVEY
FOR
JACK ST. CLAIR INC.
SHOWING WATERLINE IMPROVEMENTS
LOCATED AT PEAKWOOD DRIVE, S.W. & EXETER STREET, S.W.

TUATE AT PEAKWOOD DRIVE, S.W. & EXETER STREET, S.W.

Drawn:	C.L. Huff
Checked:	F.R. Conrad
Date:	NOVEMBER 2, 2023
Scale:	1"=30'
Per Permit:	14025
Field Book:	#204 4