


LEGEND

	CAST IRON VALVE BOX
	FIRE HYDRANT ASSEMBLY
	WATER METER
	WATER VALVE

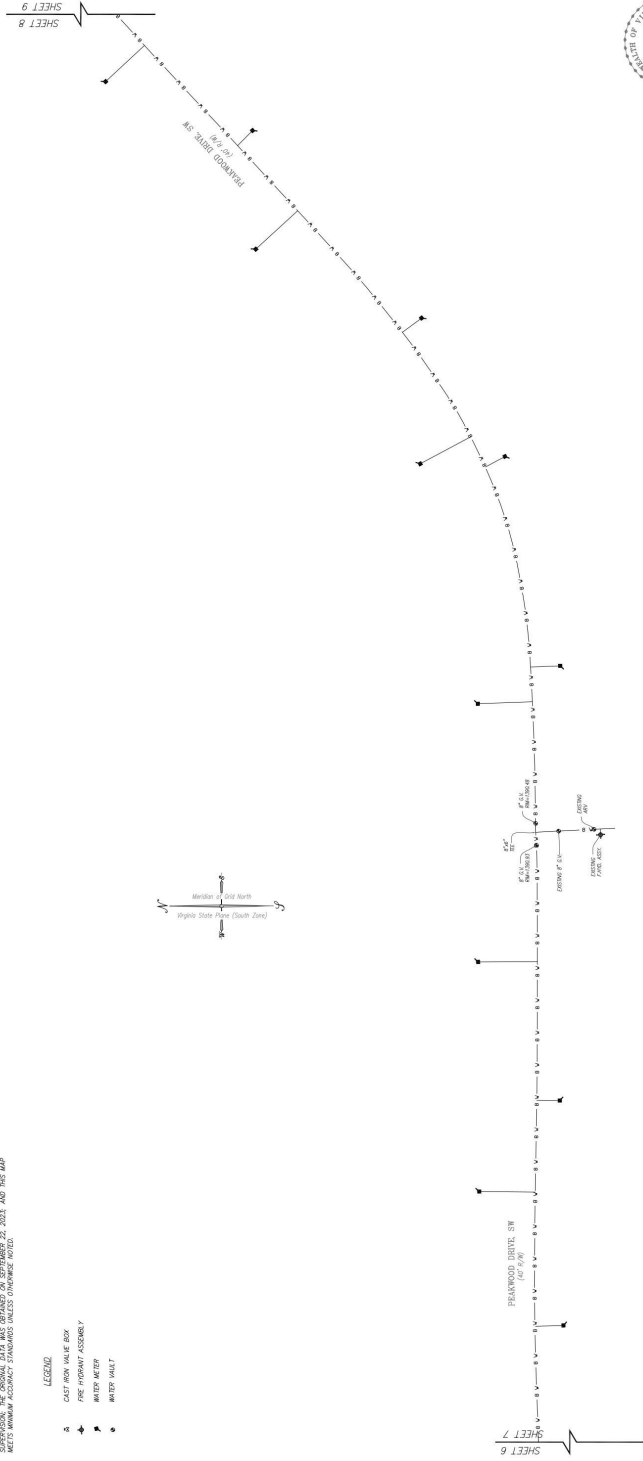

WATERLINE AS-BUILT SURVEY
FOR
JACK ST. CLAIR INC.
SHOWING WATERLINE IMPROVEMENTS
SITUATE AT PEAKWOOD DRIVE, S.W. & EXETER STREET, S.W.


CALDWELL WHITE ASSOCIATES
 ENGINEERS / SURVEYORS / PLANNERS
 4505 MONROE AVENUE, SUITE 200, DALLAS, TEXAS 75206
 Telephone (214) 359-3400 Fax (214) 359-8702

GRAPHIC SCALE