


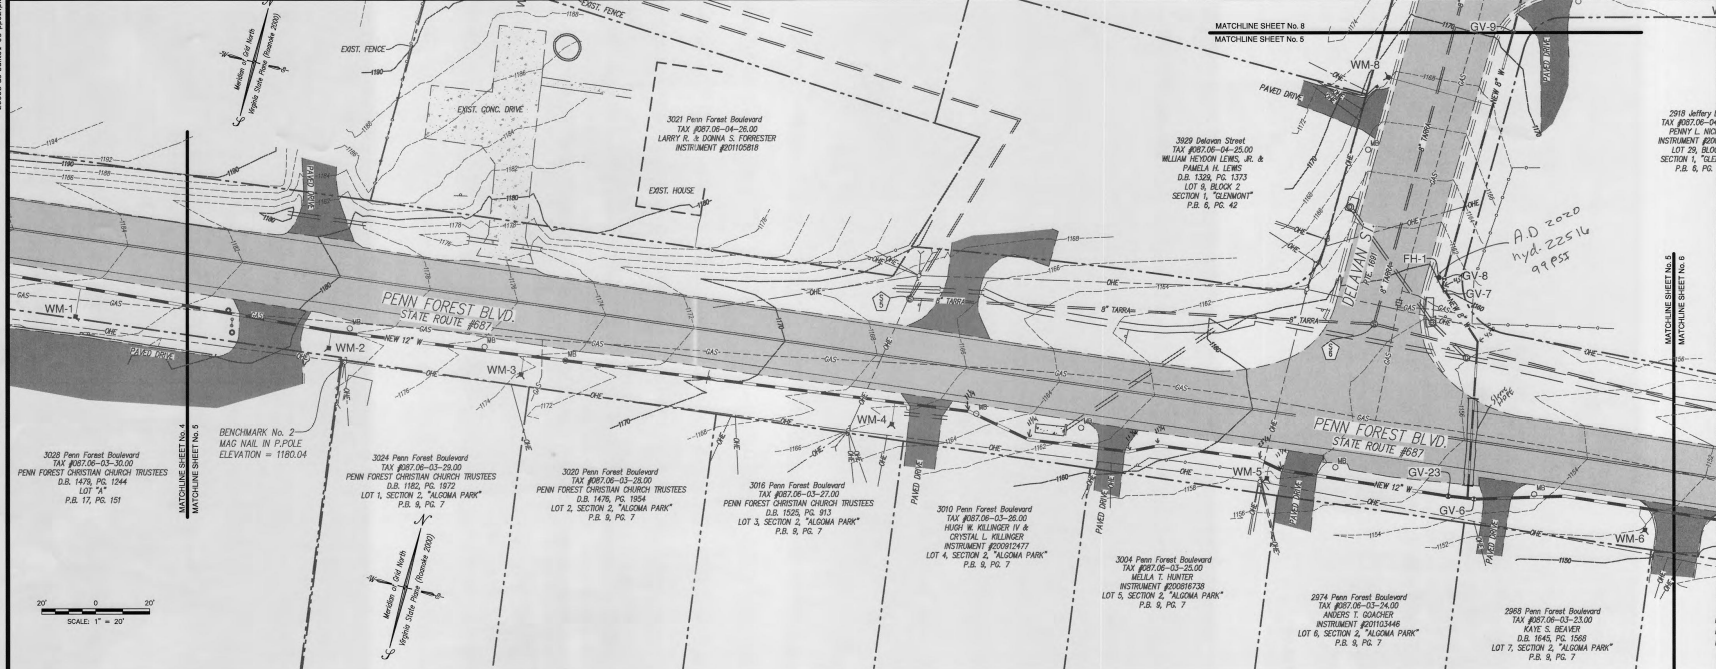

SURVEY CONTROL PROVIDED / UTILIZED:
BENCHMARK No. 2
ELEVATION = 1160.04
BY LUMSDEN ASSOCIATES, P.C. OR AS
SUPPLIED BY MENDON PIPELINE, INC.
(CONTRACTOR) FIELD MARKS

AS-BUILT
AS-BUILT INFORMATION SHOWN ON
THIS PLAN IS THE RESULT OF A FIELD
SURVEY PERFORMED
BY LUMSDEN ASSOCIATES, P.C. OR AS
SUPPLIED BY MENDON PIPELINE, INC.
(CONTRACTOR) FIELD MARKS

NOTE:
CONTRACTOR AS-BUILT FIELD MARKS AS SUPPLIED BY MENDON PIPELINE, INC.
INDICATED NO VERTICAL DEVIATIONS FROM THE ORIGINAL PLANS. SEE SHEET 2
FOR FIELD SURVEYED INDIVIDUAL WATERLINE APPURTENANCE ELEVATIONS.

2018 Jeffrey
TAX #087-06-04
PENNY L. HILL
INSTRUMENT #204
LOT 29, BLOCK
SECTION 1, "ALGOMA PARK"
P.B. & PG. 7

3029 Delavan Street
TAX #087-06-04-25.00
WILLIAM HEDSON LEWIS, JR. &
PAMELA H. LEWIS
D.B. 1508, PG. 173
LOT 8, BLOCK 2
SECTION 1, "GLENMONT"
P.B. & PG. 42

A.D. 2020
hyd. 225.14
99 P.S.

Lumsden Associates, P.C.
ENGINEERS | SURVEYORS | PLANNERS


PLAN & PROFILE

**PENN FOREST/ GLENMONT
WATERLINE REPLACEMENTS**
PREPARED FOR
WESTERN VIRGINIA WATER AUTHORITY
SITUATED IN
ROANOKE COUNTY, VIRGINIA

NO.	DATE	REVISIONS	DESCRIPTION

DATE: May 18, 2021
SCALE: 1" = 20'
COMMISSION NO: 20-008
SHEET 5 OF 11