




SURVEY CONTROL PROVIDED / UTILIZED:

AS-BUILT

NOTE:
CONTRACTOR AS-BUILT FIELD MARKUPS AS SUPPLIED BY MENDON PIPELINE, INC
INDICATED NO VERTICAL DEVIATIONS FROM THE ORIGINAL PLANS. SEE SHEET 2
FOR FIELD SURVEYED INDIVIDUAL WATERLINE APPURTENANCE ELEVATIONS.

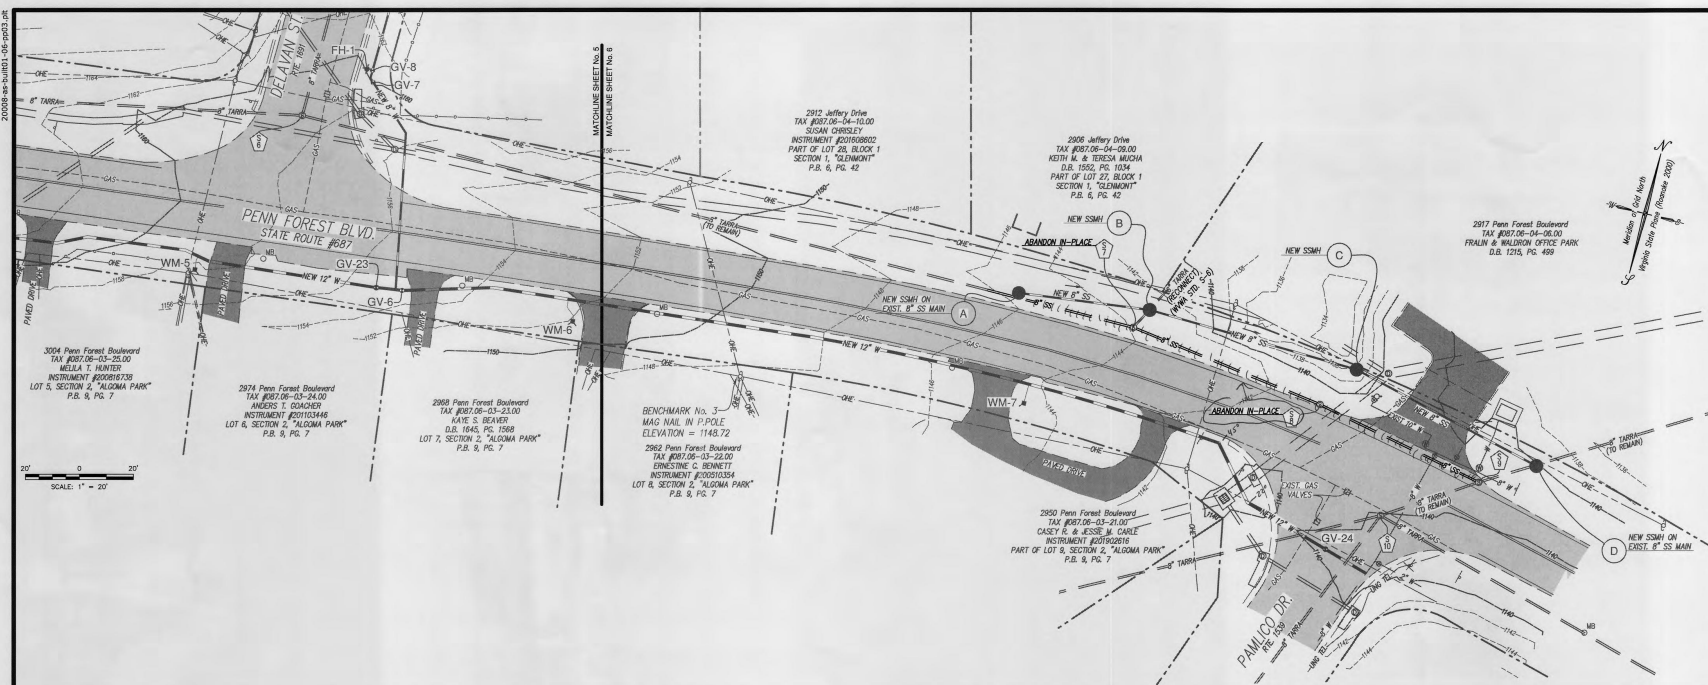