


200808-00-0001-00-0001.dwg

w:\mappings\2020\2020-0001-00-0001.dwg

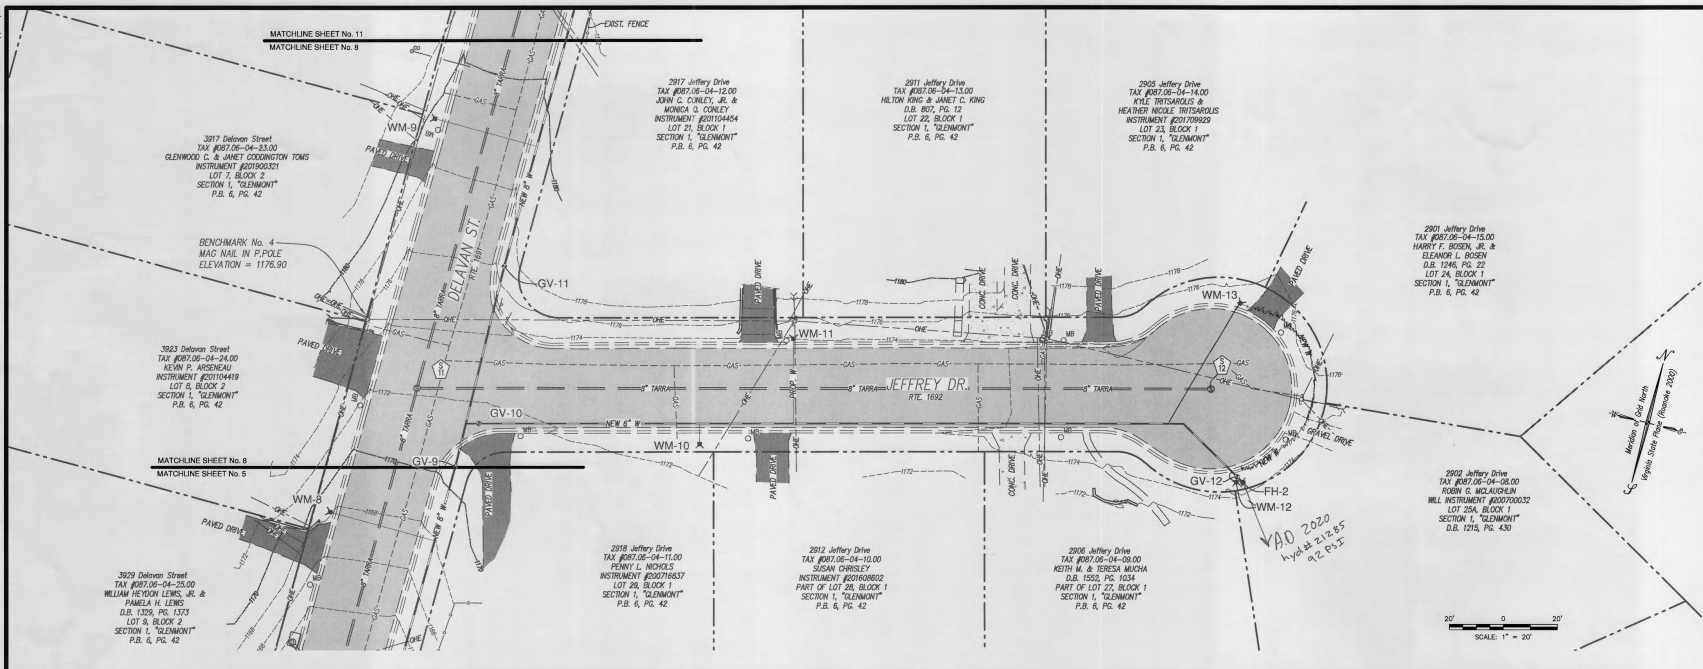

SURVEY CONTROL PROVIDED / UTILIZED:

▲ BENCHMARK No. 4
NOTHING - LGSJUN.00010
EATING 11947.261.00010
ELEVATION: 1176.90

AS-BUILT

AS-BUILT INFORMATION SHOWN ON
THIS PLAN IS THE RESULT OF A FIELD
SURVEY PERFORMED
BY LUMSDEN ASSOCIATES, P.C. OR AS
SUPPLIED BY MENDON PIPELINE, INC.
(CONTRACTOR) FIELD MARKS.

NOTE:

CONTRACTOR AS-BUILT FIELD MARKS AS SUPPLIED BY MENDON PIPELINE, INC.
INDICATED NO VERTICAL DEVIATIONS FROM THE ORIGINAL PLANS. SEE SHEET 2
FOR FIELD SURVEYED INDIVIDUAL WATERLINE APPROPRIATE ELEVATIONS.

Lumsden Associates, P.C.
ENGINEERS | SURVEYORS | PLANNERS



PLAN & PROFILE

**PENN FOREST/ GLENMONT
WATERLINE REPLACEMENTS**

PREPARED FOR
WESTERN VIRGINIA WATER AUTHORITY
SITUATED IN
ROANOKE COUNTY, VIRGINIA

NO.	DATE	REVISIONS	DESCRIPTION
1			
2			
3			
4			
5			

DATE: May 18, 2021

SCALE: 1" = 20'

COMMISSION NO: 20-008

SHEET 8 OF 11

PHONE: (540) 774-4411
FAX: (540) 774-4412
WWW.LUMSDEN-PC.COM

4464 BRIMBLETON AVENUE
SUITE 200
ROANOKE, VIRGINIA 24018