


2008-05-01 10:00:00

w:\dms\penn\2020\2020-008\01_cad\01_engineering\24-as-built\2008-as-built.dwg

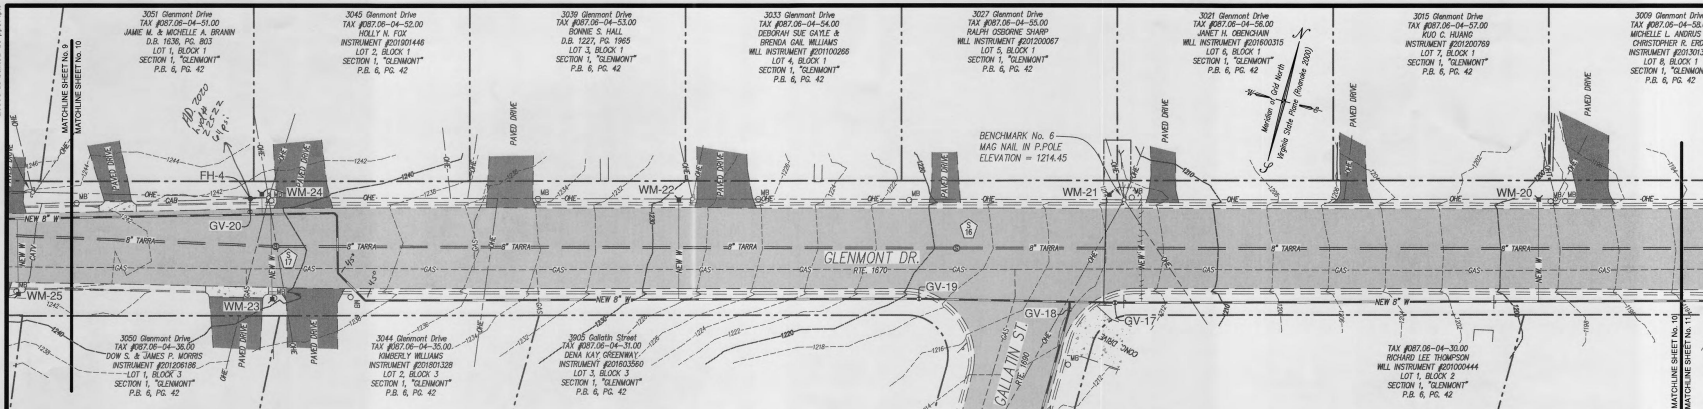

SURVEY CONTROL PROVIDED / UTILIZED:

▲ BENCHMARK No. 6
NORTHING: 1305.000.2870
EASTING: 1042.558.8940
ELEVATION: 1214.45

AS-BUILT

AS-BUILT INFORMATION SHOWN ON THIS PLAN IS THE RESULT OF A FIELD SURVEY PERFORMED BY LUMSDEN ASSOCIATES, P.C. OR AS SUPPLIED BY MENDON PIPELINE, INC. (CONTRACTOR) FIELD MARKS.

NOTE:

CONTRACTOR AS-BUILT FIELD MARKS AS SUPPLIED BY MENDON PIPELINE, INC. INDICATED NO VERTICAL DEVIATIONS FROM THE ORIGINAL PLANS. SEE SHEET 2 FOR FIELD SURVEYED INDIVIDUAL WATERLINE APPURTENANCE ELEVATIONS.

20' 0' 20'
SCALE: 1" = 20'

Lumsden Associates, P.C.
ENGINEERS | SURVEYORS | PLANNERS
4664 BRANLITON AVENUE
P.O. BOX 2008
ROANOKE, VIRGINIA 24018
PHONE: (540) 774-4411
FAX: (540) 772-5445
WWW.LUMSDEN-PC.COM



PLAN & PROFILE

**PENN FOREST/ GLENMONT
WATERLINE REPLACEMENTS**
PREPARED FOR
WESTERN VIRGINIA WATER AUTHORITY
SITUATED IN
ROANOKE COUNTY, VIRGINIA

REVISIONS	DATE	DESCRIPTION
1		
2		
3		
4		
5		

DATE: May 18, 2021
SCALE: 1" = 20'
COMMISSION NO: 20-008
SHEET 10 OF 11