

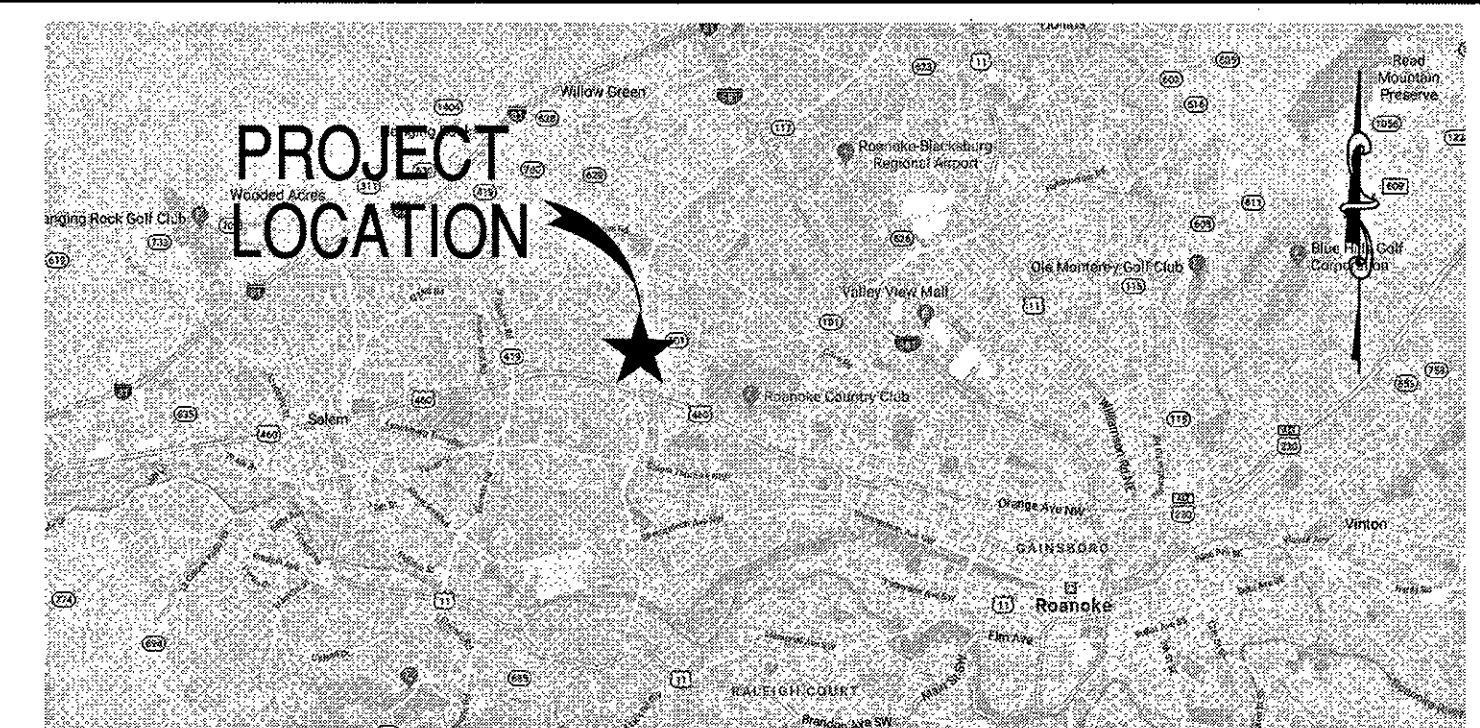


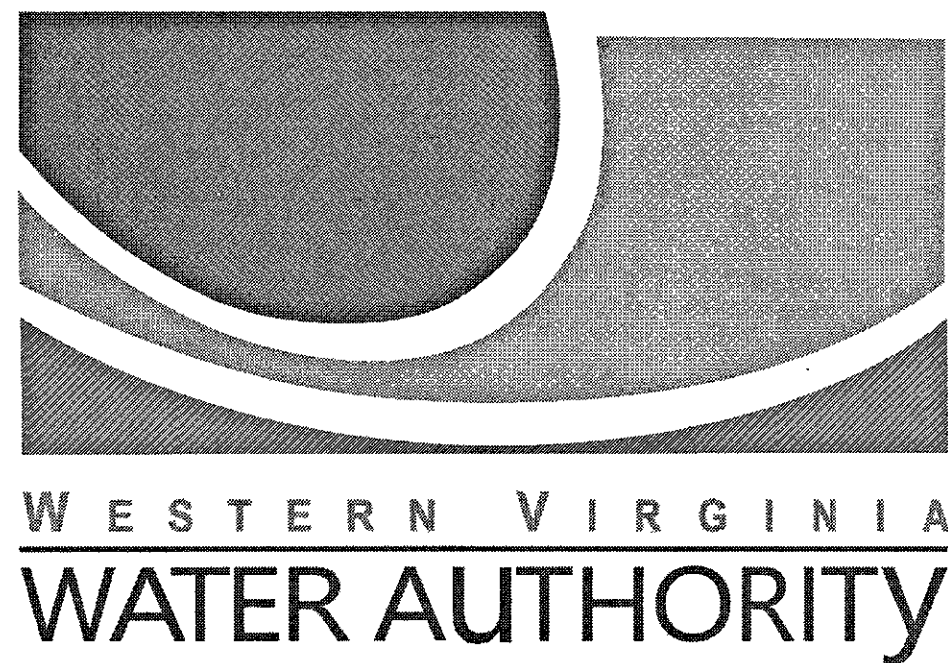

LOCATION PLAN
NO SCALE

WESTERN VIRGINIA WATER AUTHORITY PETERS CREEK ROAD WATER MAIN REPLACEMENT, PHASE 2

SHEET	TITLE
1.	COVER
2.	GENERAL NOTES & PROPOSED LEGEND
3.	SURVEY SCHEDULES, NOTES, & EXISTING LEGEND
4.	SHEET LAYOUT & FIRE HYDRANT COVERAGE MAP
5.	PLAN - PROFILE, STA. 10+00 TO STA. 15+55
6.	PLAN - PROFILE, STA. 15+55 TO STA. 21+03
7.	PLAN - PROFILE, STA. 21+03 TO STA. 25+78
8.	TEMPORARY TRAFFIC CONTROL PLAN NOTES
9.	TEMPORARY TRAFFIC CONTROL PLAN FIGURE 1
10.	TEMPORARY TRAFFIC CONTROL PLAN FIGURE 3
11.	TEMPORARY TRAFFIC CONTROL PLAN FIGURE 4

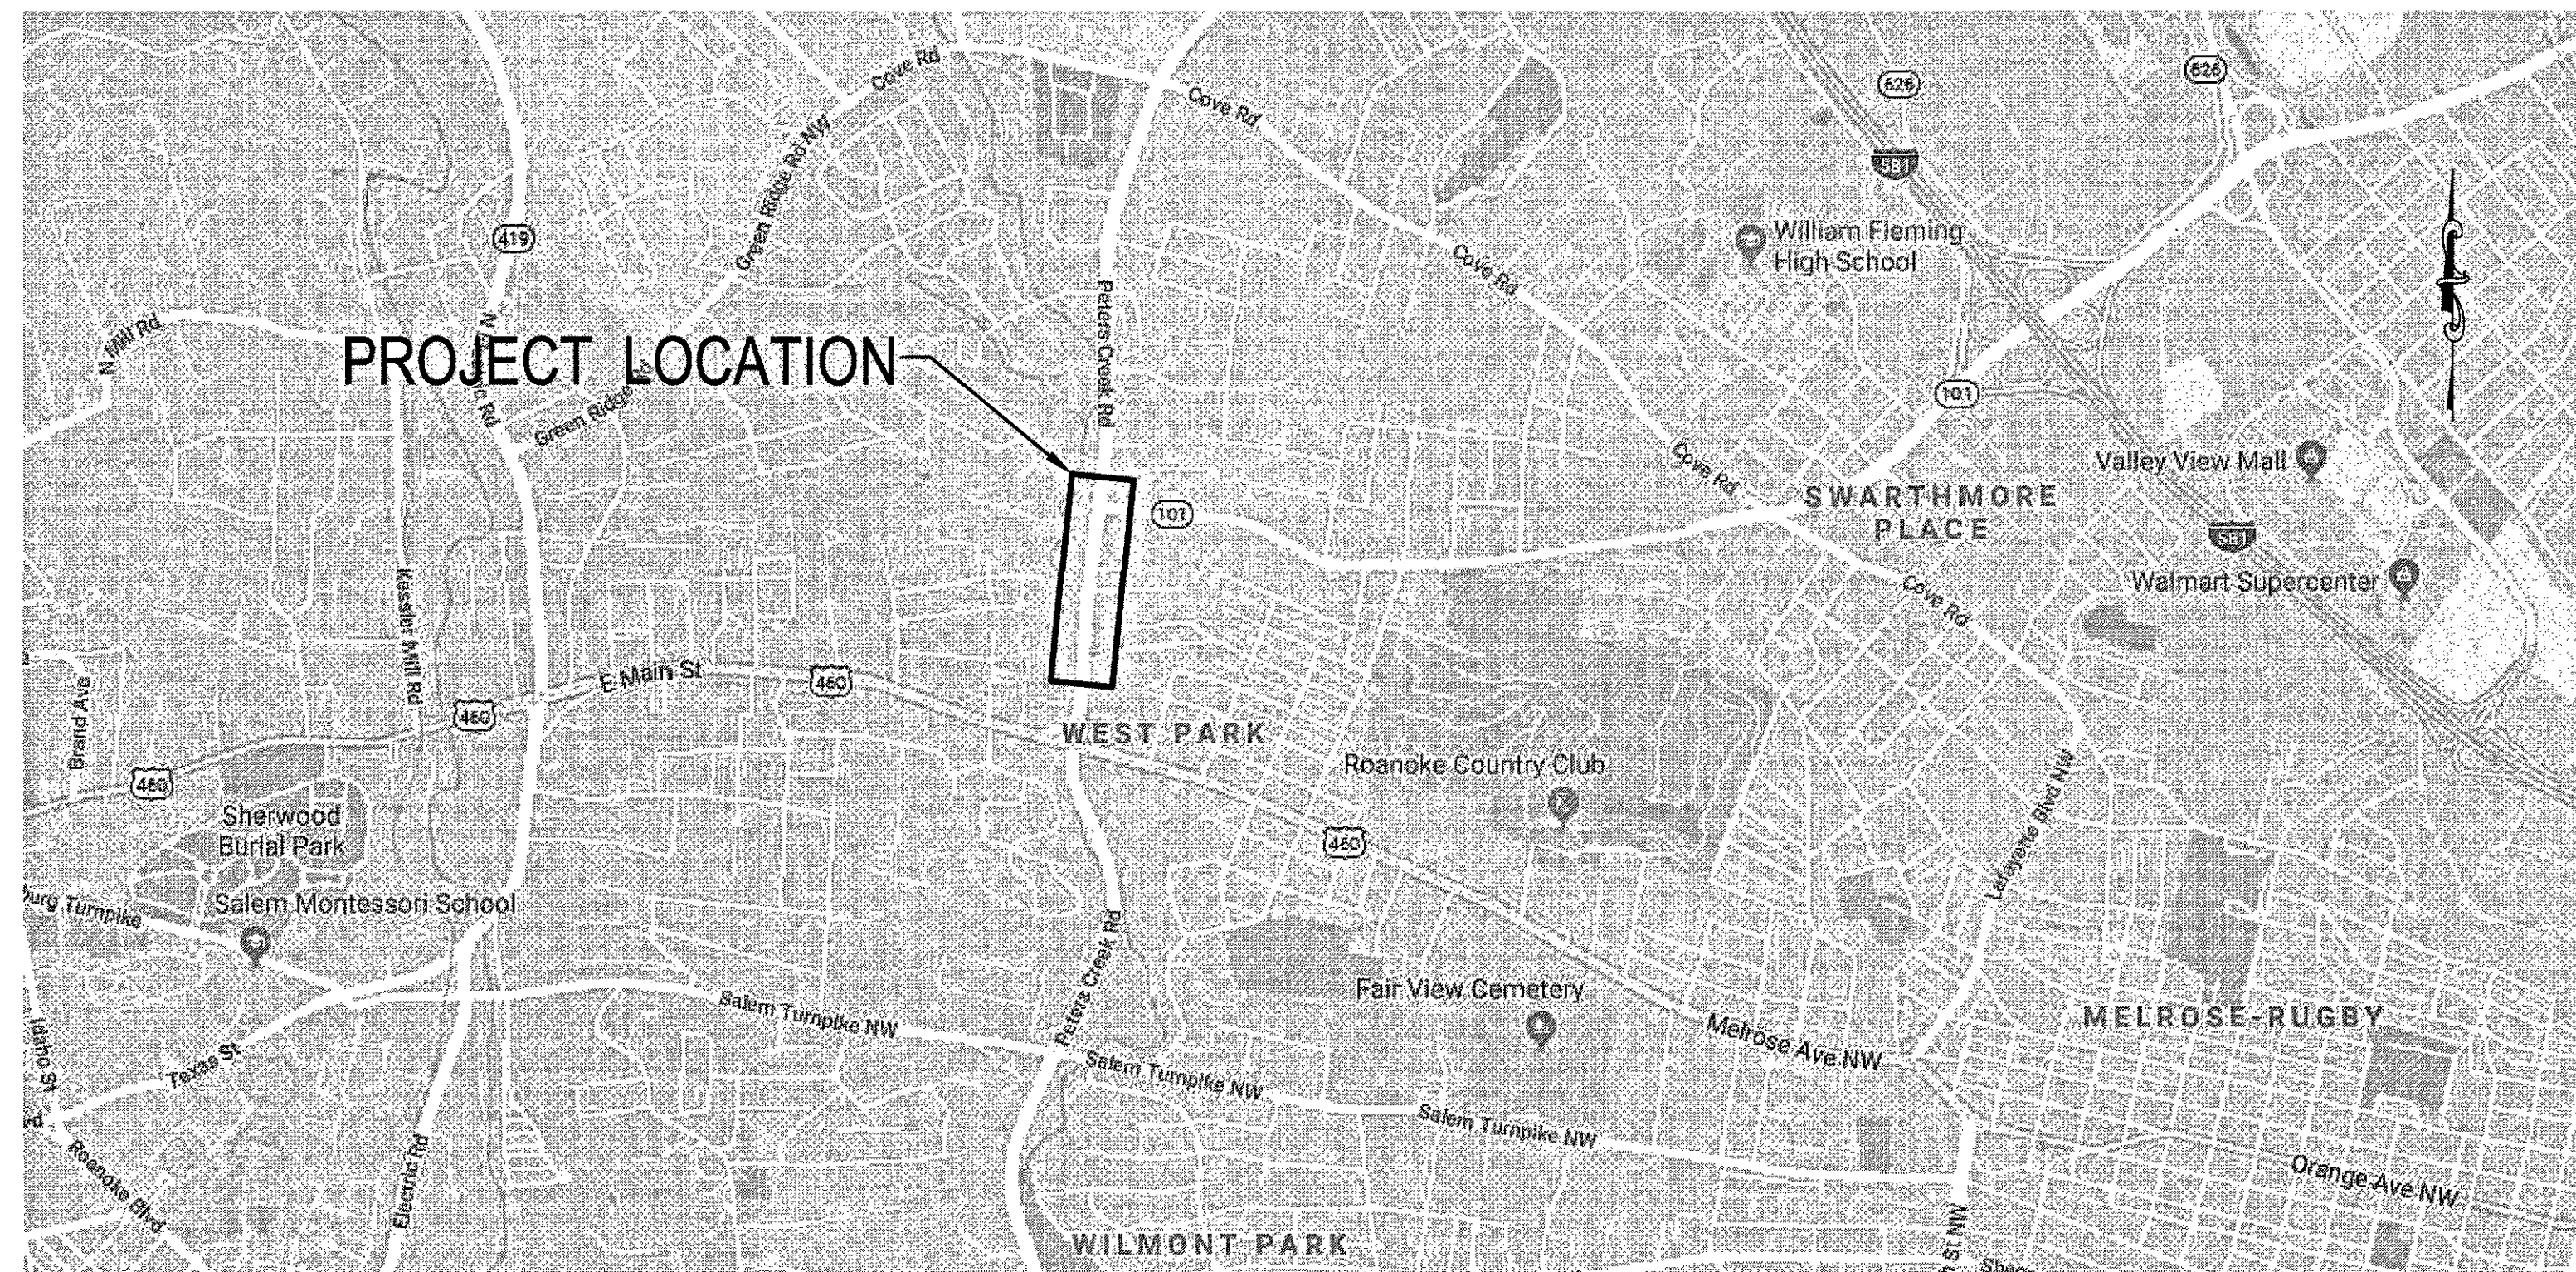

VICINITY MAP
NO SCALE

APRIL 2018

Materials

Pipe - 12" U.S. Pipe C1350 DIP
8" U.S. Pipe C1350 DIP
6" U.S. Pipe C1350 DIP

Valves

Turns to off | 12", 8", 6", 2" All AFC
36, 24, 18, 8

Service

1" polyflex Endot

Manholes - CSI

Setters - Ford 5/8 x 3/4 NO Check
15"


Contractor: E.C. PACE

Inspector: Brian Whitenack

Project Man. - Earl Smith

Earl Smith

APPROVED FOR CONSTRUCTION

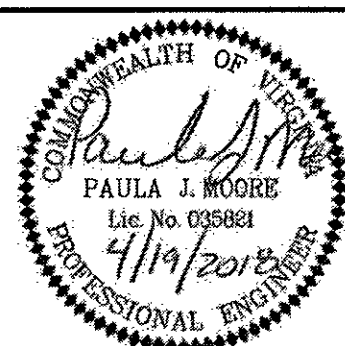

WRA
Whitman, Requardt & Associates, LLP
1700 Kraft Dr, Suite 1200, Blacksburg, VA 24060

WESTERN VIRGINIA WATER AUTHORITY
601 South Jefferson Street, Suite 300
Roanoke, Virginia 24011

DES: PJM
DRAWN: JES
CHECK: GWF
DATE: 04/19/18

SCALE: N/A
HORIZ: N/A
VERT: N/A

PETERS CREEK ROAD
WATER MAIN REPLACEMENT, PHASE 2

COVER

DRAWING

SHEET

-

1

AS BUILT 2/27/19