


c:\bb&a work files\construction\2020\20-30 ec pace peter's creek san sew ph iv\working drawings\asbuilt 059279 - www peters creek phase iv_cad.dwg
asbuilt 059279 - www peters creek phase iv_cad-c-101.plt

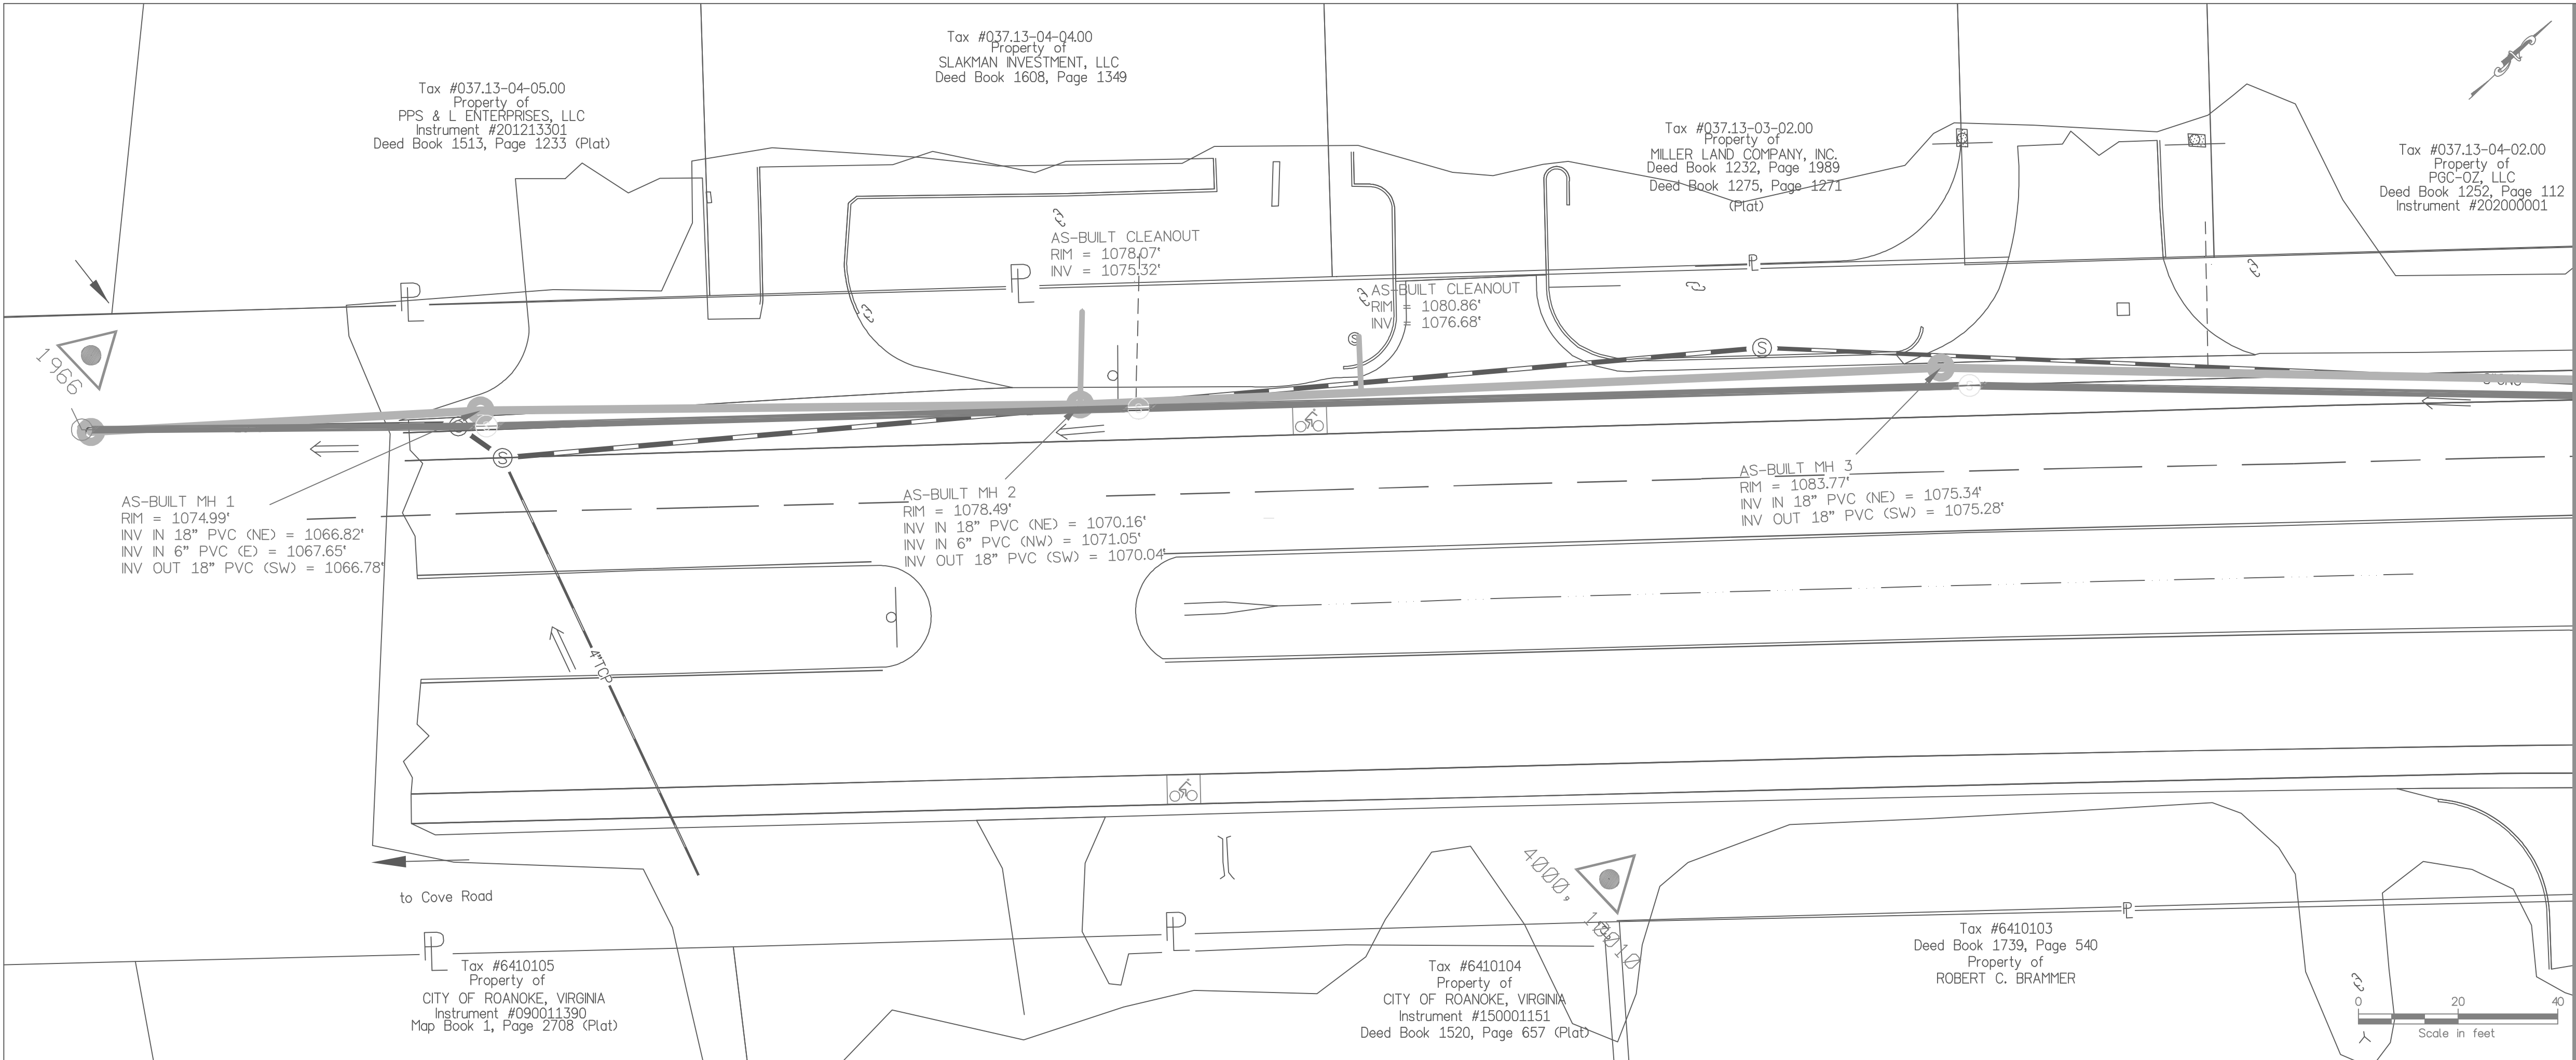

- LEGEND**
- PROPOSED LOCATION OF SANITARY SEWER
 - ASBUILT LOCATION OF SANITARY SEWER

REVISIONS		DATE		DESCRIPTION
NO.	DATE			
1				
2				
3				
4				
5				

DATE: MAY 29, 2021

SCALE: 1"=20'

SHEET 1 OF 5

WESTERN VIRGINIA WATER
AUTHORITY
PETERS CREEK ROAD
SANITARY SEWER REPLACEMENT
PHASE IV
AS-BUILT SURVEY



BYER, BENNETT & ASSOCIATES, P.L.C.
4008 RIVER RD, UNIT A
RIVER, VIRGINIA 24149
(540) 381-7004