


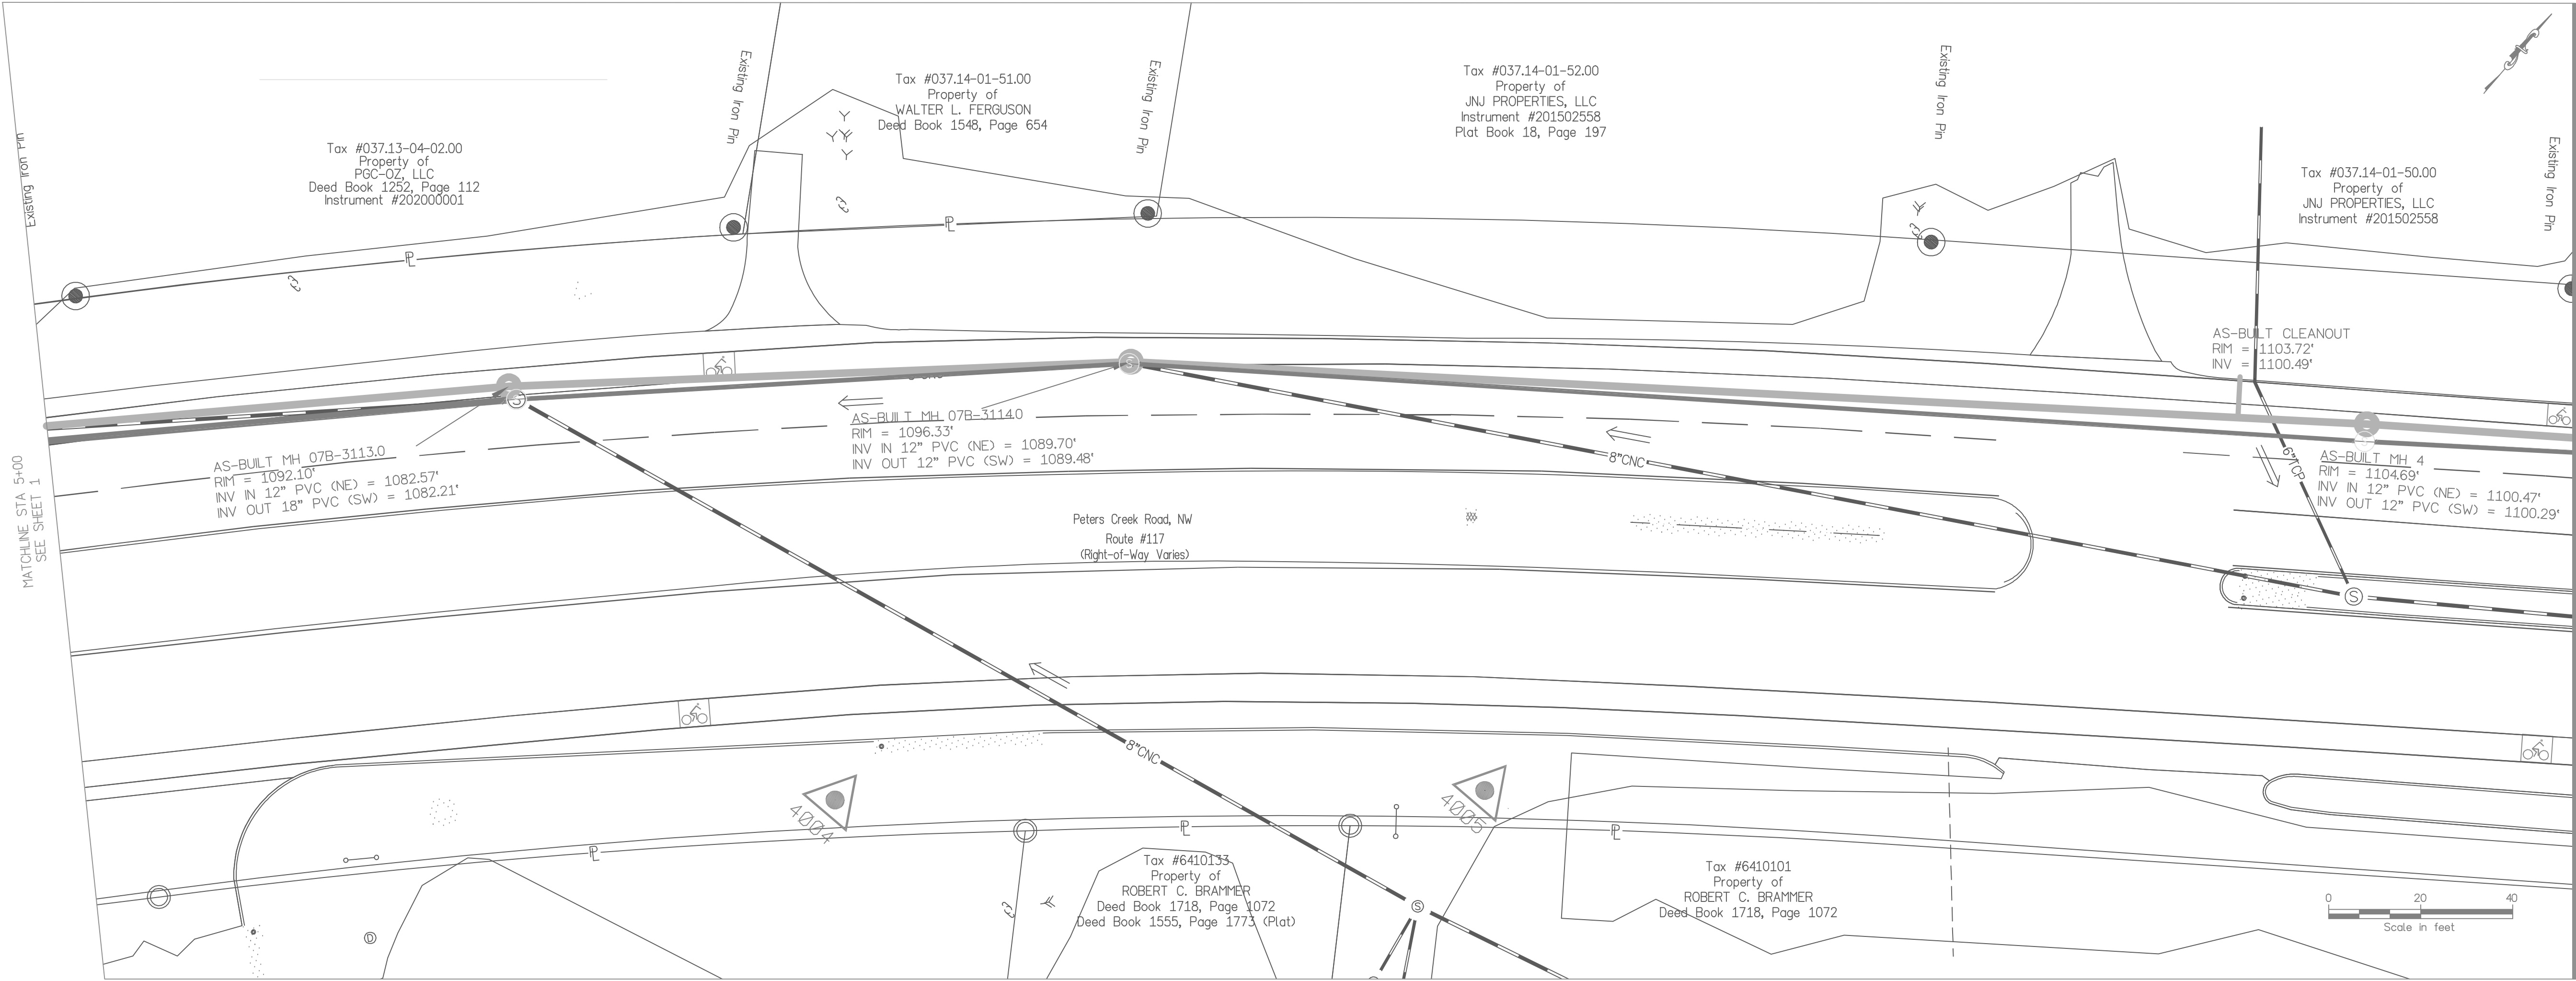

LEGEND

● PROPOSED LOCATION OF SANITARY SEWER

— ASBUILT LOCATION OF SANITARY SEWER

WESTERN VIRGINIA WATER
AUTHORITY

PETERS CREEK ROAD
SANITARY SEWER REPLACEMENT
PHASE IV

AS-BUILT SURVEY

REVISIONS	
NO.	DESCRIPTION
1	
2	
3	
4	
5	

DATE: MAY 29, 2021

SCALE: 1"=20'

SHEET 2 OF 5

BYER, BENNETT & ASSOCIATES, P.L.C.
4008 RIVER RD., UNIT A
RIVER, VIRGINIA 24149
(540) 381-7004

Byer, Bennett & Associates P.L.C.

COMMONWEALTH OF VIRGINIA
06/02/2021
DALE R. BYER
No. 002508
LAND SURVEYOR