


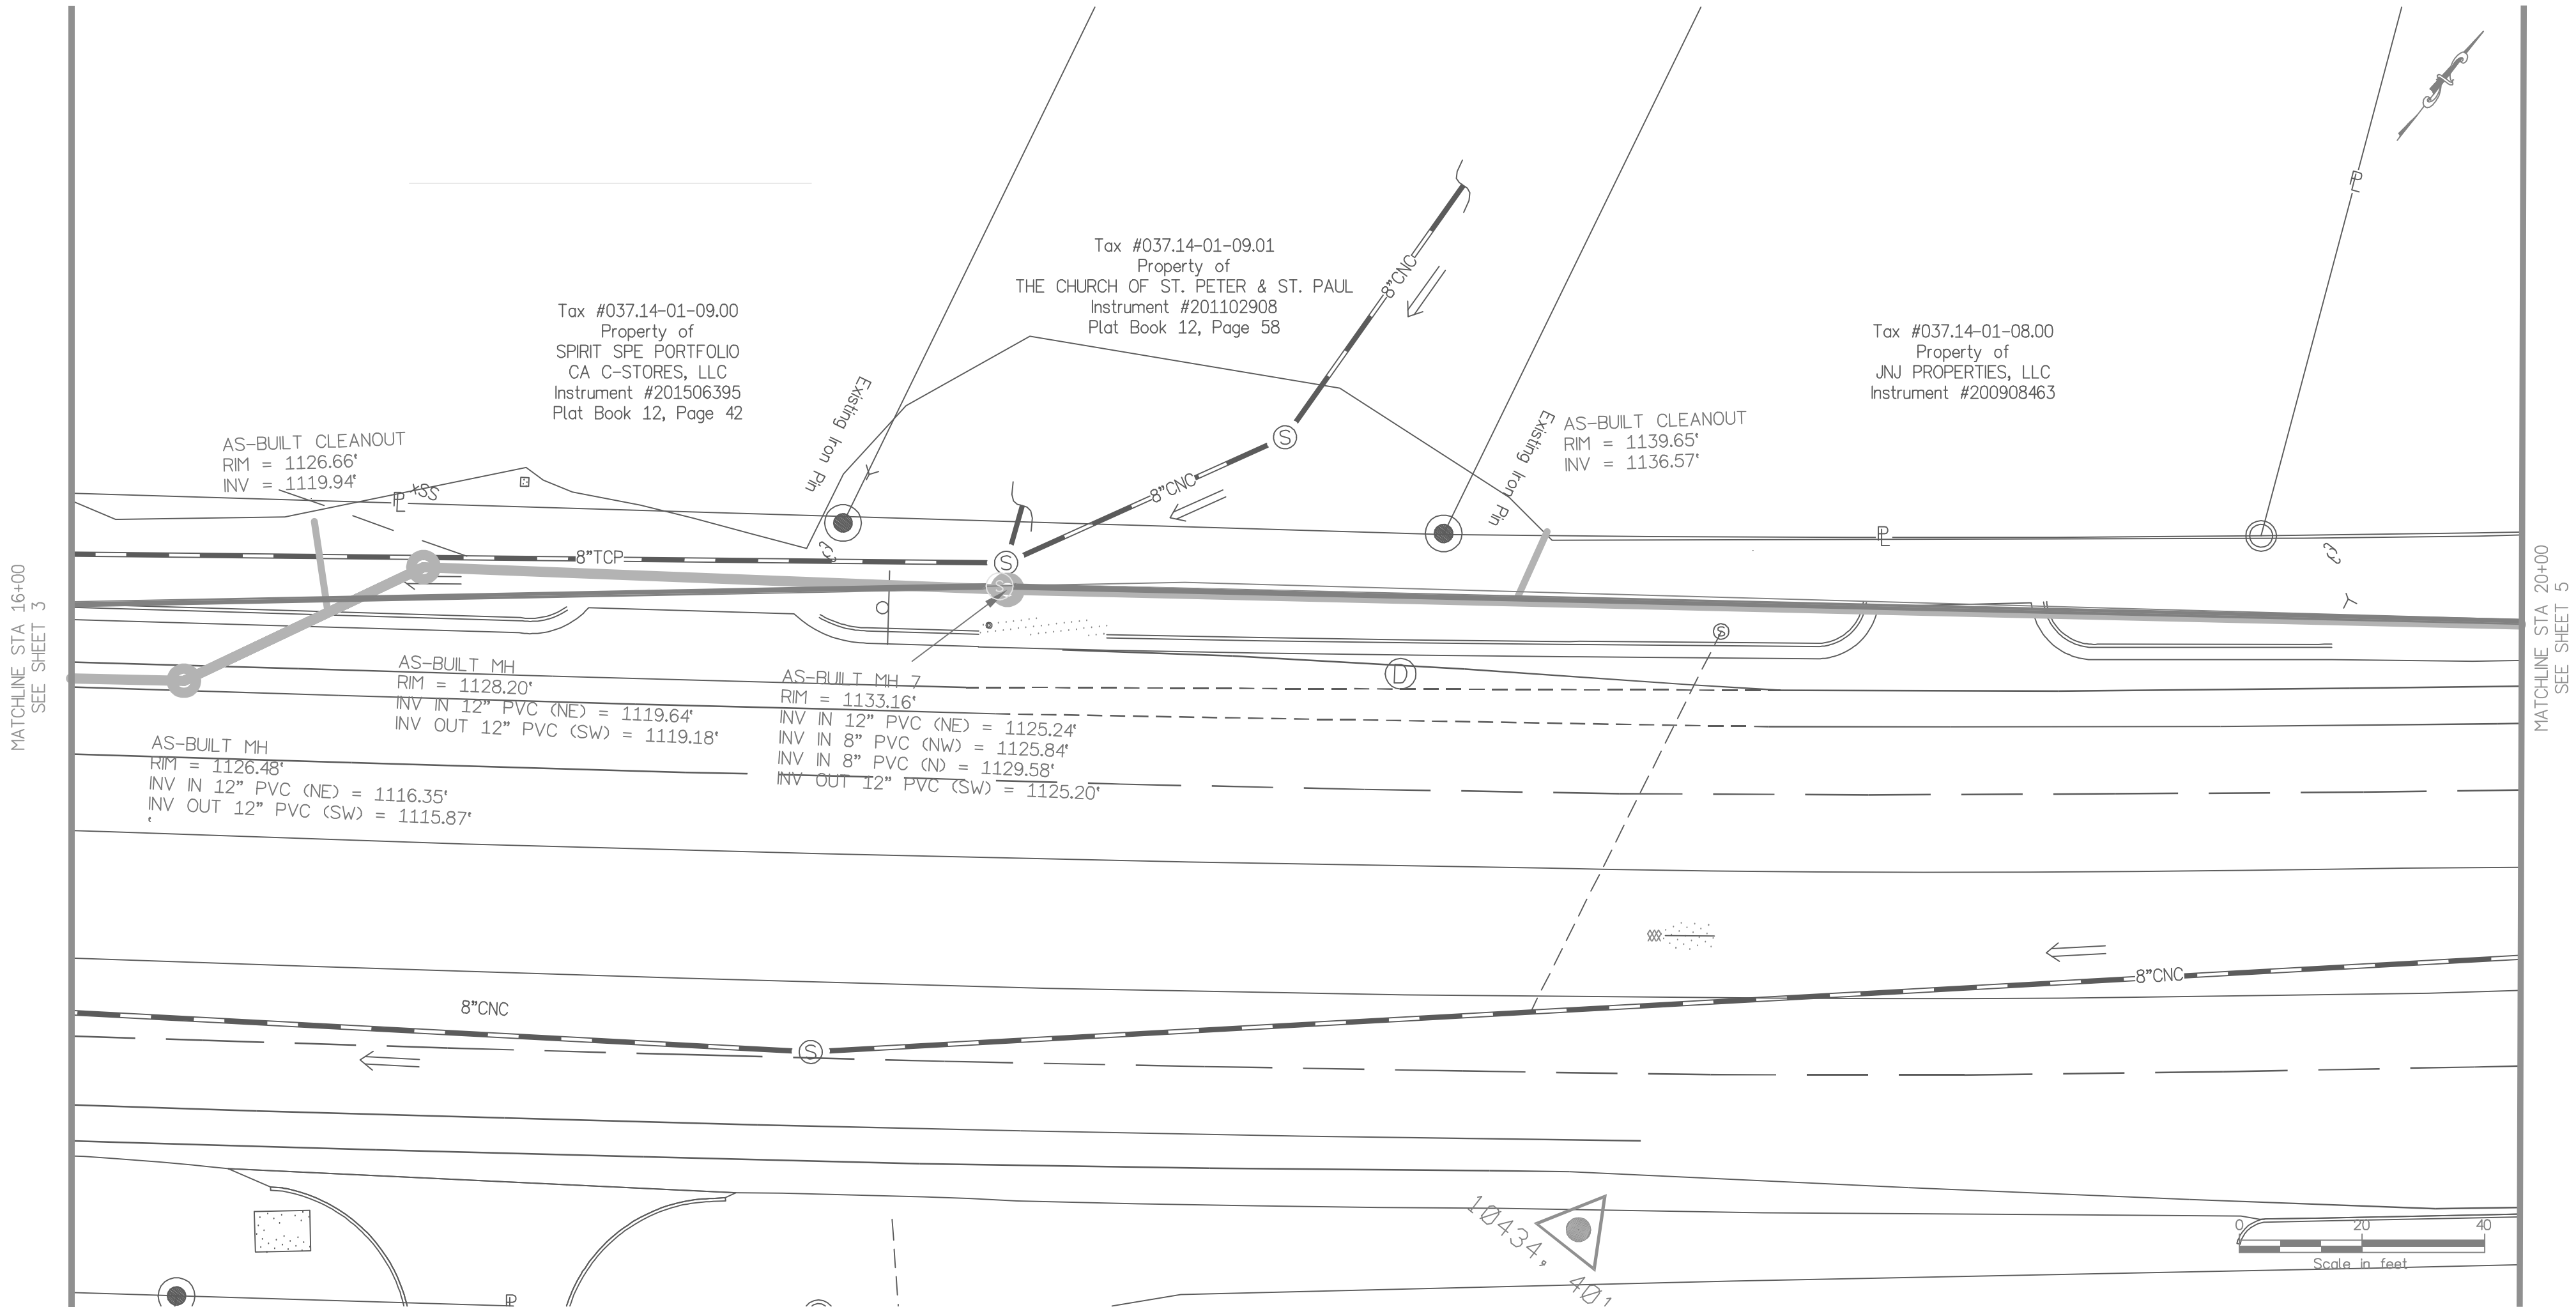

- LEGEND**
- PROPOSED LOCATION OF SANITARY SEWER
  - ASBUILT LOCATION OF SANITARY SEWER

BYER, BENNETT & ASSOCIATES, P.L.C.  
 4008 RIVER RD, UNIT A  
 RIVER, VIRGINIA 24149  
 (540) 381-7004

WESTERN VIRGINIA WATER AUTHORITY  
 PETERS CREEK ROAD  
 SANITARY SEWER REPLACEMENT  
 PHASE IV  
 AS-BUILT SURVEY

| REVISIONS |      | DATE | DESCRIPTION |
|-----------|------|------|-------------|
| NO.       | DATE |      |             |
| 1         |      |      |             |
| 2         |      |      |             |
| 3         |      |      |             |
| 4         |      |      |             |
| 5         |      |      |             |

DATE: MAY 29, 2021  
 SCALE: 1"=20'  
 SHEET 4 OF 5