

- NOTES:
 1. EXISTING SEWER LATERALS NOT SHOWN. SEE SHEET NO. 616 OF ROANOKE SEWER ATLAS.
 2. SEE SHEET 13 FOR PROFILE.

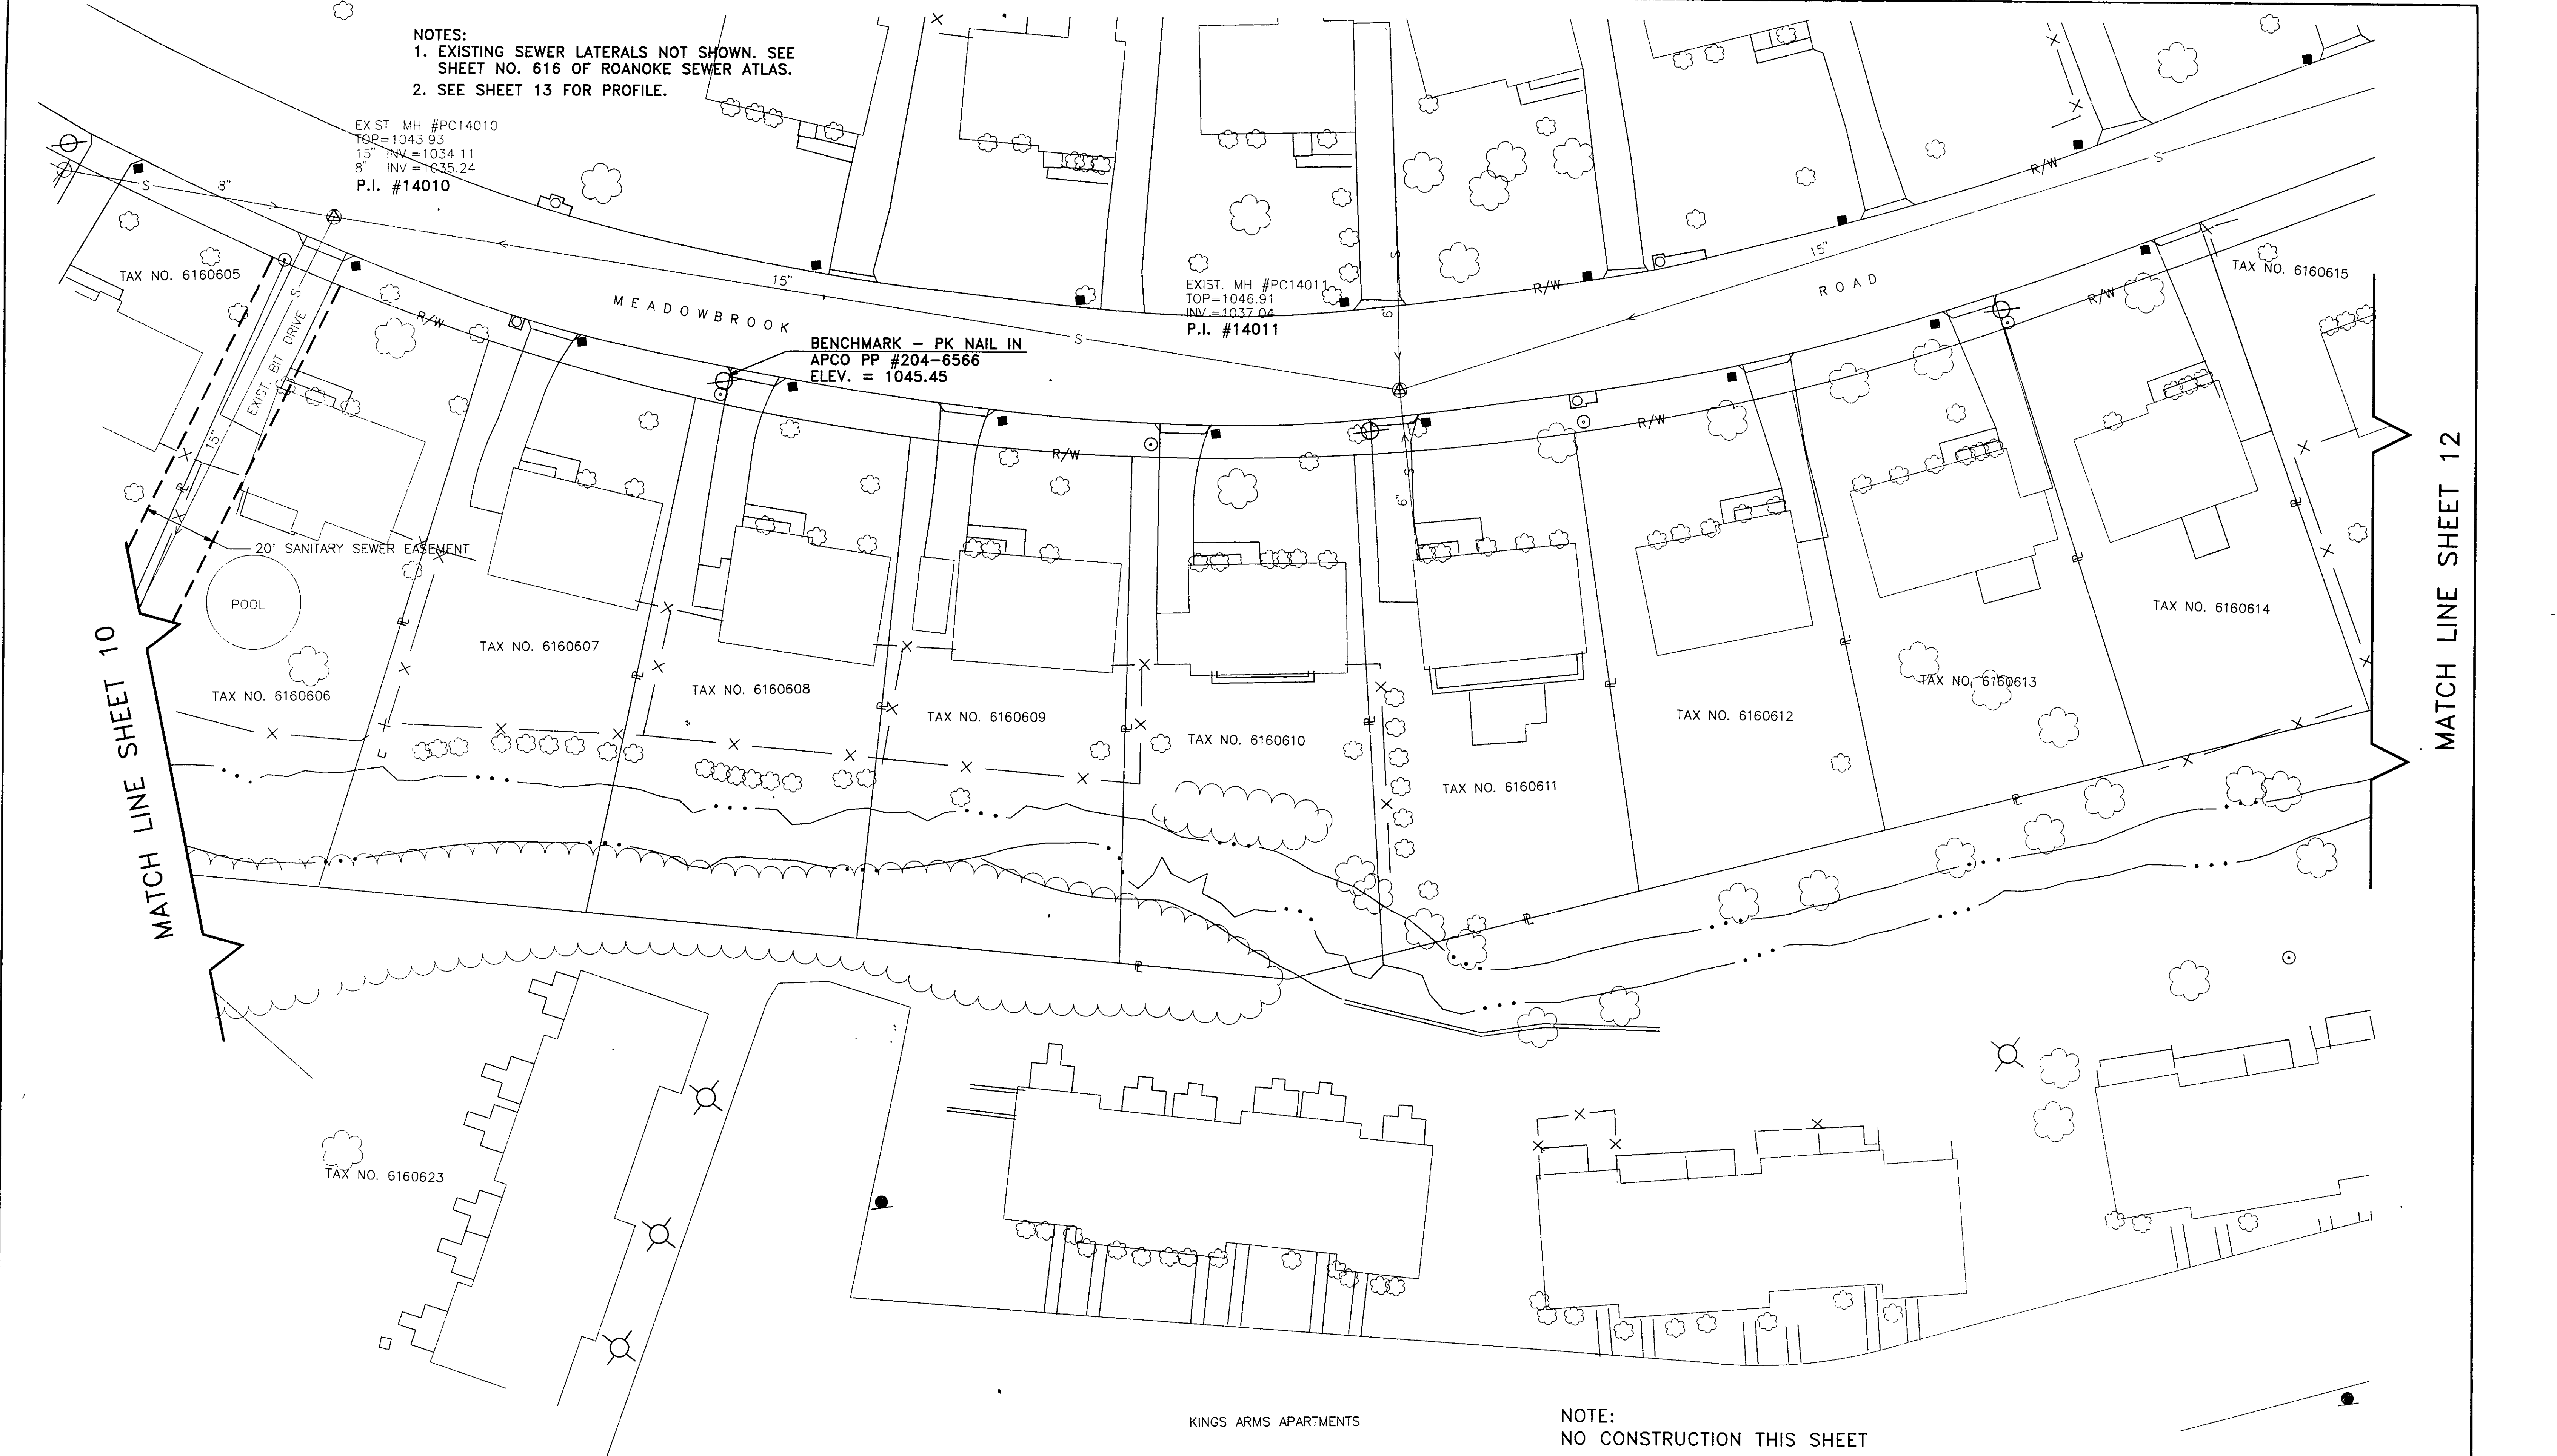
EXIST. MH #PC14010
 TOP=1043.93
 15" INV.=1034.11
 8" INV.=1035.24
 P.I. #14010

EXIST. MH #PC14011
 TOP=1046.91
 INV.=1037.04
 P.I. #14011

BENCHMARK - PK NAIL IN
 APCO PP #204-6566
 ELEV. = 1045.45

MATCH LINE SHEET 10

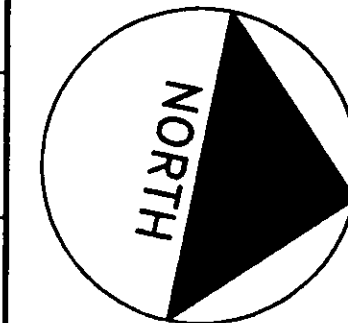
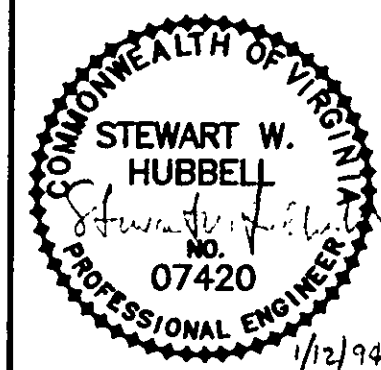
MATCH LINE SHEET 12



KINGS ARMS APARTMENTS

NOTE:
 NO CONSTRUCTION THIS SHEET

RECORD DRAWINGS
 1-11-94

 Mattern & Craig CONSULTING ENGINEERS - SURVEYORS	DESIGNED: TAM			REV.	DATE	DESCRIPTION	BY	APP.	DATE	SEWER REPLACEMENT PROJECT PC-1 PETERS CREEK SEWERSHED PLAN CITY OF ROANOKE, VIRGINIA SCALE: 1"=20' HORIZ. 1"=10' VERT.	SHEET 11
	DRAWN: TAM			1	1/11/94	RECORD DRAWINGS	TAM	SWH	MAY 1993		
	CHECKED: SWH								COMM. NO. 1245		