

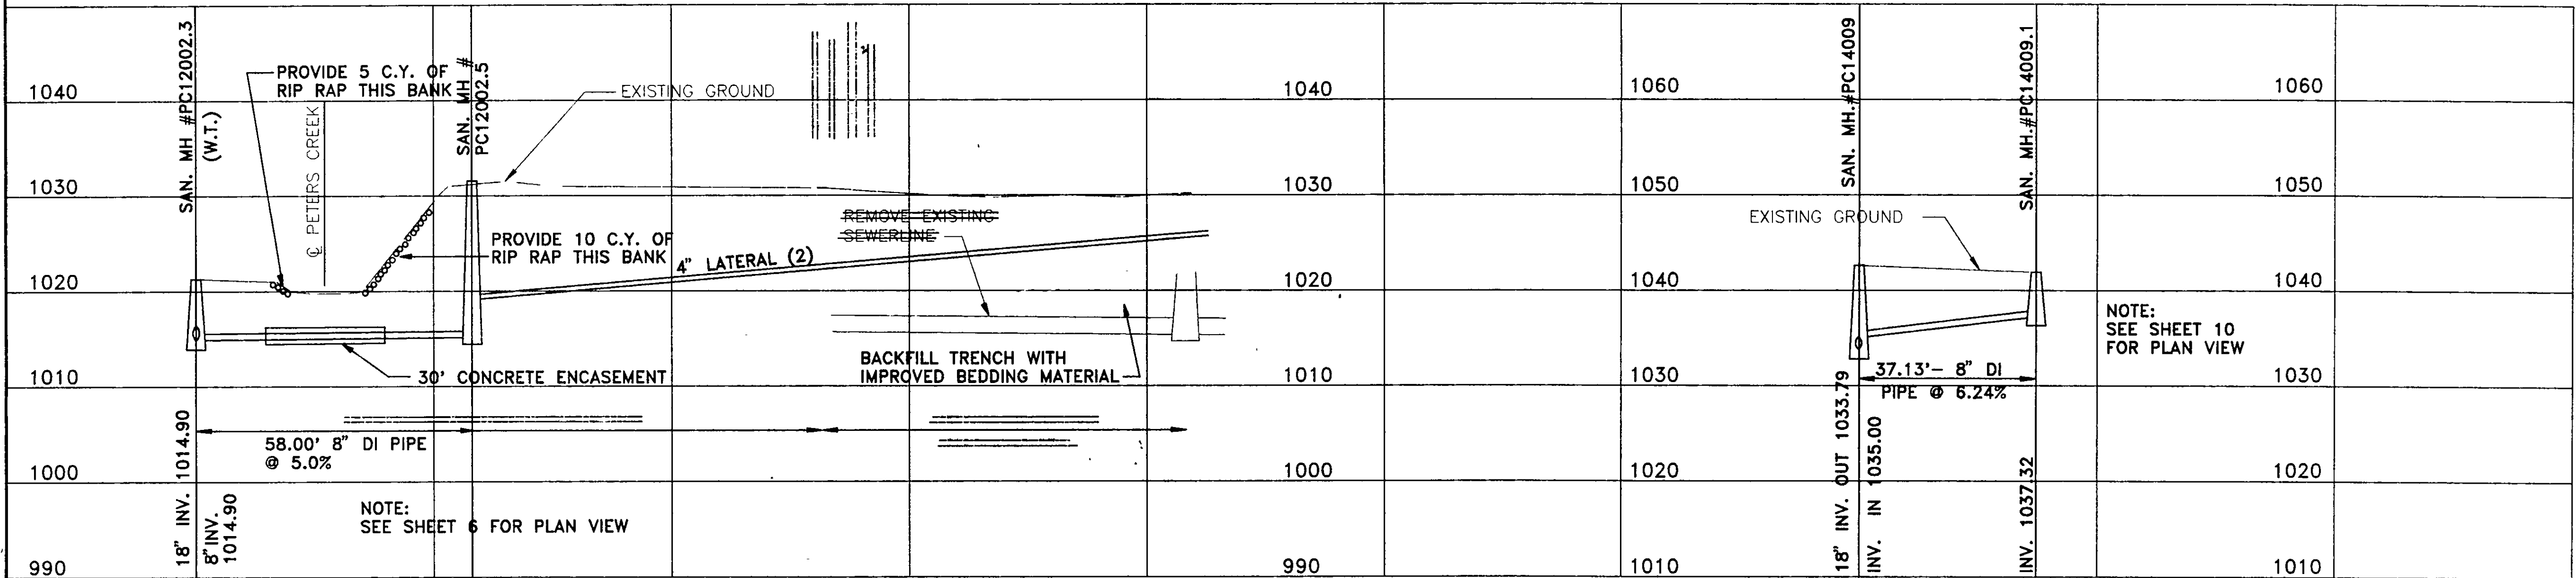


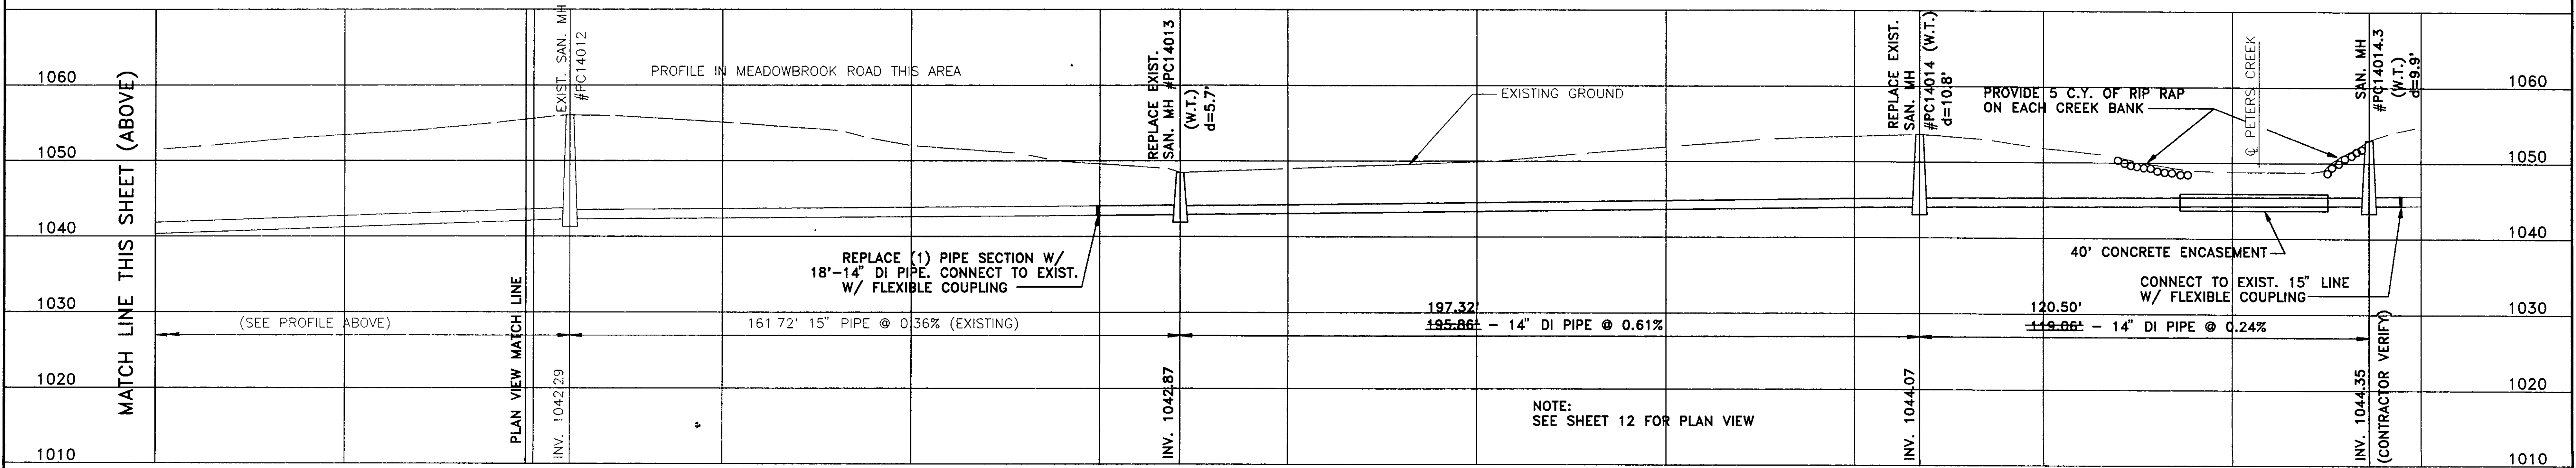


LEGEND (THIS SHEET ONLY)

CONSTRUCTED

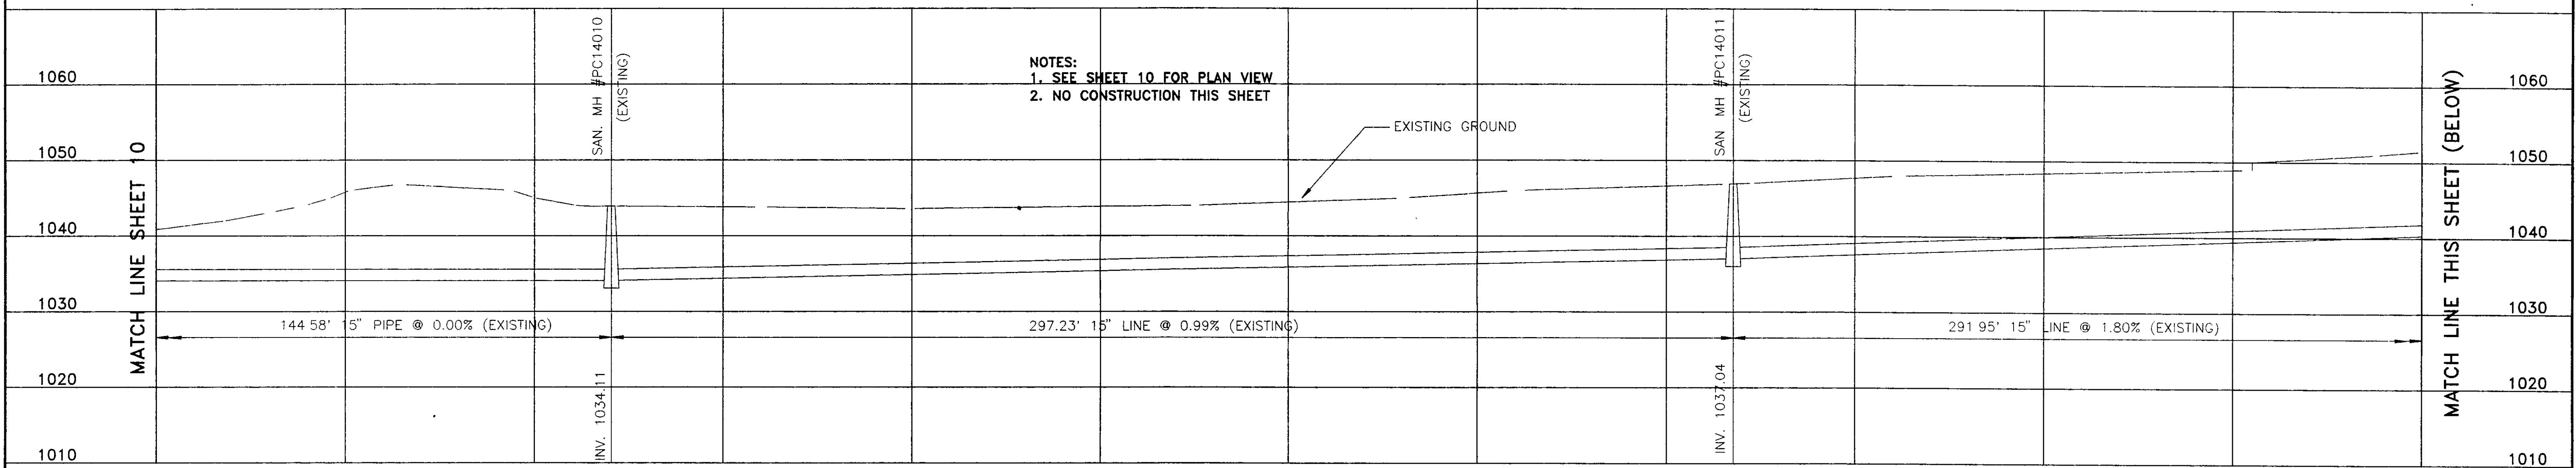

RECORD DRAWINGS
1-11-94

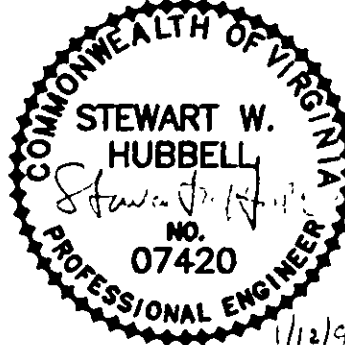 Mattern & Craig CONSULTING ENGINEERS - SURVEYORS	DESIGNED: TAM		REV.	DATE	DESCRIPTION	BY	APP.	DATE MAY 1993 COMM. NO. 1245	SEWER REPLACEMENT PROJECT PC-1 PETERS CREEK SEWARDSHED PROFILE CITY OF ROANOKE, VIRGINIA SCALE: 1"=20' HORIZ. 1"=10' VERT.	SHEET 13
	DRAWN: TAM		1	1/11/94	RECORD DRAWINGS	TAM	SWH			
	CHECKED: SWH									