


PROJECT LOCATION MAP

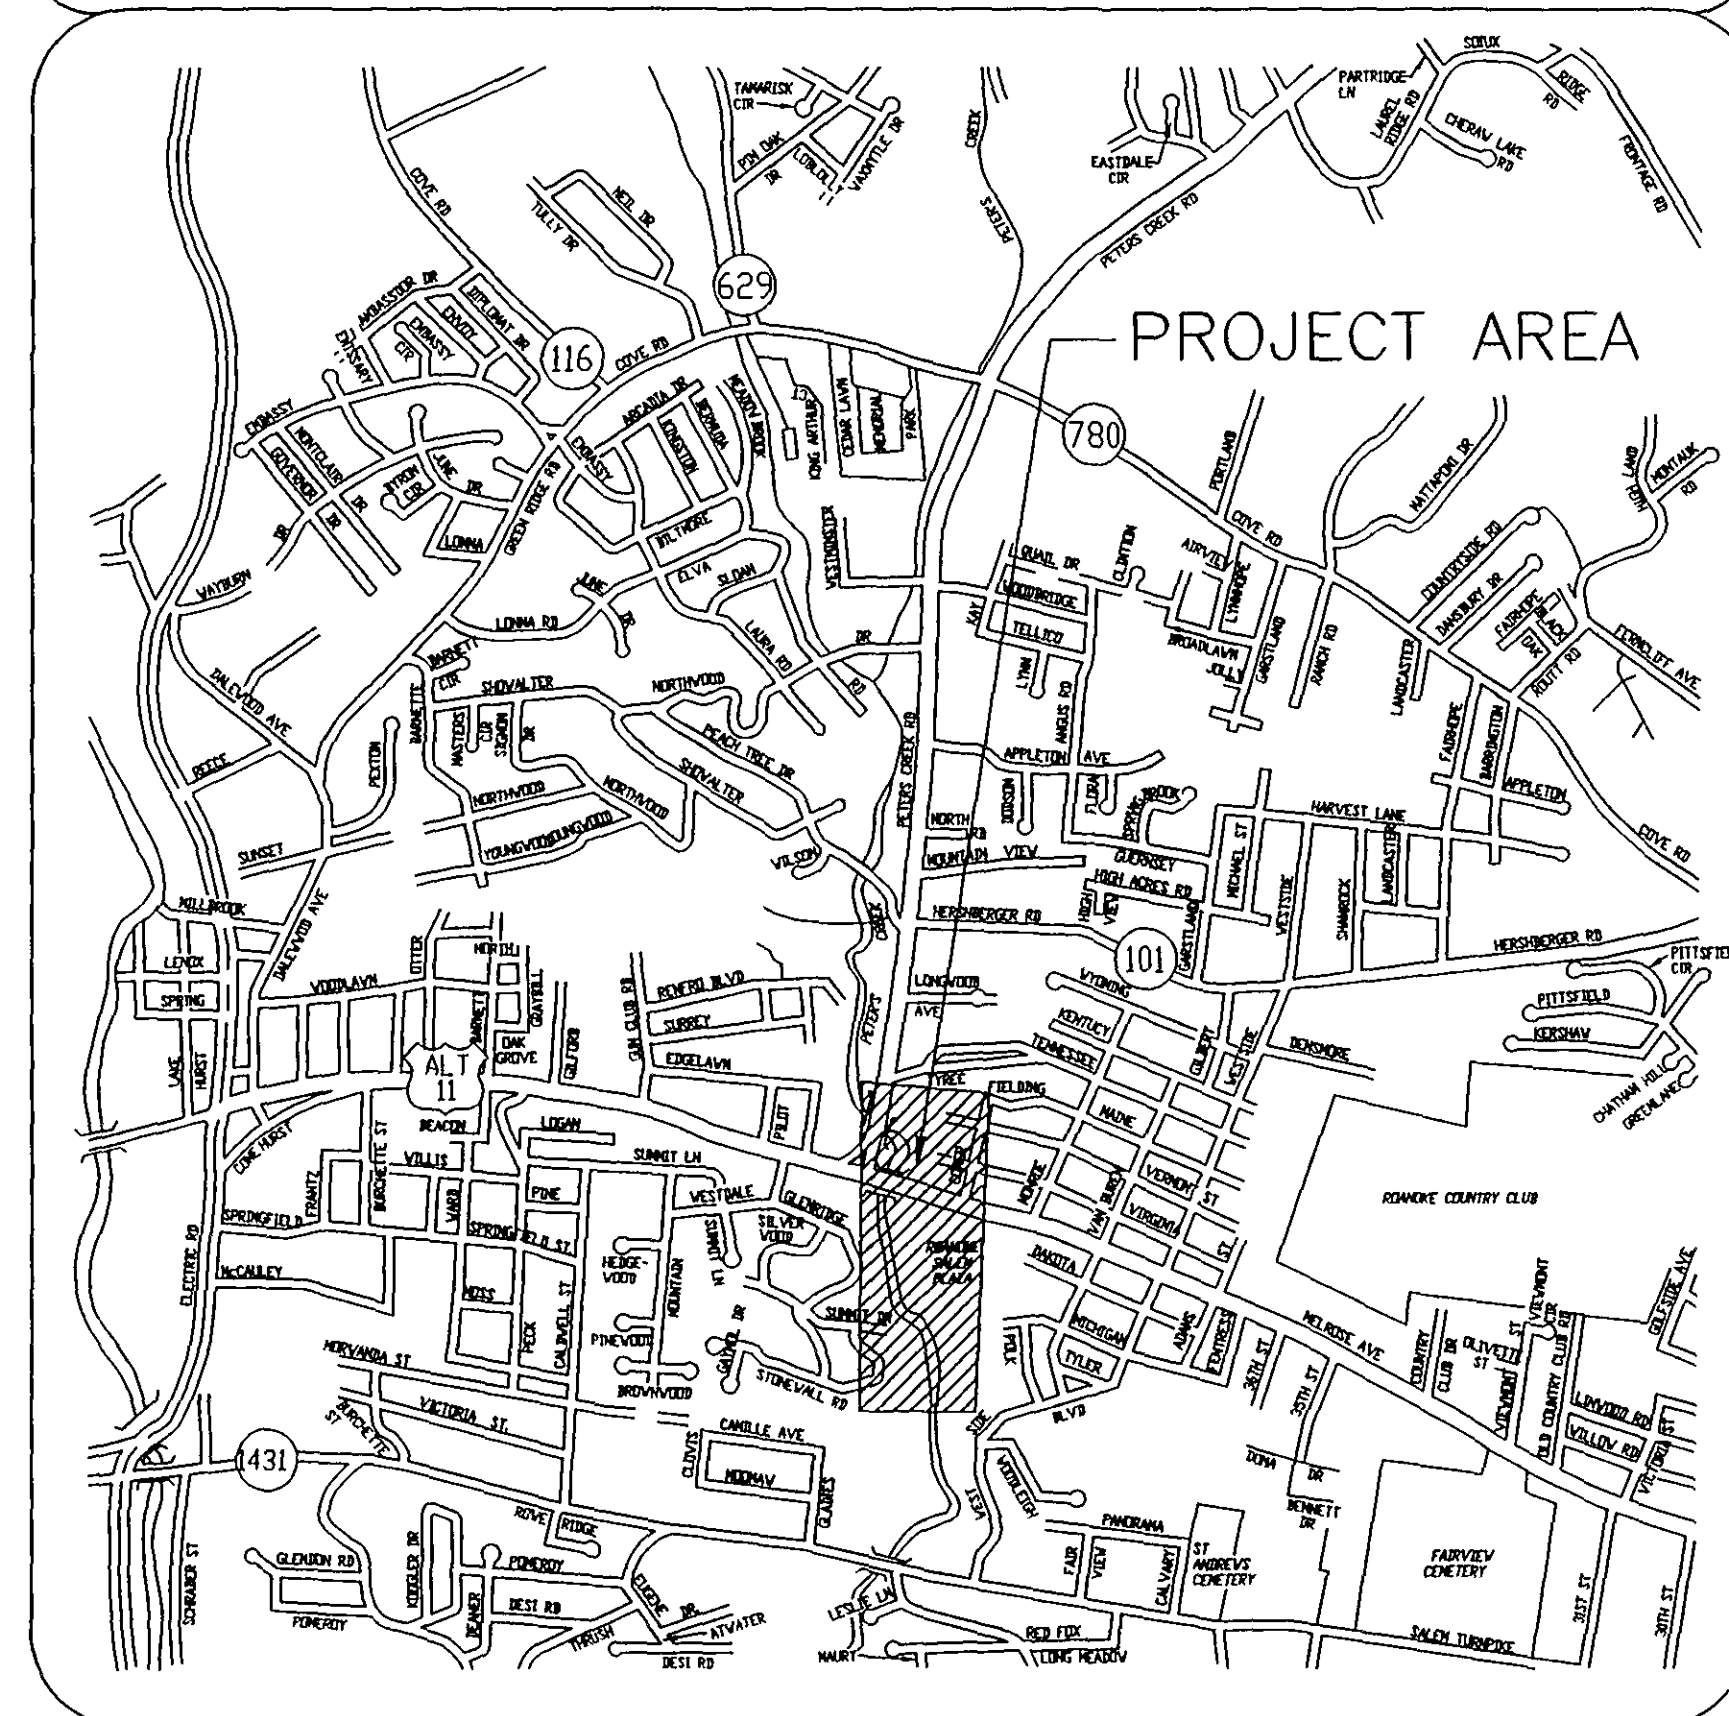

OFFICE OF CITY ENGINEER
ROOM 350
MUNICIPAL BUILDING
215 CHURCH AVENUE, S.W.
ROANOKE, VIRGINIA 24011

INDEX OF SHEETS

- 1 TITLE
- 2 SUMMARY OF QUANTITIES
- 3 GENERAL ABBREVIATIONS & LEGEND
- 4 SHEET INDEX & GENERAL NOTES
- 5 PLAN & PROFILE
- 6 PLAN & PROFILE
- 7 PLAN & PROFILE
- 8 PLAN & PROFILE
- 9 PLAN & PROFILE
- 10 PROFILES AND DETAILS

CONSULTING ENGINEERS



Mattern & Craig


CONSULTING ENGINEERS

SURVEYORS

701 FIRST STREET

ROANOKE, VIRGINIA

COMMISSION NUMBER: 1245C

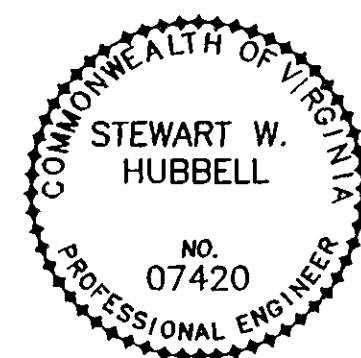

PROJECT NAME

PETERS CREEK SEWER REPLACEMENT
PROJECT PC-4

CITY OF ROANOKE, VIRGINIA

PROJECT NUMBER: 6245C

REVISION BY	DESCRIPTION:	DATE
REVISION BY	DESCRIPTION:	DATE
REVISION BY	DESCRIPTION:	DATE
REVISION BY	DESCRIPTION:	DATE

APPROVED FOR CONSTRUCTION

ROANOKE CITY ENGINEER

DATE

DIRECTOR OF PUBLIC WORKS

DATE

DIRECTOR OF PUBLIC UTILITIES AND OPERATIONS

DATE

DATE

DATE

ADVERTISED DATE:

SET NUMBER:

SHEET NUMBER: 1 OF 10

RECORD DRAWINGS

10-11-98

PROJECT NO. 6245C