

RALPH SMITH, INC.
D.B. 1590 PG. 52
TAX NO. 6070122

DRIVE

V
MATCH LINE SHEET 6

MATCH LINE SHEET

NOTES:

1. WORK ON THIS SHEET CONSISTS OF ABANDONING WITH THE EXISTING 18" SEWER LINE. ACCESS TO THE CONSTRUCTION EASEMENT SHALL BE FROM THE MALL PARKING LOT, FROM MELROSE AVENUE R/W OR FROM NEW PETERS CREEK ROAD R/W. ANY DAMAGE TO THE SLOPES OR LOT SHALL BE REPAIRED BY THE CONTRACTOR.
2. SEWER IN THIS AREA SHALL NOT BE ABANDONED UNTIL ALL WORK UPSTREAM IS COMPLETED.



RECORD DRAWINGS
10-11-98

FEDERAL DEPOSIT INSURANCE CORP.
D.B. 1719 PG. 1832
TAX NO. 2761701

[illegible]

Mattern & Craig
CONSULTING ENGINEERS - SURVEYORS

DESIGNED:	TAM
DRAWN:	ASB
CHECKED:	SWH

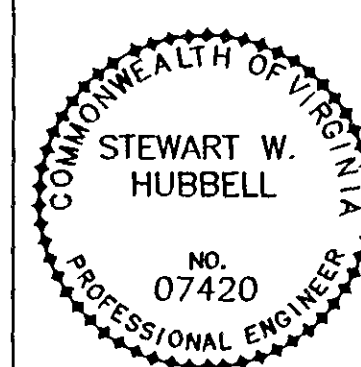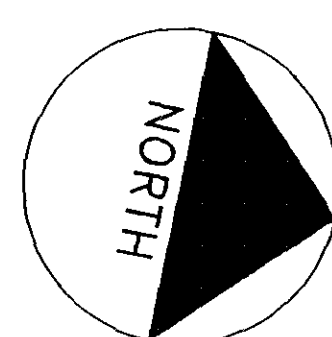

REV.	DATE	DESCRIPTION	BY	APP
△	11/95	AS PER CITY COMMENTS	DSG	SWH
△	10/98	RECORD DRAWINGS	JMC	SWI

DATE
JANUARY
1995
COMM. NO.
1245C

PETERS CREEK SANITARY SEWER REPLACEMENT
PROJECT PC-4
PLAN AND PROFILE
CITY OF ROANOKE,

VIRGINIA

SHEFT

—

SCALE: 1"=20' HORIZONTAL
1"=10' VERTICAL

ACAD/1245C/7

PROJECT NO. 6245C