


PROJECT LOCATION MAP

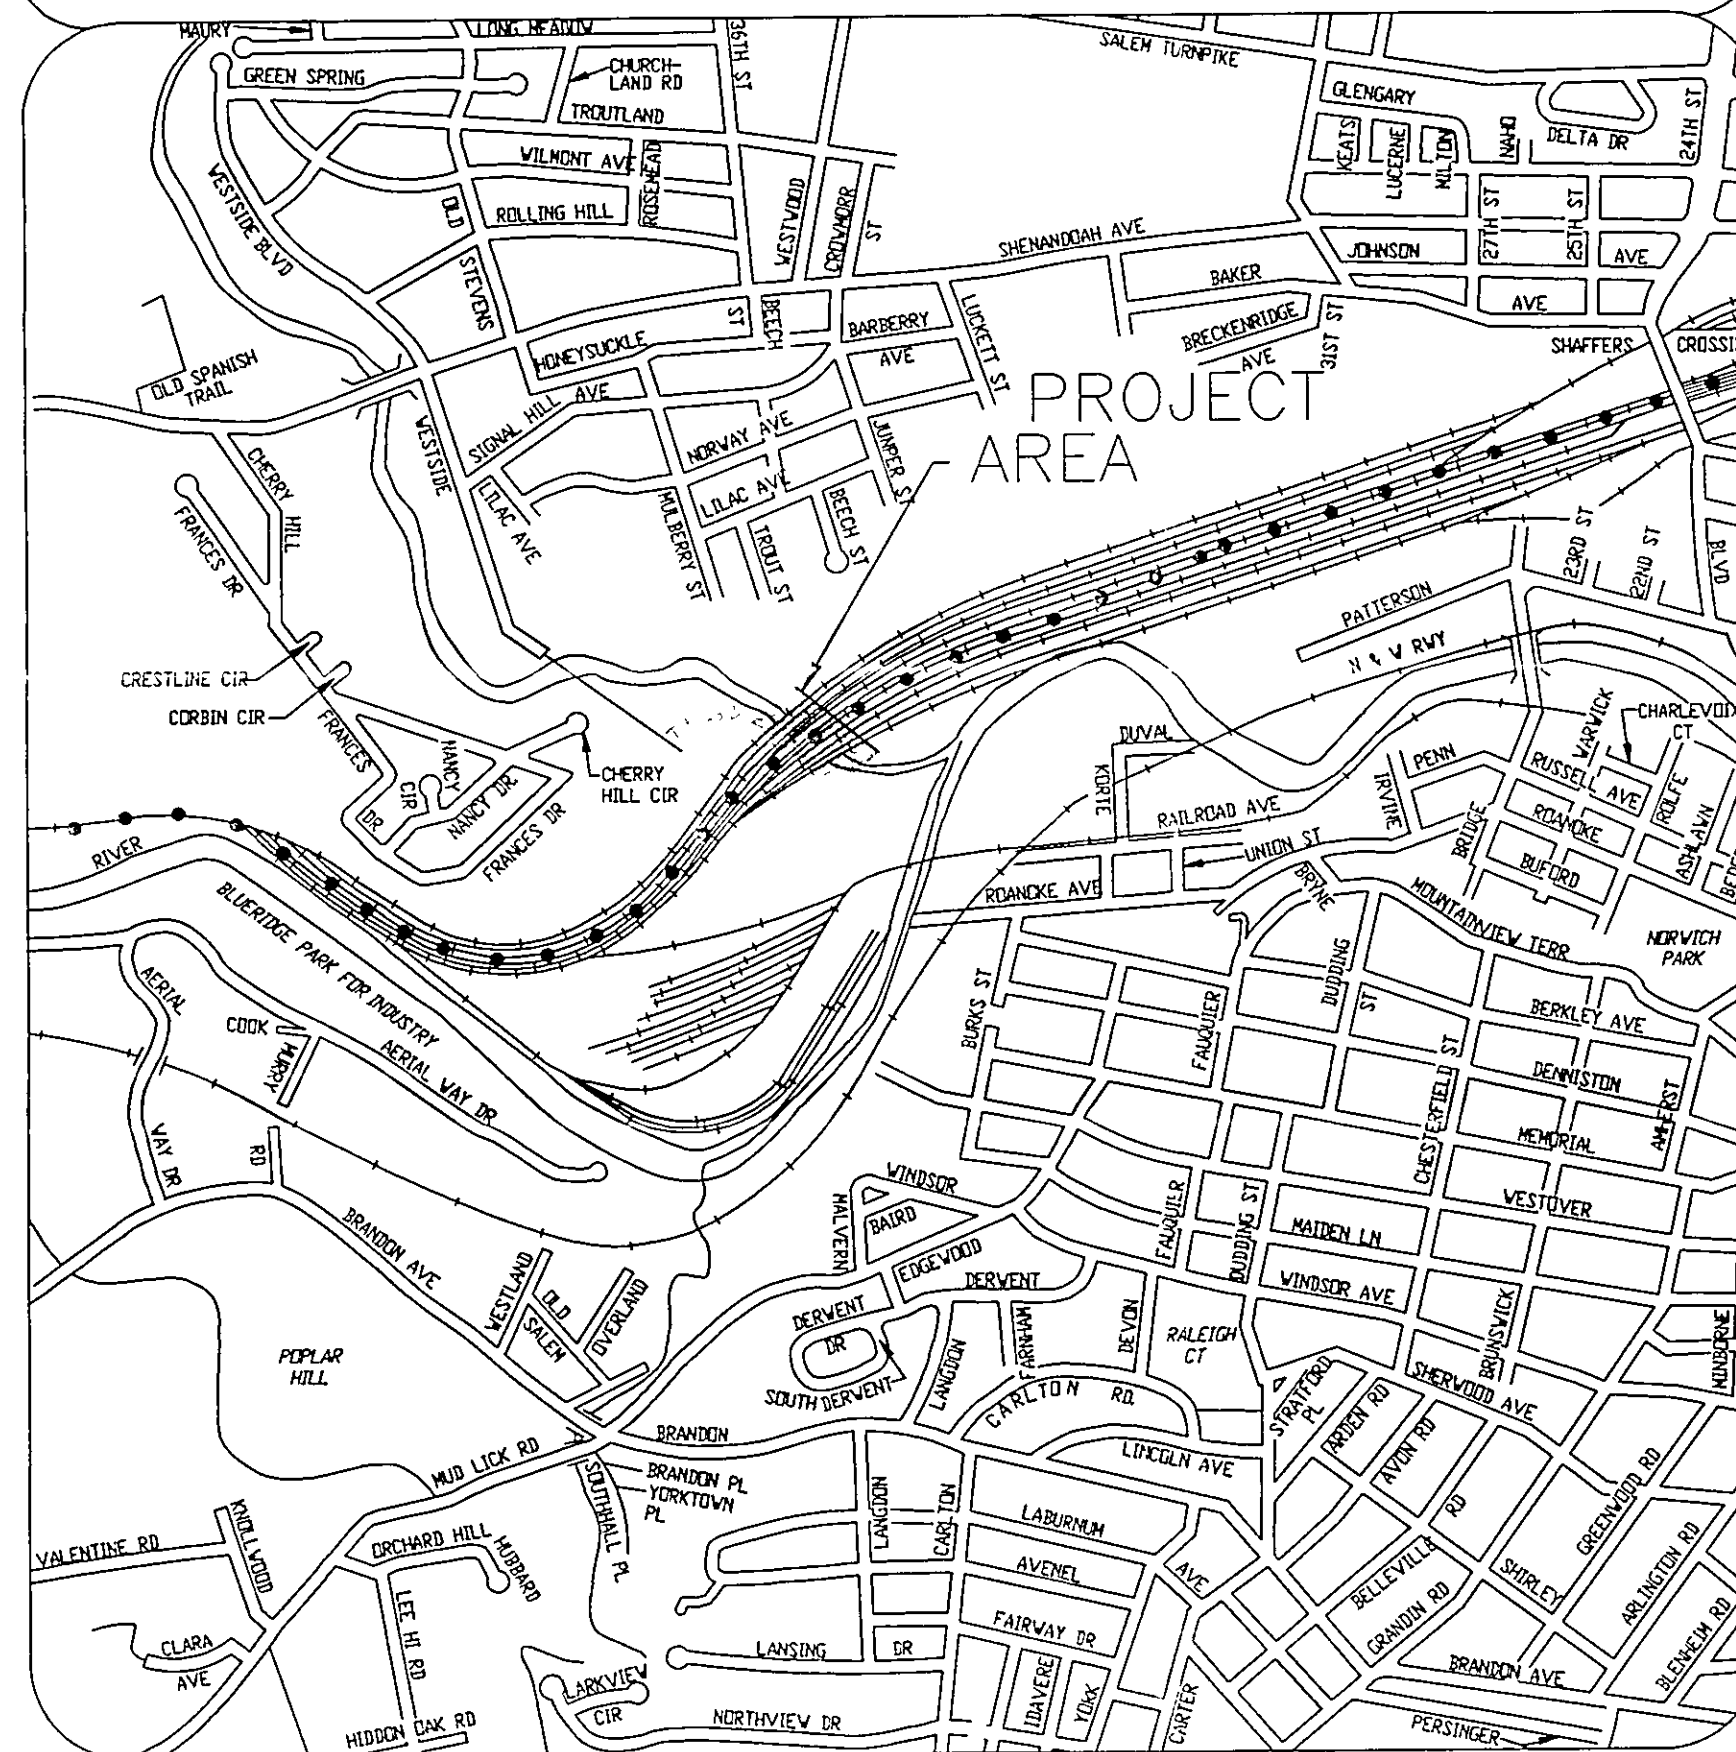


OFFICE OF CITY ENGINEER
ROOM 350
MUNICIPAL BUILDING
215 CHURCH AVENUE, S.W.
ROANOKE, VIRGINIA 24011

INDEX OF SHEETS

- 1 TITLE
- 2 SUMMARY OF QUANTITIES
- 3 GENERAL ABBREVIATIONS & LEGEND
- 4 PLAN & PROFILE
- 5 DETAILS

CONSULTING ENGINEERS

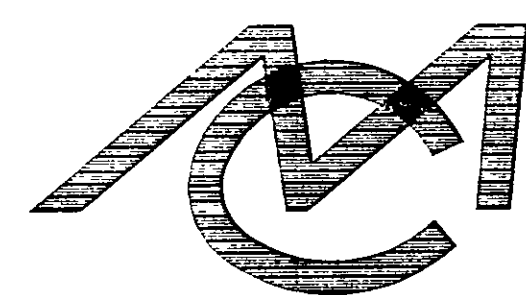

Mattern & Craig


CONSULTING ENGINEERS

SURVEYORS

701 FIRST STREET

ROANOKE, VIRGINIA

COMMISSION NUMBER: 1245I

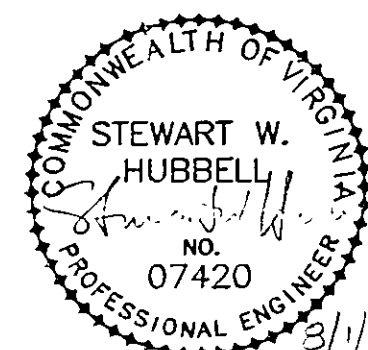

PROJECT NAME

PETERS CREEK SEWER REPLACEMENT
PROJECT PC-6A

CITY OF ROANOKE, VIRGINIA

PROJECT NUMBER: 6245I

REVISION BY	DESCRIPTION:	DATE
REVISION BY	DESCRIPTION:	DATE
REVISION BY	DESCRIPTION:	DATE
REVISION BY	DESCRIPTION:	DATE

APPROVED FOR CONSTRUCTION

Charles M. Huffine
ROANOKE CITY ENGINEER

8-29-95
DATE

William F. Clark
DIRECTOR OF PUBLIC WORKS

8-29-95
DATE

W. B. L.
DIRECTOR OF PUBLIC UTILITIES AND OPERATIONS

8/29/95
DATE

ADVERTISED DATE:

AUGUST 27, 1995

SET NUMBER:

SHEET NUMBER: 1 OF 5

RECORD DRAWINGS 8-5-96