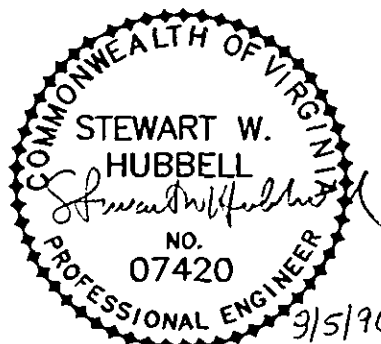
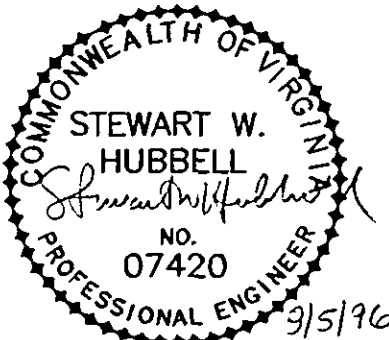


ABBREVIATIONS

LEGEND

SEE SHEET 3

A circular professional engineer seal for the Commonwealth of Virginia. The outer ring contains the text "COMMONWEALTH OF VIRGINIA" at the top and "PROFESSIONAL ENGINEER" at the bottom. Inside the ring, the name "STEWART W. HUBBELL" is printed, followed by "NO. 07420". A handwritten signature, "Stewart W. Hubbell", is written across the center of the seal. The date "9/5/96" is handwritten at the bottom right of the seal.

RECORD DRAWINGS 8-5-96

8-5-96

SUMMARY OF QUANTITIES

[illegible]

PROJECT NUMBER 6245I

SHEET NUMBER 2 OF 5