


WESTERN VIRGINIA WATER AUTHORITY

PETERS CREEK ROAD

SANITARY SEWER REPLACEMENT

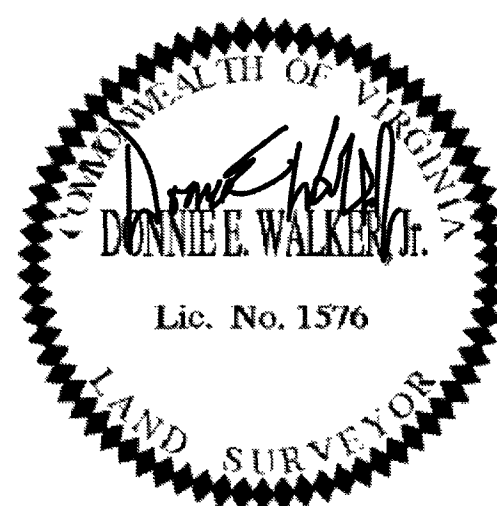



I, DONNIE E. WALKER, JR., LAND SURVEYOR, CERTIFY
THE AS-BUILT INFORMATION SHOWN IN RED



VICINITY MAP
1" = 5000'

PREPARED FOR:
WESTERN VIRGINIA WATER AUTHORITY
601 S. JEFFERSON ST
ROANOKE, VA 24011
TELEPHONE: 540-853-5700
FAX: 540-283-8217

PREPARED BY:
CHA CONSULTING
1341 RESEARCH CENTER DRIVE
BLACKSBURG, VIRGINIA 24060
TELEPHONE: 540-552-5548
FAX: 540-552-5577

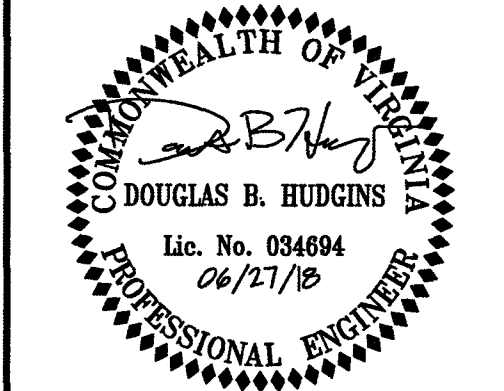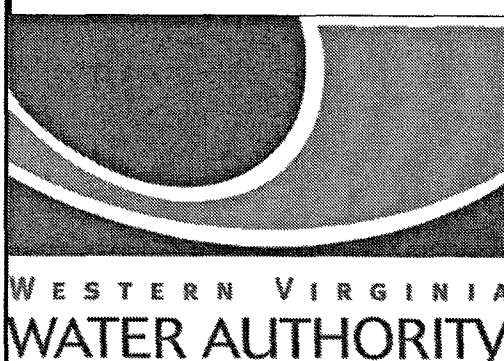

IT IS A VIOLATION OF LAW FOR ANY PERSON, UNLESS THEY ARE
ACTING UNDER THE DIRECTION OF A LICENSED PROFESSIONAL
ENGINEER, ARCHITECT, LANDSCAPE ARCHITECT OR LAND
SURVEYOR TO ALTER AN ITEM IN ANY WAY. IF AN ITEM BEARING THE
STAMP OF A LICENSED PROFESSIONAL IS ALTERED, THE ALTERING
ENGINEER, ARCHITECT, LANDSCAPE ARCHITECT OR LAND
SURVEYOR SHALL STAMP THE DOCUMENT AND INCLUDE THE
NOTATION "ALTERED BY" FOLLOWED BY THEIR SIGNATURE, THE
DATE OF SUCH ALTERATION, AND A SPECIFIC DESCRIPTION
OF THE ALTERATION.

WESTERN VIRGINIA
WATER AUTHORITY
PETERS CREEK ROAD
SANITARY SEWER
REPLACEMENT

| No. | Submittal / Revision | App'd. By | Date |
|-----|-----------------------|-----------|----------|
| 1 | ADDENDUM 2 | DBH | 06/27/18 |
| 2 | CONSTRUCTION ISSUE | DBH | 10/30/18 |
| | | | |
| | | | |
| | | | |
| | | | |

TITLE SHEET

| | | |
|-------------------------|----------------------|--------------------|
| Designed By: SCF | Drawn By: RAS | Checked By: DBH |
| Issue Date: 03-01-18 | Project No: 31237 | Scale: AS NOTED |

Drawing No.:
G-001