
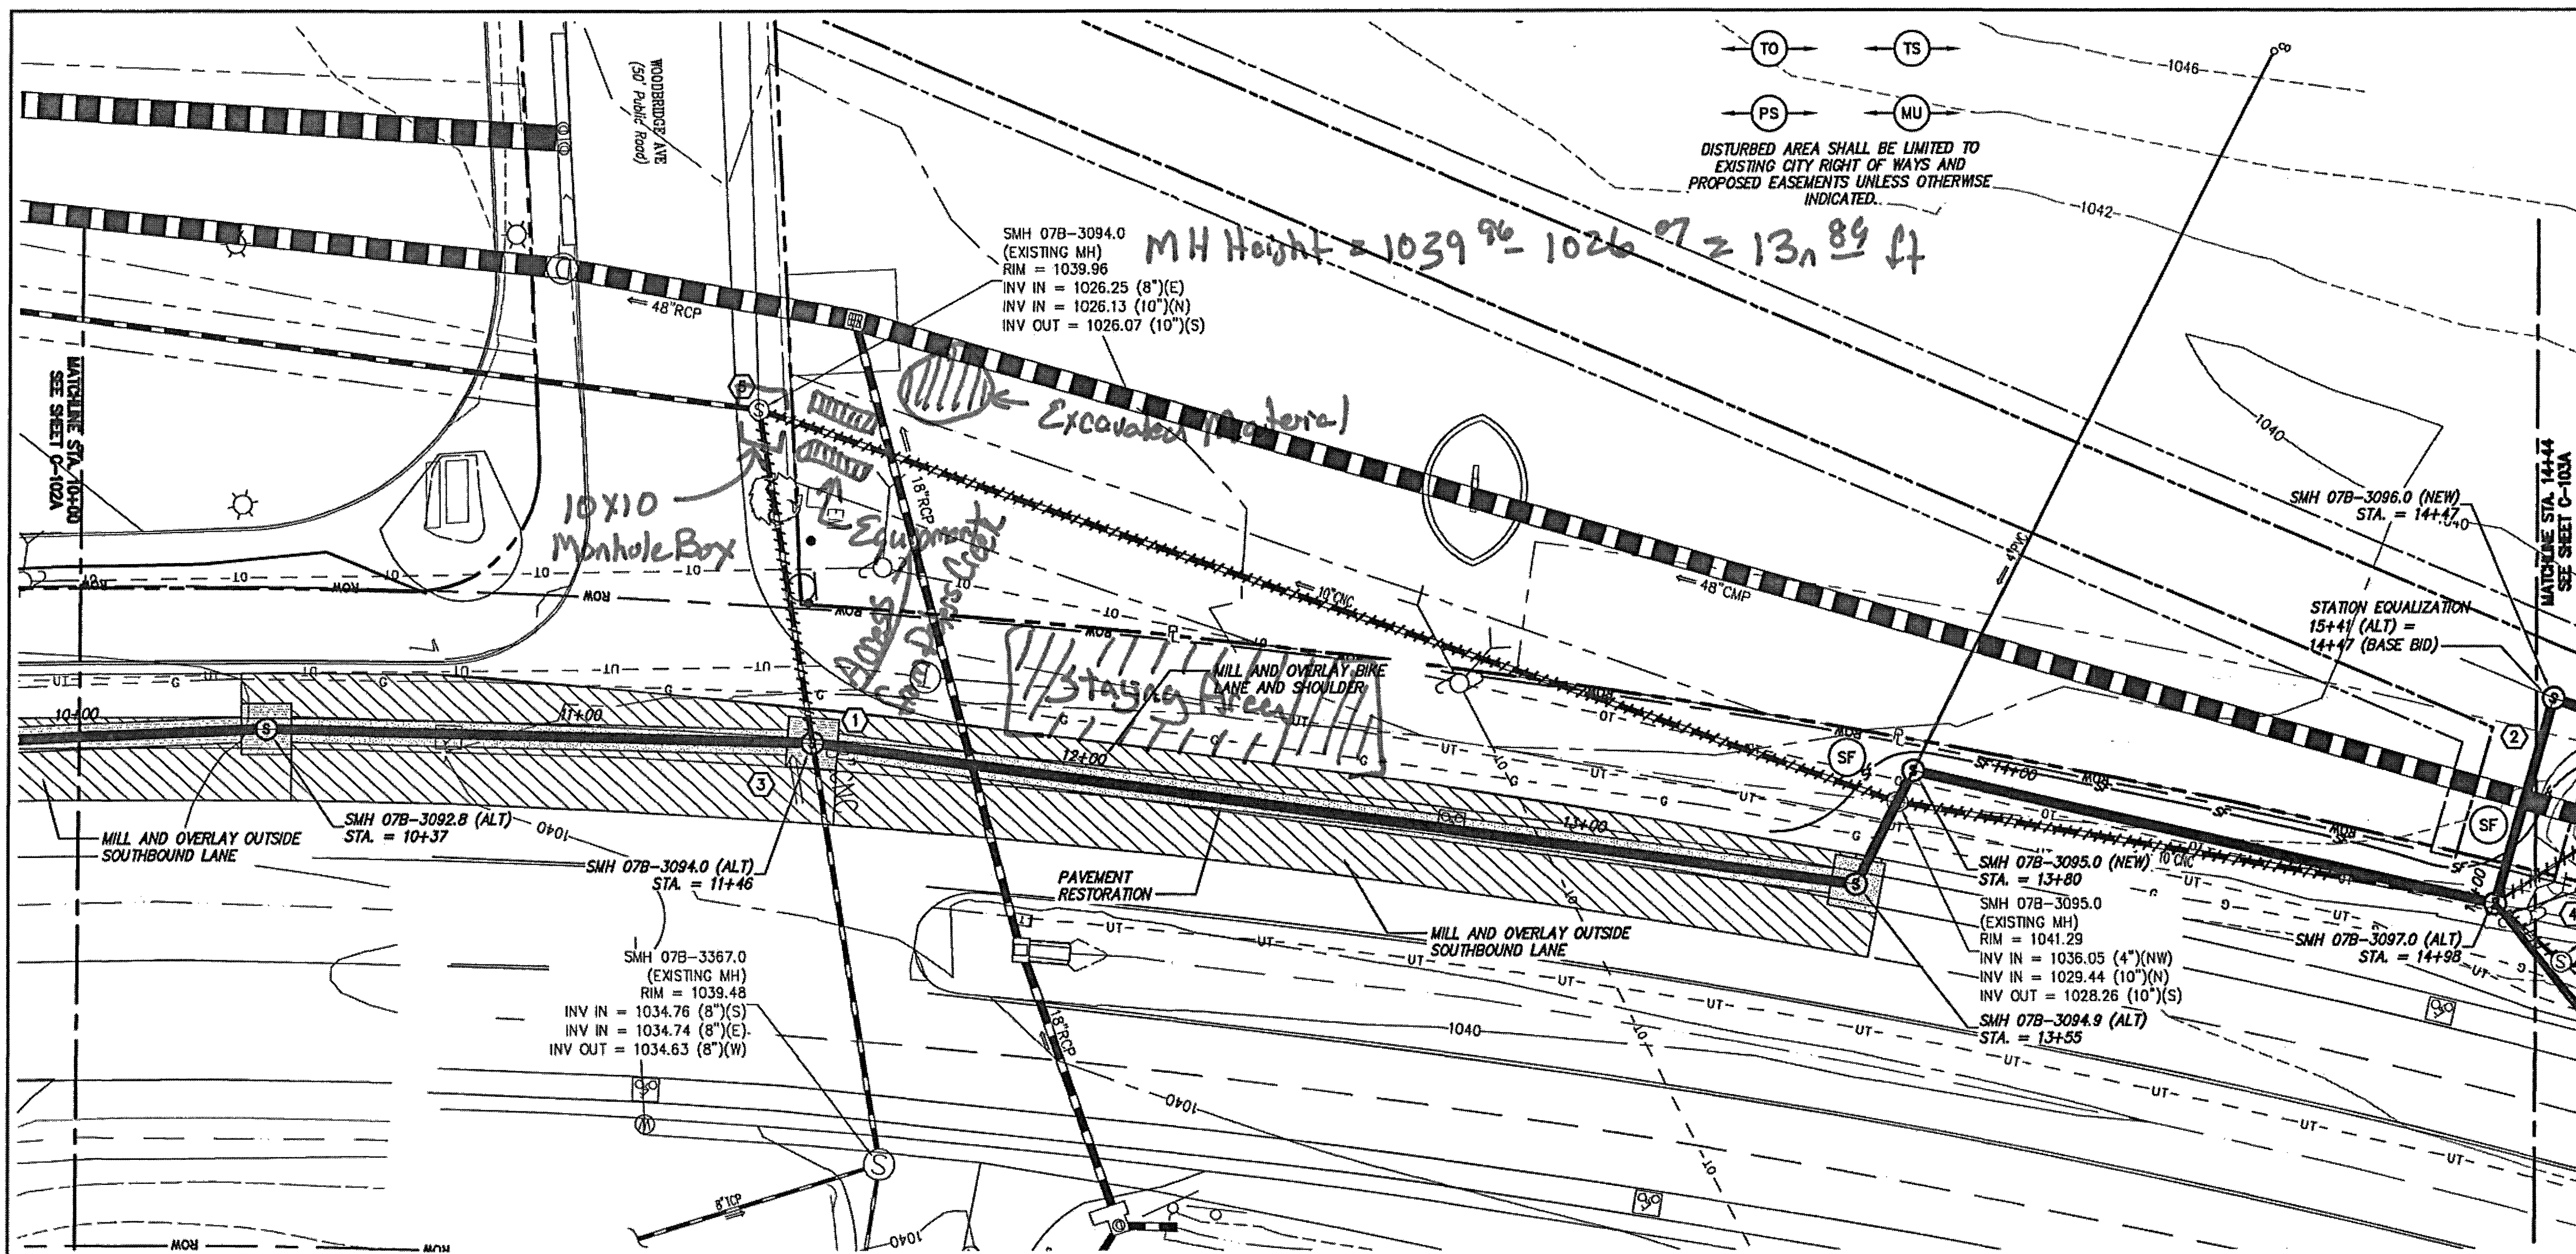
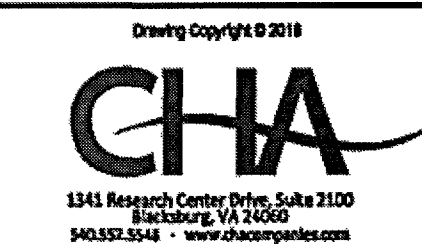


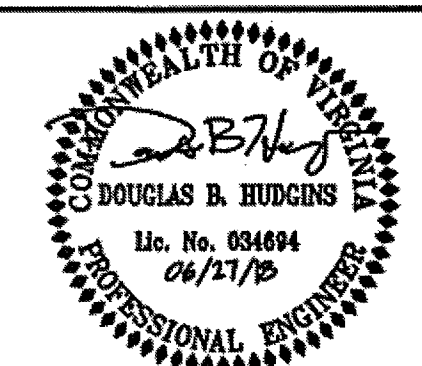


- SPECIFIC NOTES:**

WESTERN VIRGINIA
WATER AUTHORITY

IT IS A VIOLATION OF LAW FOR ANY PERSON, UNLESS THEY ARE ACTING UNDER THE DIRECTION OF A LICENSED PROFESSIONAL ENGINEER, ARCHITECT, LANDSCAPE ARCHITECT OR LAND SURVEYOR TO ALTER AN ITEM IN ANY WAY, IF AN ITEM BEARING THE STAMP OF A LICENSED PROFESSIONAL IS ALTERED. THE ALTERING ENGINEER, ARCHITECT, LANDSCAPE ARCHITECT OR LAND SURVEYOR SHALL STAMP THE DOCUMENT AND INCLUDE THE NOTATION "ALTERED BY" FOLLOWED BY THEIR SIGNATURE, THE DATE OF SUCH ALTERATION, AND A SPECIFIC DESCRIPTION OF THE ALTERATION.

WESTERN VIRGINIA
WATER AUTHORITY
PETERS CREEK ROAD
SANITARY SEWER
REPLACEMENT

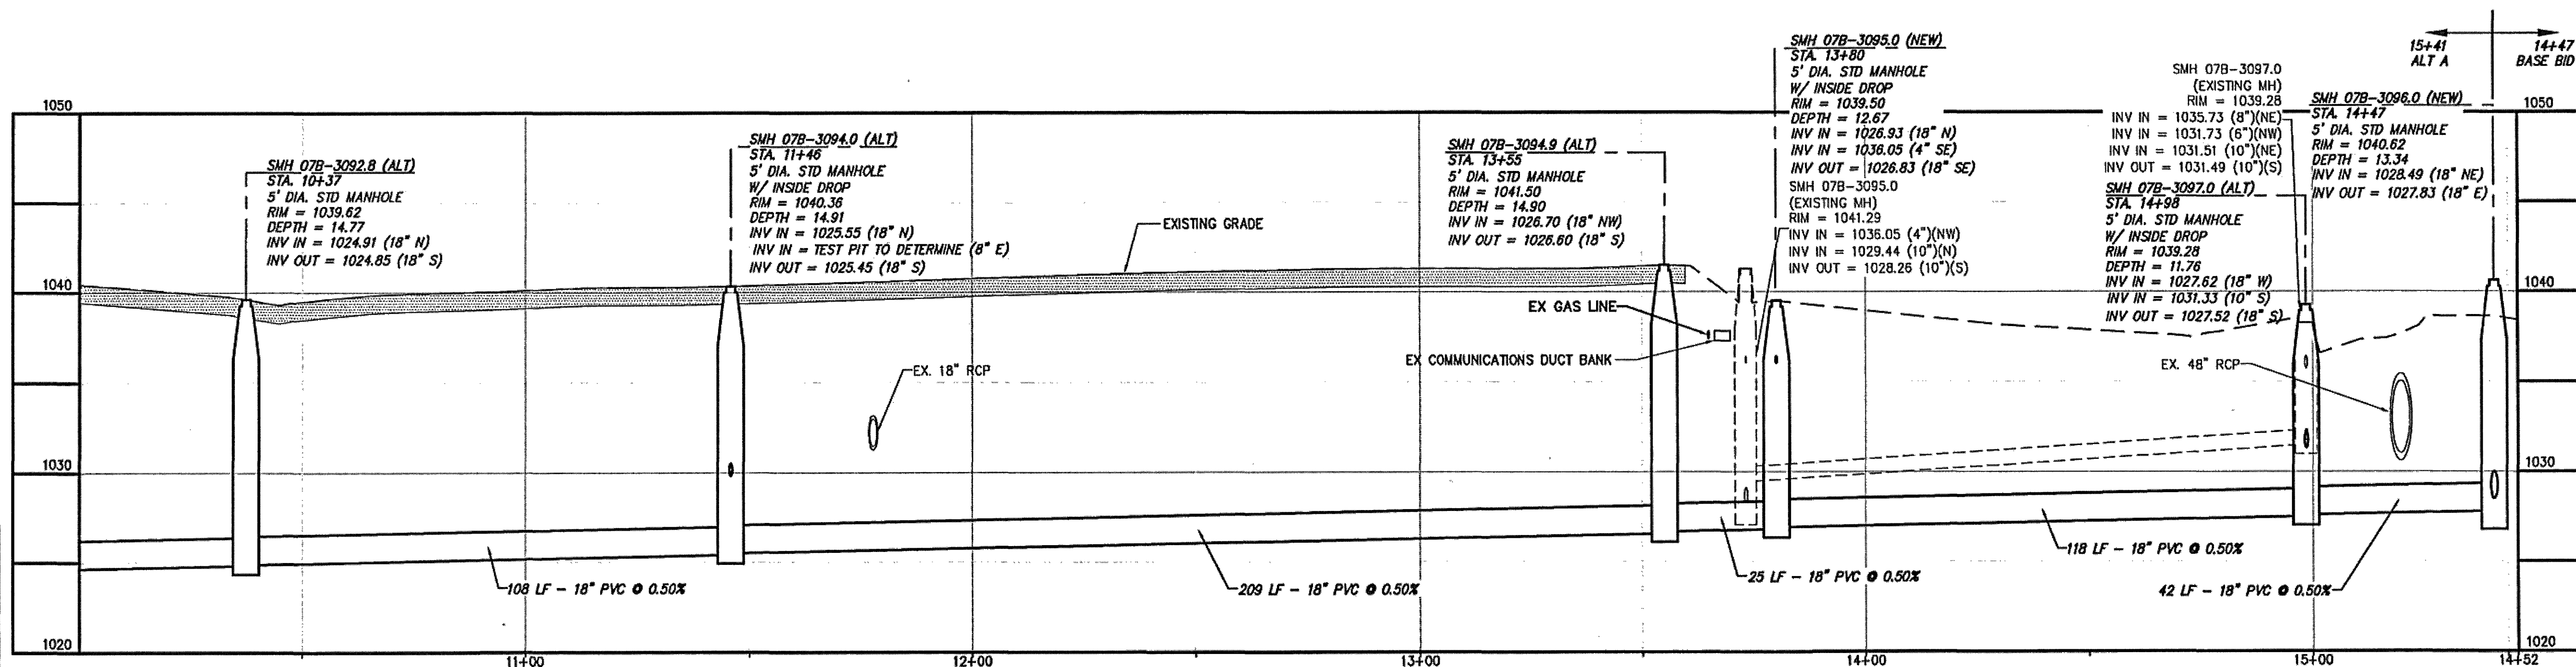

No.	Submittal / Revision	App'd.	By	Date
1	ADDENDUM 2		DBH	06/27/18
2	CONSTRUCTION ISSUE		DBH	10/30/18

PETERS CREEK
ROAD - PLAN &
PROFILE
ALTERNATE A ALIGNMENT

Designed By: SCF	Drawn By: RAS	Checked By: DBH
Issue Date: 03-01-18	Project No: 31237	Scale: AS SHOWN

Drawing No.:
C-103A